

WAKELY ASSOCIATES, INC.  
ARCHITECTS  
30500 Van Dyke Avenue Suite M7  
Warren, Michigan 48093

ADDENDUM NO. ONE  
GREATER HEIGHTS ACADEMY –  
FOUR CLASSROOM ADDITION  
Page 1 of 1 (write up only)

April 22, 2015

ADDENDUM NO. ONE to the plans and specifications for the GREATER HEIGHTS ACADEMY – FOUR CLASSROOM ADDITION, Flint, MI, Architect's Project No. 141601, dated March 31, 2015.

The above plans and specifications are modified, supplemented or augmented as follows, and this ADDENDUM NO. ONE, is hereby made a part of the contract documents.

**Drawings C1.0, C2.0, C3.0, C4.0, C5.0, C6.0 and S1.1 are being issued with this Addendum.**

**Sketches A01-SK-1, A01-SK-2, A01-SK-3, A01-SK-4, A01-AK-5, A01-SK-6 and A01-SK-7 are being issued with this Addendum.**

### **SPECIFICATIONS**

**ITEM NO. S1** Added Specification Section 12300 – Plastic Laminate Casework.

**ITEM NO. S2** Added HangSafe Racks Coat Rack System Specification Section.

### **CIVIL**

**ITEM NO. C1** Refer to Drawing C1.0 (issued). Updated interstate name in the location map.

**ITEM NO. C2** Refer to Drawing C2.0 (issued).  
1. Added reference to drawing C4.0 for water main removal limits note.  
2. Updated removal limits at the south east corner of the parking area.  
3. Updated striping removal at the handicap parking entrance.

**ITEM NO. C3** Refer to Drawing C3.0 (issued).  
1. Updated notes to reference details on sheet C5.0.  
2. Updated parking configuration at the rear entrance and front handicap accessible parking.  
3. Added maneuvering space at the southeast corner of the parking lot.

**ITEM NO. C4**

Refer to Drawing C4.0 (issued).

1. Added notes at the existing catch basins in the rear parking area.
2. Added notes at the existing catch basins in the rear parking area.
3. Revised spot elevation at the west limits of the rear parking area.
4. Revised curb/ramps and grades at the rear entrance/loading dock area.
5. Revised notes to bulkhead vacated storm sewer.
6. Revised pipe slopes and inverts.
7. Revised spot grade at the south east corner of the proposed walk.
8. Revised Grading, General Utility, and Material Notes.

**ITEM NO. C5**

Refer to Drawing C5.0 (issued).

1. Updated name of the Concrete Collar detail.
2. Removed Ramp Detail from sheet.
3. Removed trench detail from the plan, drawing C4.0 references the appropriate MDOT detail.
4. Added beehive grate to catch basin detail.
5. Updated expansion joint filler thickness.
6. Updated maximum and minimum slopes for concrete walk detail.

**ITEM NO. C6**

Refer to Drawing C6.0 (issued).

1. No changes, included in set for completeness.

**ARCHITECTURAL****ITEM NO. A1**

Refer to Drawing S1.1 (issued), Sketch A01-SK-4 and Sketch A01-SK-5 (issued).

1. Partial Roof Framing Plan: Added W8x10 steel beam in Corridor 150, at top of wall between Intervention 152 and Classroom 153 and Classroom 155 and Classroom 156.
2. Partial Roof Framing Plan, Note 5: Added joist chord radius of 458'-7 1/4".
3. Partial Roof Framing Plan: Added CMU lintel at east wall, east of Door 154, per detail on Sketch A01-SK-5.
4. Partial Roof Framing Plan: Added CMU bond beam per Detail on Sketch A01-SK-4.
5. Partial Roof Framing Plan: Revised deck span at outriggers to match rest of deck span on curved roof.

**ITEM NO. A2**

Refer to Drawing S1.2 (not reissued).

6. Added stoop to south portion of foundation, at location of Door 156A. Stoop size to match stoop dimensions at Door 152A.

- ITEM NO. A3** Refer to Drawing A1.1 (not reissued), Drawing A6.1 (not reissued) and Sketch A01-SK-1 (issued).
1. Added detail showing upper cabinets, cubbies and coat rack system, per drawing on Sketch A01-SK-1.
- ITEM NO. A4** Refer to Drawing A2.1 (not reissued) and Sketch A01-SK-2 (issued).
1. Added details showing steel cages around new roof top units, per drawings on Sketch A01-SK-2.
- ITEM NO. A5** Refer to Drawing A4.2 (not reissued) and Sketch A01-SK-3 (issued).
1. Added typical eave detail for North and South wall overhang eave condition, per drawing on Sketch A01-SK-3.
- ITEM NO. A6** Refer to Drawing A4.1 (not reissued), Sketch A01-SK-4 (issued), Sketch A01-SK-6 (issued), Sketch A01-SK-7 (issued) and Sketch A01-SK-8 (issued).
1. Wall Section 1: Added typical eave detail for East wall overhang eave condition, per drawing on Sketch A01-SK-4.
  2. Wall Section 1: Revised CMU bond beam and steel lintel, at top of wall, per drawing on Sketch A01-SK-8.
  3. Wall Section 4: Added 8" cmu bond beam at top of wall, per drawing on Sketch A01-SK-6.
  4. Wall Section 2: Added 8" cmu bond beam at top of wall, per drawing on Sketch A01-SK-7.

## **END OF ADDENDUM NO. 1**

Cc: Lisa Leimeister, Greater Heights Academy  
Mary Mitchell, Greater Heights Academy  
Jenn Melton, Greater Heights Academy  
Nick Zilz, Greater Heights Academy  
Rebecca Seacrest, CSDC  
Steve Mrak, PBA  
Scott Peck, PBA  
Kevin Zael, AEW  
Juli Sala, AEW  
File

SECTION 12300 - PLASTIC LAMINATE CASEWORK

PART 1 - GENERAL

1.01 General Provisions

- A. Attention is directed to Division 0, Bidding and Contract Requirements and to Division 1 General Requirements which are hereby made a part of this Specification. Refer to other sections, divisions, and schedules for work in connection with this section.

1.02 Intent

- A. The intent of this specification is to establish minimum performance and quality criteria consistent with preestablished standards of design and function. Casework not meeting these minimum requirements will be unacceptable.
- B. The casework contractor shall be held in strict compliance with any specific materials, finishes, construction details and hardware that are specified herein. Bids proposing to supply casework not meeting these requirements will be rejected.

1.03 Work Included

- A. Furnish, deliver, and install to Owner's and Architect's satisfaction, all prefabricated plastic laminate casework as shown on drawings, schedules and equipment lists.
- B. Furnish and install all fillers, scribes, finished ends, finished backs, work surfaces/backsplashes, and cutouts required to provide a complete and finished project. Plastic laminate work surfaces shall include backer sheet.
- C. Provide sinks and fittings, electrical outlets and fixtures when specifically stated as being part of this contract.
- D. Provide locks on all cabinets & drawers capable of locking unless noted otherwise. All cabinets are to be keyed alike per room. All locks are to be masterkeyable to room doors.
- E. Installation, connection, and testing of all sinks, fittings, electrical fixtures; providing all rough-ins: mechanical piping, electrical runs, and connections required for a complete project.
- F. Blocking, framing, and reinforcement in walls, ceilings,

and floors for anchoring of cabinets and trim.

#### 1.05 QUALIFICATIONS

- A. Plastic laminate casework shall be as manufactured by Stevens Cabinet Co. Division of Stevens Industries Inc., Teutopolis, Illinois. Products and catalog numbers are from Stevens catalog and are used as basis for identification, configuration, size and quality.
- B. Other pre-approved manufacturers are as follows:
  - TMI System Design Corp. Dickinson, North Dakota
  - Case Systems Inc., Midland, Michigan
  - LSI Corporation of America, Inc., Minneapolis, Minnesota
  - Wood Metal Industries, Selinsgrove, Pennsylvania
  - Strata Design, Inc., Traverse City, Michigan
- C. Casework of other manufacturers will be considered for approval providing written request is received at least ten (10) days prior to announced bid date and approved by addendum. Bidder shall state in writing any deviations from requirements and specifications. The casework shall conform to configuration, arrangement, design, material quality, joinery, panel thickness, and surfacing of that specified and shown on drawings.
- D. Manufacturers requesting approval shall submit samples with Cut-A-Ways showing cabinet construction, joinery, drawer and door construction, hardware, and materials; along with catalogs and specification in order that accurate evaluations can be made. Samples may be impounded for the duration of contract to insure construction specification compliance.

#### 1.06 SUBMITTALS

- A. Shop drawings shall be submitted for approval within thirty (30) days after formal notification of award of contract. Drawings shall consist of floor plans indicating arrangement and relation to electrical, data technology and adjacent work and equipment, and complete elevations of casework. Centerline of service requirements shall be noted for use by other trades. A schedule of all sinks, fittings, and accessories that are part of this contract shall be provided.
- B. Color samples shall be submitted for selection and coordination at time of contract award. Samples of actual material and color shall be available as required.

- C. Additional catalog cuts, details and samples as requested by Architect for evaluation and coordination.
- D. Physical sample must be approved prior to fabrication.

1.07 PRODUCT DELIVERY AND STORAGE

- A. Protect cabinet and countertops during transit, delivery, storage and handling to prevent damage, soiling and deterioration.
- B. Store cabinets and countertops at project site installation and storage areas with similar ambient conditions as final installation. Storage areas must be kept dry, heated with low relative humidity and away from construction work such as painting, wet work, grinding and similar operations.

1.08 WARRANTY

- A. Casework manufacturer shall provide lifetime guarantee and limited warranty to the original Owner against defective material and fabrication for as long as they own the product - this is a warranty of replacement and repair only, the manufacturer will correct defects in material and/or fabrication without additional cost.
- B. Accessory equipment (sinks, fittings etc.) shall be warranted by appropriate manufacturer's guarantee.

PART 2 - PRODUCTS

2.01 CORE MATERIAL

- A. Cabinet components having particle board core material shall be of a minimum 45 lb. density, M-2 industrial grade. The particle board used shall have been tested under ANSI A208.1 1993 standards and/or ASTM D 1037-91A.
- B. Medium density fiberboard (MDF) shall be used in high stress areas as drawer members and shall be minimum 48 lb. density MD-21 grade and tested under ANSI A208.2 1994 Standards.
- C. Industrial hardboard shall be pre-finished 1/4" thickness composed of wood fibers, phenolic resin binders and moisture inhibitors that meet or exceed the hardboard product standard ANSI/AHA A135.4 1988.
- D. All countertops located with 3'-0" of any direction of

built-in sink and/or bubblers shall be constructed of marine grade "Greenboard" MR moisture/water resistant particle board. The particle board shall be tested under ANSI A208.1 1-1993, M3 standards.

2.02 SURFACE MATERIAL

- A. Exposed exteriors shall be permanently thermofused melamine laminate, fused to core using a minimum average pressure of 320 PSI and average 320 degree F. temperature. Thermofused melamine laminate shall meet ALA 1996 specification standards, as tested against the high pressure laminate NEMA LD 3-1995, VGS.028 specification standards. (Warranted for life against delamination).
- B. Exposed doors and drawer fronts shall be permanently thermofused melamine laminate, fused to core using a minimum average pressure of 320 PSI and average 320 degree F. temperature. Thermofused melamine laminate shall meet ALA 1996 specification standards, as tested against the high pressure laminate NEMA LD 3-1995, VGS.028 specification standards, (Warranted for life against delamination).
- C. Exposed interiors shall be permanently thermofused melamine laminate, fused to core using a minimum average pressure of 320 PSI and average 320 degree F. temperature. Thermofused melamine laminate shall meet ALA 1996 specification standards, as tested against the high pressure laminate NEMA LD 3-1995, VGS.028 specification standards. (Warranted for life against delamination).
- D. Semi-exposed and concealed surfaces shall be permanently thermofused melamine laminate or high pressure decorative plastic laminate cabinet liner, 0.020" thickness for balanced construction. Thermofused melamine laminate shall meet the ALA 1996 specifications standard, as tested against the high pressure laminate NEMA LD 3-1995, VGS.028 specification standards.

2.03 EDGINGS

- A. Exposed exterior cabinet front edges shall be banded with a contrasting or matching rigid PVC extrusion, 0.020" thickness, resistant to chip, crack and high impact. Edging shall have a satin finish with a UV cured top coat for additional durability. The 0.020" thick edging shall be applied with waterproof hot melt adhesive.
- B. Door and drawer front edges shall be banded with a

contrasting or matching rigid PVC extrusion, 3mm (1/8") thickness, resistant to chip, crack, and high impact. Edging shall have a satin finish with UV cured top coat for additional durability. The 3mm thick edging shall be applied with waterproof hot melt adhesive, and shaped to provide radiused edges and radiused corners.

- C. Adjustable shelves shall be banded with PVC extrusion, resistant to chip, crack, and high impact. Edging shall have a satin finish with a UV cured top coat for additional durability. Edging shall be applied with waterproof hot melt adhesive. Shelves to be 1" thick. 0.020" thick PVC edging shall be applied to four (4) edges of adjustable shelf.
- D. All other interior components, including drawers, shall be banded with a PVC extrusion, 0.020" in thickness, resistant to chip, crack, and high impact. Edging shall have a satin finish with a UV cured top coat for additional durability. Edging to be machine applied with waterproof hot melt adhesive.

#### 2.04 COLOR SELECTIONS

- A. Exposed cabinet exteriors shall be chosen from Thermofused melamine laminate selections as depicted in manufacturer's color selector guide. A minimum of seventy (70) colors and patterns shall be available as standard selection.
- B. Exposed doors and drawer fronts shall be chosen from Thermofused melamine laminate selections as depicted in manufacturer's color selector guide. A minimum of seventy (70) colors and patterns shall be available as standard selection.
- C. Semi-exposed surfaces, including drawer box components, shall be finished in either pearl or grey as selected from casework manufacturer's standard interior color selections.
- D. Exposed interior components, including both faces of shelves and interior face of backs to match exposed cabinet exterior color selection.
- E. Door and drawer front edges shall be chosen from one of twenty-two (22) trim group colors in 3mm thick PVC in contrasting or matching colors as depicted in manufacturer's color guide.
- F. Exposed front edge of cabinet, including exposed interior edges, shall be selected from one of seventy (70) trim



group colors in 0.020" thick PVC in contrasting or matching colors as depicted in manufacturer's color guide, or commercial match to selected exposed exterior color based on availability.

- G. Semi-exposed edges of cabinet components including drawers, shall be either pearl or grey n 0.020" thick PVC.
- H. Pulls shall be available in chrome, brass, bent wire and injection molded pulls in either bent wire or contour design, to be available in twenty (20) colors as selected from manufacturer's color selector.
- I. Casework of substitute brands with lesser amounts or more restrictive selection requirements will not be considered equal and shall be rejected.
- J. Finishes to be laminate manufacturer's matte, suede, or equivalent finish as approved by Architect. Samples will be reviewed by Architect for color, texture, and pattern only.

2.05 HARDWARE

A. Hinges

1. Institutional five-knuckle secured with minimum of eight screws. Hinge plate must extend into cabinet a minimum of 2 1/4" (56 mm) in order to assure maximum strength. Finish to be powder-coated baked on black enamel or brushed chrome US26D.

- a. Two hinges used on all doors less than 48" (1220 mm) in height, three hinges used on all doors 48" (1220 mm) or greater in height. Hinge to accommodate 13/16" (21 mm) door.

- B. Door catches shall be a heavy-duty spring loaded, large diameter (17.5mm - 11/16") roller type catch mounted at bottom edge. All doors over 48" in height shall be provided with roller catch at both top and bottom of door.
- C. Catch strike plate shall be injection molded ABS, with an integrally molded engagement ridge. Strike plate shall also provide a wide face bumper insuring a positive door stop.
- D. Pulls shall be impact resistant injection molded bent wire,

4" length available per color selection in Article 2.04.H.

- E. Drawer and slide out shelves shall be suspended with bottom mount, side and bottom attached nylon roller epoxy coated steel slides to ensure quiet, smooth operation. Lateral stability is achieved thru a special formed captive profile. Slides shall have 100 lb. load rating, with both in and out drawer stop, 3" self close feature and a side adjustment cam allowing 3mm side to side alignment.
- F. Drawers specifically noted for full extension file use shall be suspended with bottom mount, side and bottom attached nylon roller epoxy coated steel slides to ensure quiet, smooth operation. Lateral stability is achieved thru a special formed captive profile. Slides shall have 150 lb. load rating, with both in and out drawer stop, and 3" self close feature. File drawer shall include extruded top mounted molded side rails to accept standard hanging file folders.
- G. Knee-space, pencil drawers, and keyboard trays, shall be designed to permit under counter or support frame mounting, with 100 lb. nylon roller epoxy coated steel slides.
- H. Hanger rods shall be heavy chrome plated tubing. Rod shall be securely affixed to cabinet shelves.
- I. Tote trays shall be of high impact polystyrene with smooth edges. Each tray to include an identification card holder and shall be suspended from rails securely attached to cabinet verticals.
- J. Shelf support clips for 1" thick adjustable shelves shall be injection molded clear polycarbonate. Support clips shall incorporate integral molded lock tabs to retain shelf from topping or inadvertently being lifted out. Support clip shall have 5mm dia. double pin engagement into precision bored hole pattern in cabinet vertical members. Clips shall have a molded ridge which provide pressure against edge of shelving to maintain positive pin engagement. Clip shall be designed in such a manner to provide means for permanent retention to shelf. Static test load must exceed 200lb. per clip.
- K. Dividers that are 1/4" thick shall be fully adjustable and retained with injection molded clear polycarbonate clip.
- L. Locks shall be cylinder type, diecast, with five (5) disc tumbler mechanism. Each lock shall be provided with milled brass key. Master key cabinets to room doors. Cabinets

with multiple locks installed shall be keyed alike by room, with each cabinet in that room keyed the same unless otherwise specified. Locks shall be Remov-A-Core to give flexibility for different pass key options. Locks shall be provided on all cabinets capable of locking.

- M. Sliding door track shall be double channel rigid PVC extrusion at both top and bottom of doors. Track shall be available in pearl, black or grey colors.
- N. Teacher wardrobe mirrors shall be 7/32" (6mm) thick polished plate mirror.

## 2.06 COMPONENTS

- A. Base, wall and tall cabinet ends shall be 3/4" thick particle board, laminated for balanced construction, surfaced as described in Article 2.02.A and edged as described in Article 2.03.A.
- B. Base and tall cabinet tops and bottoms shall be 3/4" thick particle board, laminated for balanced construction, surfaced as described in Article 2.02.C, and edged as described in Article 2.03.A.
- C. Wall cabinet top and bottom shall be 1" thick particle board, laminated for balanced construction, surfaced as described in Article 2.02.C, and edged as described in Article 2.03.A.
- D. Vertical cabinet members shall be 3/4" thick particle board, laminated for balanced construction, surfaced as described in Article 2.02.C, and edged as described in Article 2.03D.
- E. Cabinet backs shall be 1/4" thick pre-finished industrial hardboard.
- F. Frame rails shall be 3/4" thick x 3 3/4" wide particle board, laminated for balanced construction, surfaced as described in Article 2.02.C, and edged as described in Article 2.03.A.
- G. Sub base shall consist of two (2) toe kick support rails shall be 3/4" thick x 3 3/4" high particle board and be inset from cabinet front and back edge, to give additional load support.
- H. Mounting rails shall be 3/4" thick x 3 3/4" wide particle board. Wall cabinets shall have rails positioned at the

top and bottom. Tall cabinets shall have rails positioned at the top and intermediate location. Base cabinet shall have rails positioned at the top of unit.

- I. Drawers shall be full box design with a separate front. Drawer sides and ends shall be constructed of 5/8" medium density fiberboard with pearl or grey color thermofused melamine laminate and matching PVC top edges. Bottoms shall be 1/4" thick medium density fiberboard, pearl or grey color thermofused melamine laminate.
- J. Adjustable shelves shall be 1" thick. Edges of shelf shall be banded as described in Article 2.03.C with a high impact, rigid PVC extrusion, pearl or grey in color.
- K. Sliding display doors shall be constructed of 1/4" thick distortion free glazing sheet. Center edge shall be capped with full length aluminum channel. Aluminum channel shall be custom extruded, clear etched and anodized. Full length extruded aluminum channel shall be used on other edges.
- L. Solid hinged doors, sliding doors and drawer fronts shall be 3/4" thick material of balanced construction, surfaced as described in Section 2.02.B, edged as described in Article 2.03.B.

## 2.07 CONSTRUCTION

- A. Cabinet parts shall be accurately machined and precision bored for premium grade quality joinery construction, utilizing automatic machinery to ensure consistent sizing on modular cabinets. Cabinets shall be assembled under controlled case clamp conditions, assuring final cabinet squareness and proper joint compressions.
- B. Cabinet ends shall be bored to receive 8mm, industrial grade hardwood laterally fluted dowels with chamfered ends. Cabinet ends shall be prepared to receive adjustable shelf hardware at 32mm (approximately 1 1/4") centers. Door hinges and drawer slides shall be machined drilled to maintain vertical and horizontal alignment of components. Inset grooving with chamfer shall be machined 3/4" from rear edge to accept the 1/4" back. Base and tall units shall have one piece end panels continuous to floor for added load capabilities.
- C. Tops and bottoms shall be joined to cabinet ends using a minimum of six (6) dowels at each joint for twenty-four (24) inch deep cabinets and a minimum of four (4) dowels at each joint, for twelve (12) inch deep cabinets. All dowels

to be industrial grade hardwood, laterally fluted, with chamfered ends and 8mm in diameter. Top of base cabinet will be full depth. Inset grooving with chamfer shall be machined 3/4" from rear edge to accept the 1/4" back.

- D. Vertical dividers shall be bored to receive adjustable shelf hardware at 32 mm (approximately 1 1/4") centers. Dividers shall be joined to tops and bottoms with 8mm diameter hardwood dowels.
- E. Frame rails shall be joined to ends with 8mm diameter hardwood dowels.
- F. Two (2) toe kick supports shall be inset from cabinet front and back edges, and doweled into cabinet ends with 8mm hardwood dowels.
- G. Mounting rails shall be fully concealed behind backs. Rails shall be 3/4" thick and fastened to cabinet ends with 8mm hardwood dowels. Wall and tall cabinet shall incorporate two mounting rails. Wall cabinets shall have rails positioned at top and bottom. Tall cabinets shall have rails positioned at top and intermediate location. Base units shall have rail positioned in the upper back area.
- H. Back panels shall be 1/4" thick and inset 3/4" from rear edge of cabinet. Back shall be glued and continuously trapped in top, bottom and ends of cabinets.
- I. Drawer corner joints shall be interlocking dowel pin design. Hardwood dowel pins, 8mm diameter shall be inserted into drawer fronts and backs to fit into machined hole patterns in drawer sides. Bottoms shall be trapped into grooves on all four sides glued and mechanical fastened. Drawers shall be suspended on slides as described in Article 2.05.E.

## 2.08 WORK SURFACES

- A. Core material having particle board shall be of a minimum 45 lb. density, M-2 industrial grade. The particle board used shall have been tested under ANSI A208.1 1993 standards and/or ASTM D 1037-91A.
- B. Surface material shall be high pressure decorative plastic laminate thermoset to core using catalyzed PVA glue with a minimum average pressure of 90 PSI and average 180 degree F temperature. High pressure decorative plastic laminate shall meet NEMA LD 3-1995, HGP.039 specification standards.

- C. Color selection shall be high pressure decorative plastic laminate selections as depicted in manufacturer's color selector guide. A minimum of seventy (70) colors and patterns shall be available as standard selection.
- D. Exposed edges shall be high 180 degree roll-edge unless noted otherwise on drawings.
- E. Underside of all work surfaces to have BK-20 backer or approved equivalent. This balance sheet shall be thermoset to core using catalyzed PVA glue with a minimum average pressure of 90 PSI and average 180 degree F. temperature.
- F. Counter Tops - Plastic Laminate
  - 1. Deck shall consist of two layers of 3/4" (19 mm) particle board at the front edge and all other exposed edges providing a total thickness of 1 1/2" (40 mm). Solid patterns or wood grain colors of FORMICA or WILSONART brand high-pressure plastic laminate may be selected for the surfaces. The method of application of the laminate to the substrate shall be as recommended by the Decorative Plastic Laminate Association.
  - 2. Attached back splashes will have 1/4" (6 mm) of scribe on them to allow for normal field variances. Loose back splashes will not have scribe.

2.09 GLASS

- A. Wall unit full sliding glass doors: 1/4 inch laminated safety glass.
- B. Glass insert doors, hinged or sliding wall cabinets: 1/4 inch laminated safety glass.
- C. Glass insert doors, hinged or sliding tall or base cabinets. 1/4 inch laminate safety glass.
- D. Sliding doors mounted in aluminum track.
- E. Trim glass inserts: Extruded rigid PVC.

2.10 COLOR SELECTION

- A. Laminate Color Selection:
  - 1. Select from the full range of Wilsonart®, Nevamar®,

Pionite®, Arborite® and Formica® stock color charts for cabinet faces, exposed ends, open interiors and countertops.

- B. Hinge and Pull Color Selection:
  - 1. Select from full range of stock and custom colors to coordinate/match: Wilsonart®, Nevamar®, Pionite®, Arborite® and Formica®.
- C. Miscellaneous Hardware Color Selection (support brackets, table frames, rail):
  - 1. Select from full range of stock and custom colors to coordinate/match: Wilsonart®, Nevamar®, Pionite®, and Formica®.
- D. 3mm PVC Edge Banding Color Selection:
  - 1. Select from full range of stock and custom colors to coordinate/match: Wilsonart®, Nevamar®, Pionite®, and Formica®.

### PART 3 - EXECUTION

#### 3.01 INSTALLATION

- A. The Installer must examine the job site and the conditions under which the work in this section is to be performed, and notify the Construction Manager in writing of any unsatisfactory conditions. Do not proceed with work under this section until unsatisfactory conditions have been corrected in a manner acceptable to the installer.
- B. Casework, countertops, and related materials to be conditioned to average prevailing humidity condition in installation areas prior to start of work.
- C. Install casework and countertops with factory-trained supervision authorized by manufacturer. Casework shall be installed plumb, level, true and straight with no distortions. (Shim as required). Securely attached to building structure with anchorage devices of appropriate type, size and quantity to meet applicable codes, specifications and safety conditions. Where laminate clad casework and countertops abuts other finished work, scribe and trim to accurate fit.
- D. Adjust casework and hardware so that doors and drawers operate smoothly without warp or bind. Lubricate operating hardware as recommended by the manufacturer.

- E. Repair, or remove and replace, defective work as directed upon completion of installation.
- F. Clean plastic surfaces, repair minor damage per plastic laminate manufacturer's recommendations. Replace other damaged parts of units.
- G. Advise Construction Manager of procedures and precautions for protection of casework and countertops from damage by other trades until acceptance of work by Owner.
- H. Cover casework with 4-mil polyethylene film for protection against soiling and deterioration during remainder of construction period.

END OF SECTION 12300



WALL MOUNTED "HangSafe Racks" COAT RACK SYSTEM -  
POLYCARBONATE PLASTIC HOOKS MOUNTED ON SOLID OAK

PART 1 - GENERAL

- A. DESCRIPTION: Furnish and install wall mounted solid oak and polycarbonate plastic coat rack system.
- B. RELATED WORK:
  - a. CMU / brick / concrete wall: Blocking not required

PART 2 - PRODUCT

- A. Manufacturer: HangSafe Hooks - 165 E. Hwy CC - Nixa, MO - 417-725-8900 or 1-888-803-7403, sales@hangsafehooks.com - [www.hangsafehooks.com](http://www.hangsafehooks.com). - Sole source vendor
- B. Materials:
  - 1. Hooks: polycarbonate plastic (rounded ends, eased edges, polished), mounted w/ #14 x 2" stainless steel Philips oval head screws & finishing washers.
  - 2. Mounting Board: solid oak wood (1 9/16" ± x 3 1/2" ±) finished w/ (1) - stain per customer's requirements. (2) - polyurethane clear coat(s). Or other specified material(s).
- A. Ordering:
  - 1. Standard lengths of racks are mixed & matched, to achieve the desired length and/or number of hooks. Standard hook spacings are 5 1/3", 6.4", 8", and 10 2/3".
  - 2. Available options: Weather Treatment, Individual Hook Numbering.
  - 3. Shop drawings will be provided to communicate exact configurations including stud spacing to mounting hole coordination, and finish treatments.

PART 3 - EXECUTION


INSTALLATION

- A. Locate solid webs in CMU's or brick, or studs in framed walls.
- B. Install racks level, with mounting screws or mounting system (provided per the wall type) and 1/4" flat washers in the 3/4" diameter mounting pockets. Tighten screws/bolts to eliminate all movement in rack system.
- C. Glue oak wood finishing button in mounting pocket.

**Note:**

Schauer Family Innovations, LLC is the exclusive provider and manufacturer of the HangSafe flat profile coat hook system. The provided product design is the registered trademark of Schauer Family Innovations, LLC. Any variation in design, modification to or duplication through production is strictly prohibited without the express written consent of Schauer Family Innovations, LLC.



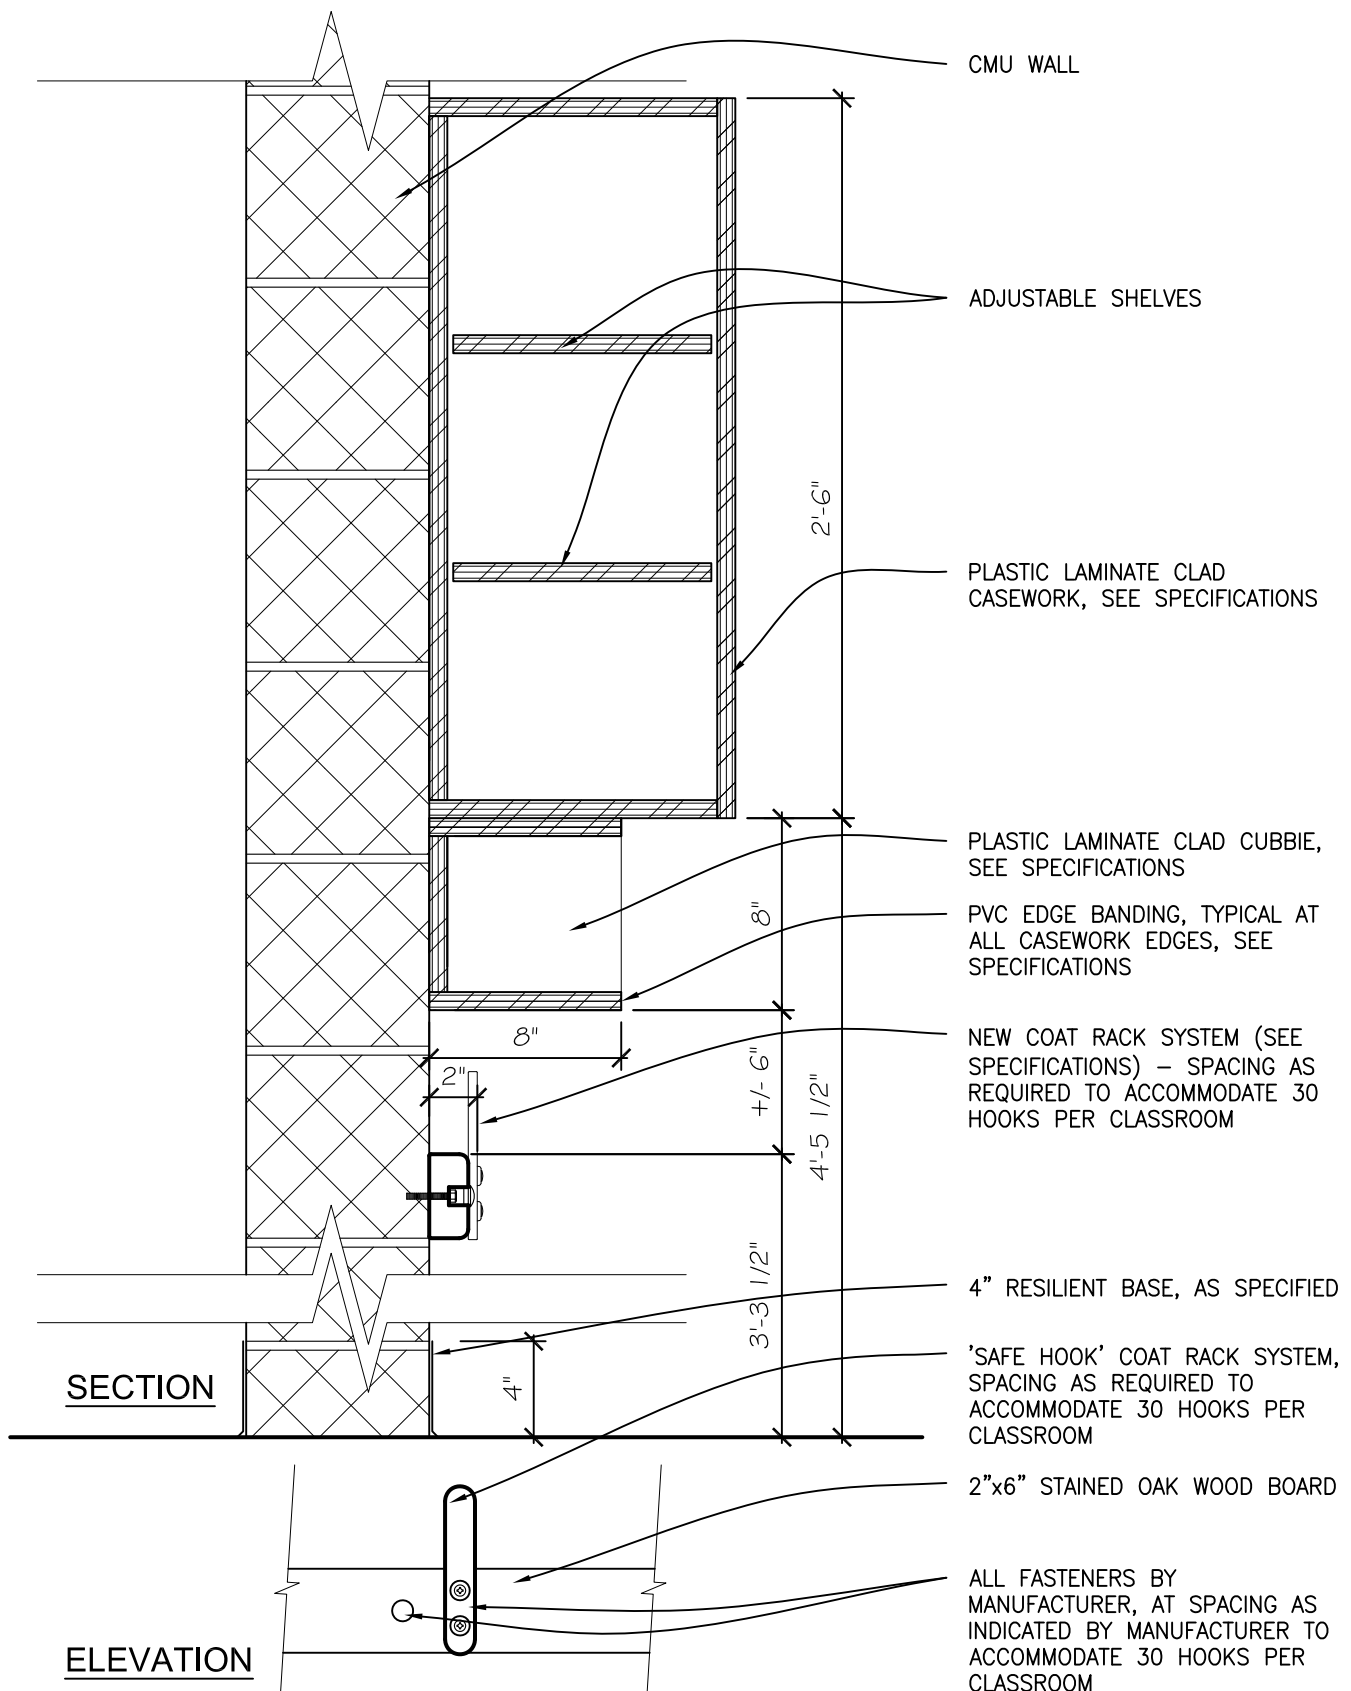

**WAKELY ASSOCIATES, INC./  
ARCHITECTS**

30500 Van Dyke Avenue, Suite M-7,  
Warren, Michigan 48093  
PH: 586.573.4100  
FX: 586.573.0822  
EM: wa@wakelyaia.com

# **Addendum No. 1 Greater Heights Academy Four Classroom Addition**

SCALE: 1-1/2" = 1'-0"

DRAWN BY:

JSM

PROJECT NO.:

141601

APPROVED BY:

BJS

REFERENCE SHEET:



A1.1, A6.1

DATE:

April 22, 2015



SHEET NO.:

A01-SK-1

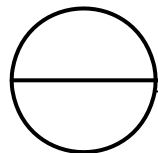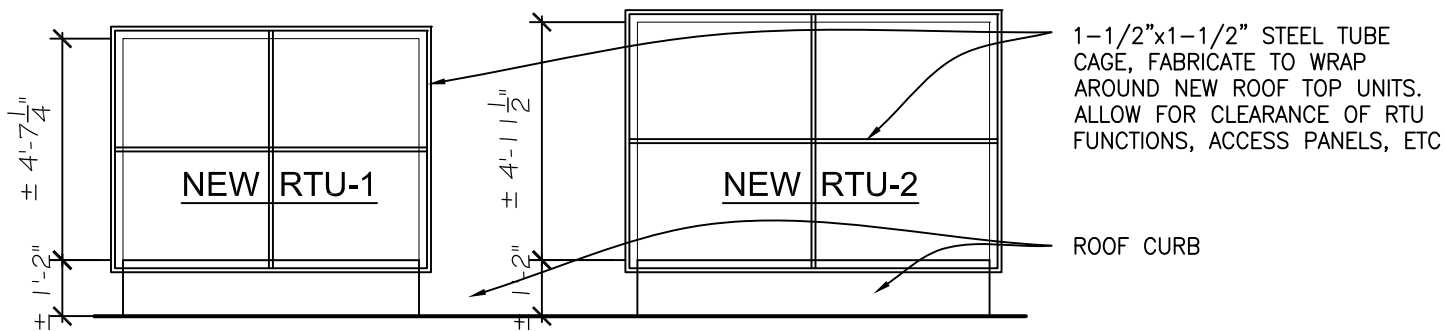



## HVAC ELEVATIONS

SCALE: 1/4" = 1'-0"

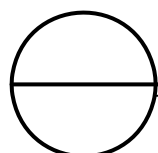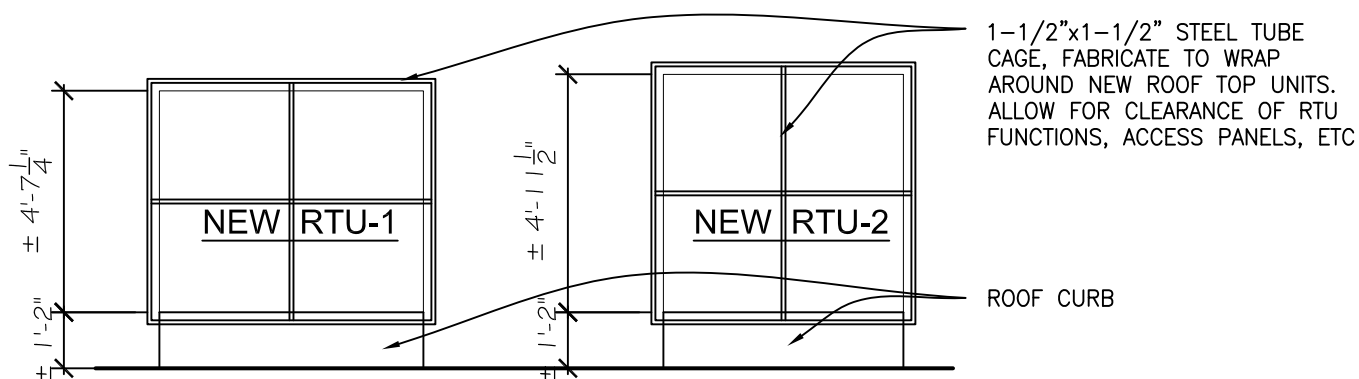

## HVAC ELEVATIONS

SCALE: 1/4" = 1'-0"

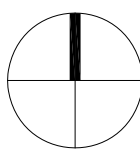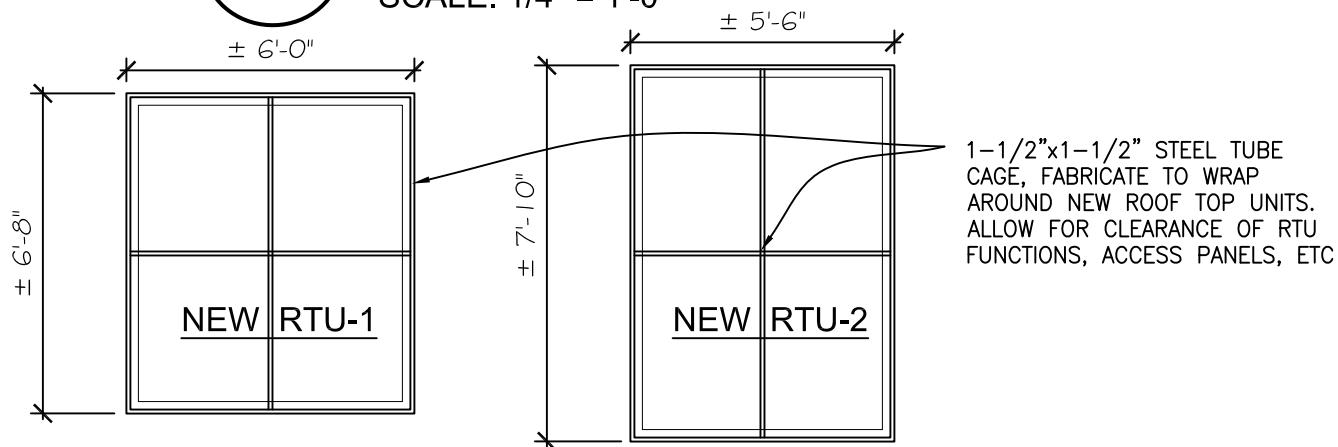

## PARTIAL ROOF PLAN

SCALE: 1/4" = 1'-0"



WAKELY ASSOCIATES, INC./  
ARCHITECTS

30500 Van Dyke Avenue, Suite M-7,  
Warren, Michigan 48093  
PH: 586.573.4100  
FX: 586.573.0822  
EM: wa@wakelyaia.com

Addendum No. 1  
Greater Heights Academy  
Four Classroom Addition

SCALE: 1/4" = 1'-0"

DRAWN BY:

JSM

PROJECT NO.:

141601

APPROVED BY:

BJS

REFERENCE SHEET:

A2.1

DATE:

April 22, 2015

SHEET NO.:

A01-SK-2

PROVIDE INSULATION AT TOP OF  
WALL CONNECTION TO METAL  
DECK

STANDING SEAM METAL ROOF  
PANELS ON FULL ICE AND  
WATER SHIELD OVER 1/2"  
PRESSURE TREATED PLYWOOD  
ON 2 LAYERS OF 1-1/2"  
INSULATION ON 1-1/2" METAL  
DECK ON STEEL JOISTS

CONTINUOUS 4x4x1/4" STEEL  
ANGLE TO SUPPORT  
CANTILEVERED METAL DECK

EAVE FLASHING, PER  
MANUFACTURER'S SPECIFICATIONS  
OVER PRESSURE TREATED, METAL  
CLAD PLYWOOD



PRE-FINISHED METAL SOFFIT

TOP OF MASONRY  
EL: VARIES

STEEL OUTRIGGERS,  
SEE STRUCTURAL

BRICK

EXTEND MASONRY WALL UP TO  
METAL DECK

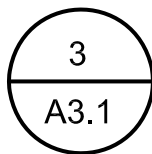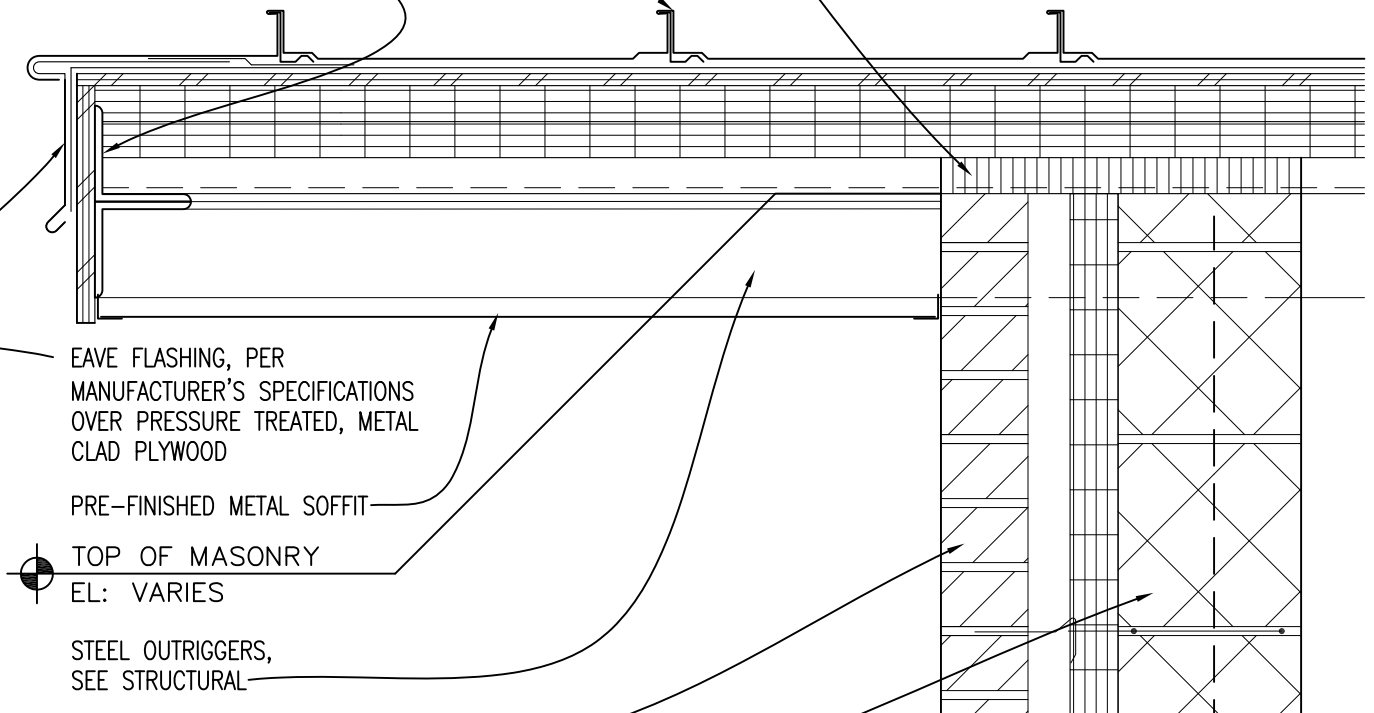

## TYPICAL EAVE DETAIL - NORTH AND SOUTH WALLS

SCALE: 1-1/2" = 1'-0"



WAKELY ASSOCIATES, INC./  
ARCHITECTS

30500 Van Dyke Avenue, Suite M-7,  
Warren, Michigan 48093  
PH: 586.573.4100  
FX: 586.573.0822  
EM: wa@wakelyaia.com

Addendum No. 1  
Greater Heights Academy  
Four Classroom Addition

SCALE: 1-1/2" = 1'-0"

DRAWN BY:  
JSM

APPROVED BY:  
BJS

DATE:  
April 22, 2015

PROJECT NO.:  
141601

REFERENCE SHEET:  
A4.2

SHEET NO.:  
A01-SK-3

STANDING SEAM METAL ROOF  
PANELS ON FULL ICE AND  
WATER SHIELD OVER 1/2"  
PRESSURE TREATED PLYWOOD  
ON 2 LAYERS OF 1-1/2"  
INSULATION ON 1-1/2" METAL  
DECK ON STEEL JOISTS

PROVIDE INSULATION AT TOP OF  
WALL CONNECTION TO METAL  
DECK

4x4x1/4" BENT STEEL PLATE  
TO SUPPORT CANTILEVERED  
METAL DECK

EXTEND TOP CHORD OF STEEL  
JOISTS, SEE STRUCTURAL

PRE-FINISHED METAL SOFFIT


EAVE FLASHING, PER  
MANUFACTURER'S SPECIFICATIONS  
OVER PRESSURE TREATED, METAL  
CLAD PLYWOOD

RAIN GUTTER

EXTEND MASONRY WALL UP TO  
METAL DECK

8" CMU BOND BEAM WITH  
2-#5 (TYPICAL)

## TYPICAL OVERHANG DETAIL - EAST WALL

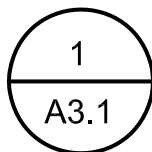

SCALE: 1-1/2" = 1'-0"



WAKELY ASSOCIATES, INC./  
ARCHITECTS

30500 Van Dyke Avenue, Suite M-7,  
Warren, Michigan 48093  
PH: 586.573.4100  
FX: 586.573.0822  
EM: wa@wakelyaia.com

Addendum No. 1  
Greater Heights Academy  
Four Classroom Addition

SCALE: 1-1/2" = 1'-0"

DRAWN BY:

JSM

PROJECT NO.:

141601

APPROVED BY:

BJS

REFERENCE SHEET:


A4.1

DATE:

April 22, 2015

SHEET NO.:

A01-SK-4

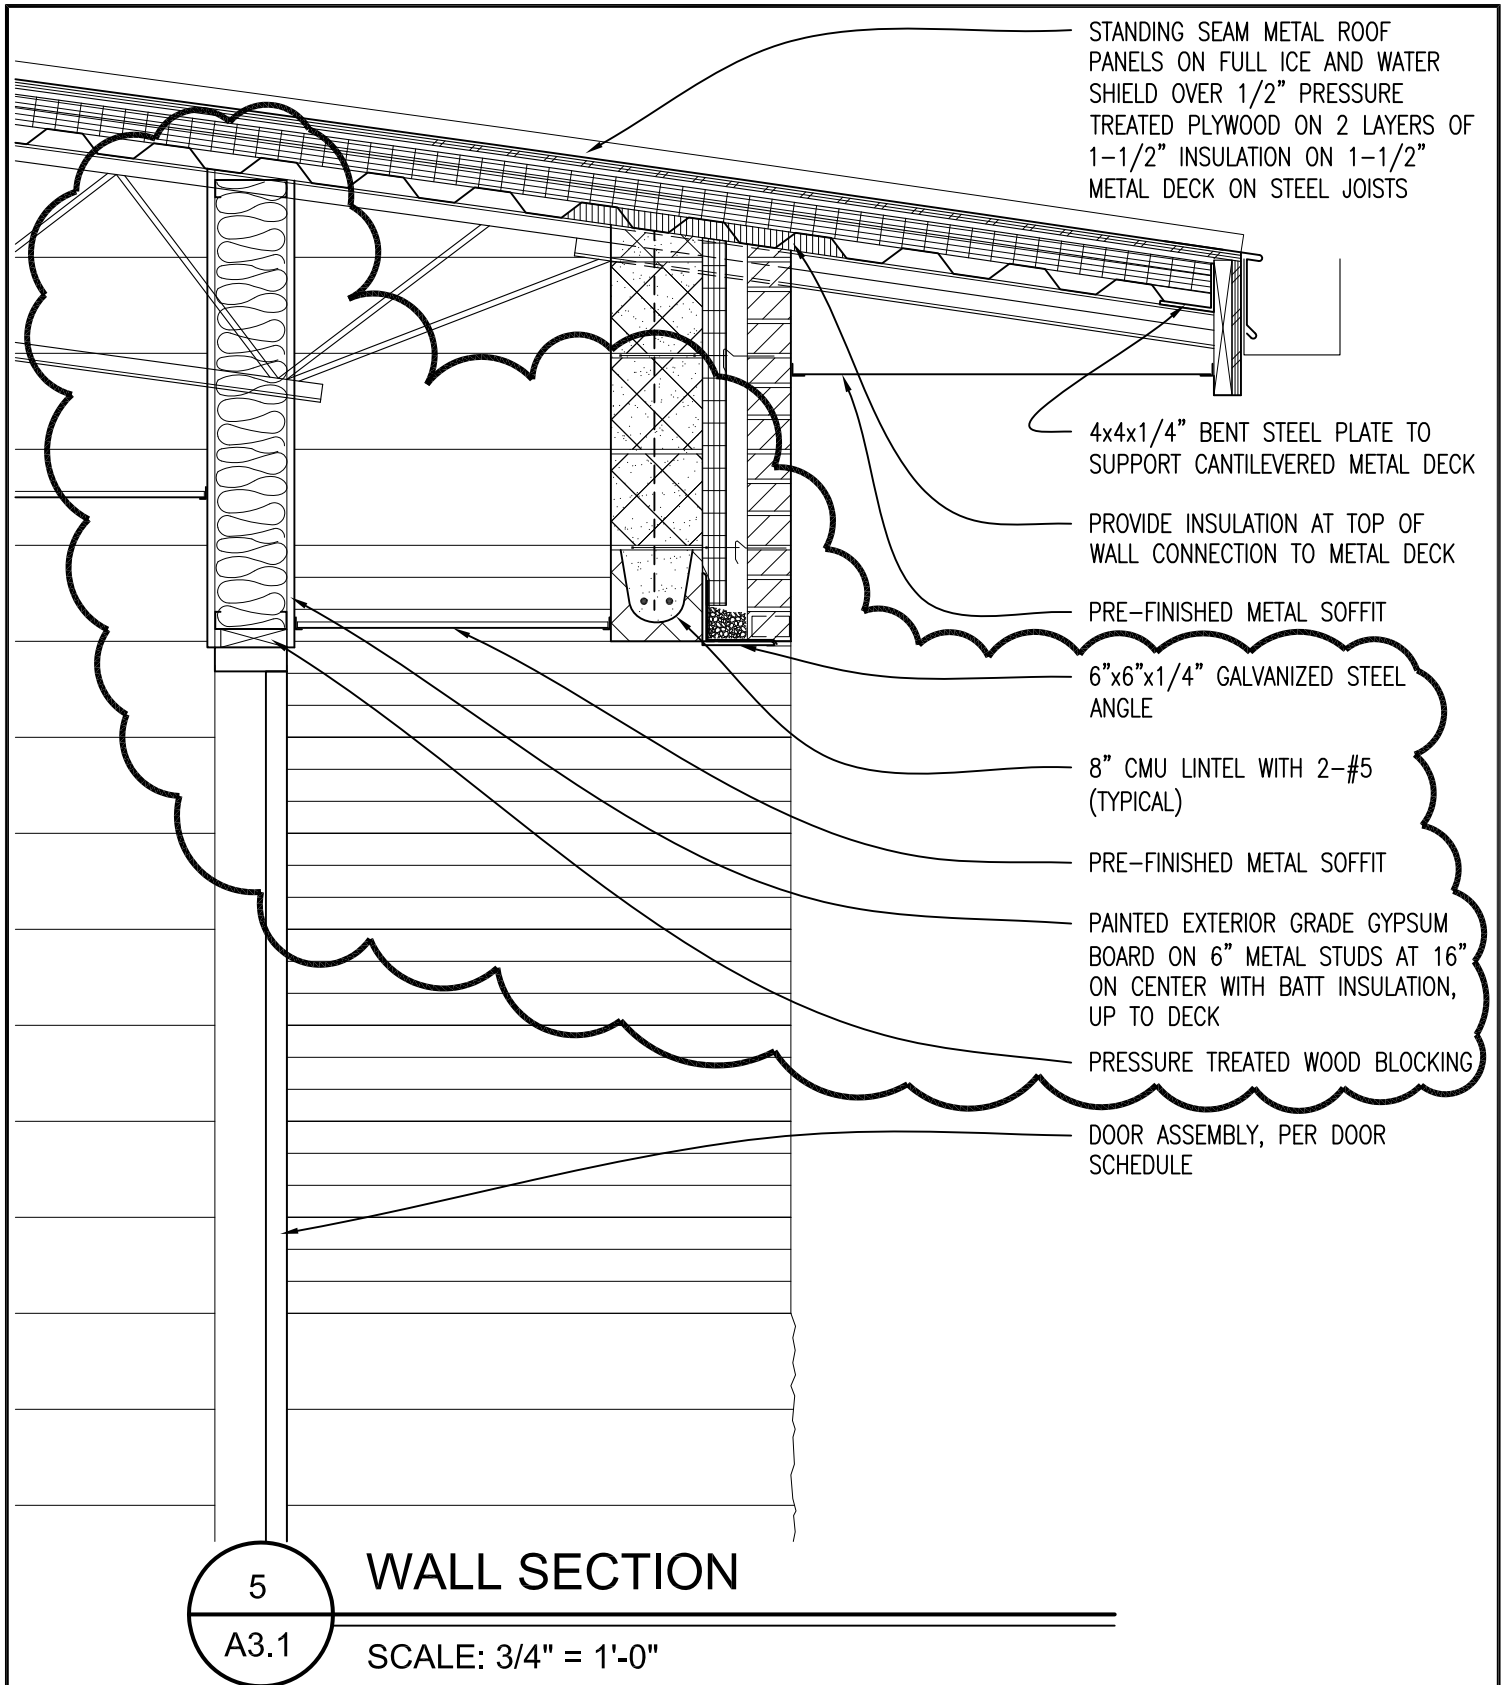

**WAKELY ASSOCIATES, INC./  
ARCHITECTS**

30500 Van Dyke Avenue, Suite M-7,  
Warren, Michigan 48093  
PH: 586.573.4100  
FX: 586.573.0822  
EM: wa@wakelyaia.com

**Addendum No. 1  
Greater Heights Academy  
Four Classroom Addition**

SCALE: 3/4" = 1'-0"

DRAWN BY:

JSM

PROJECT NO.:

141601

APPROVED BY:

BJS

REFERENCE SHEET:



A4.1

DATE:

April 22, 2015

SHEET NO.:

A01-SK-5

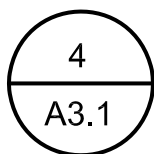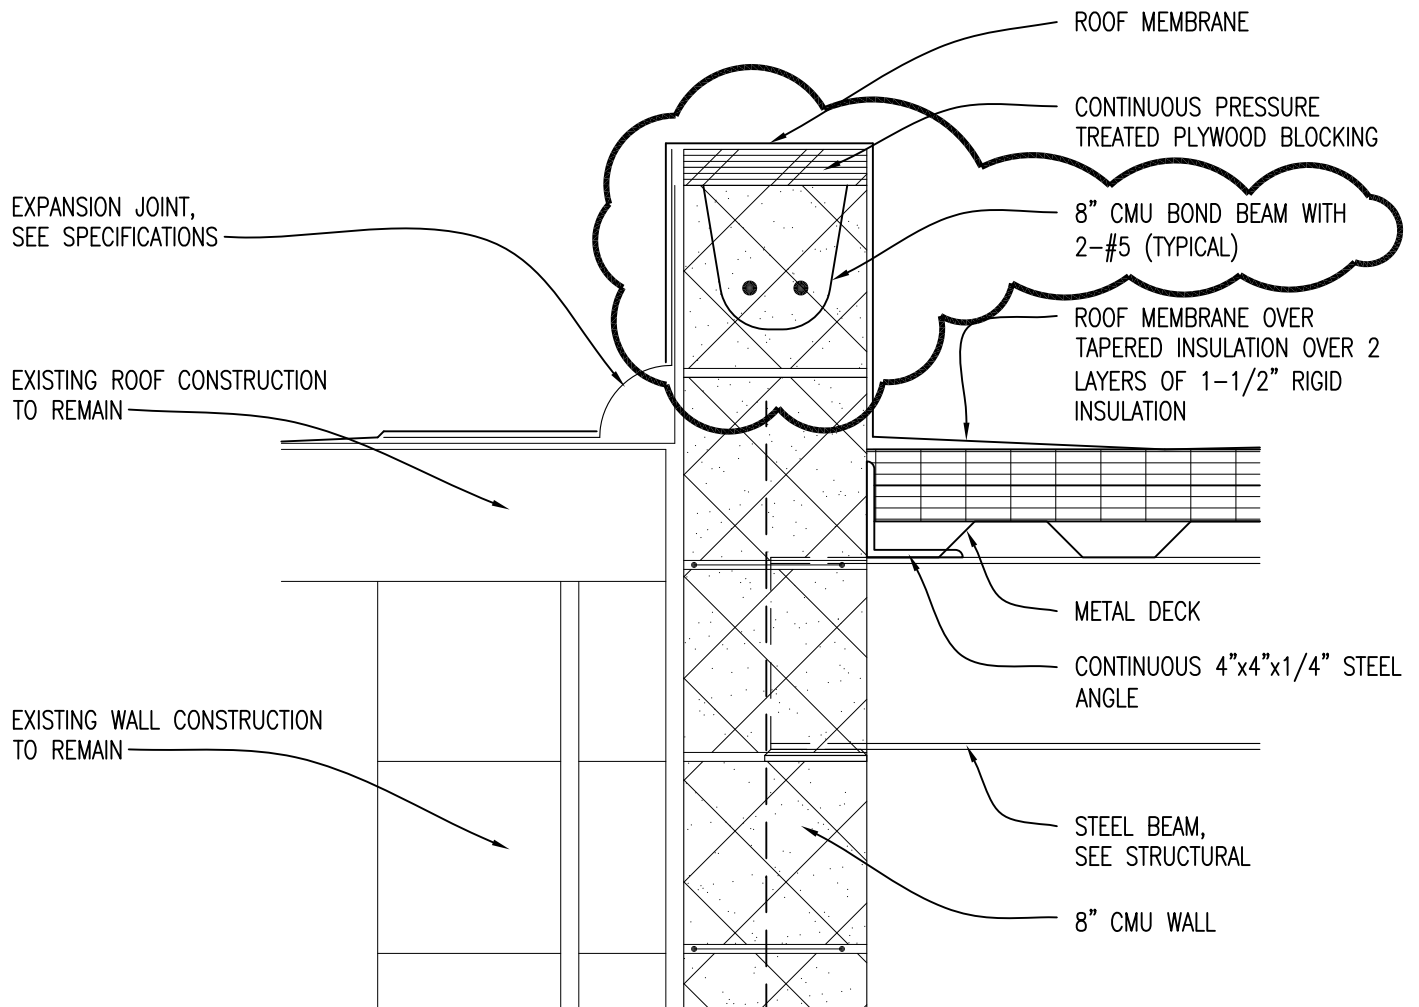

## WALL CONNECTION DETAIL

SCALE: 1-1/2" = 1'-0"



**WAKELY ASSOCIATES, INC./  
ARCHITECTS**

30500 Van Dyke Avenue, Suite M-7,  
Warren, Michigan 48093  
PH: 586.573.4100  
FX: 586.573.0822  
EM: wa@wakelyaia.com

**Addendum No. 1  
Greater Heights Academy  
Four Classroom Addition**

SCALE: 1-1/2" = 1'-0"

DRAWN BY:

JSM

PROJECT NO.:

141601

APPROVED BY:

BJS

REFERENCE SHEET:

A4.1




DATE:

April 22, 2015

SHEET NO.:

A01-SK-6



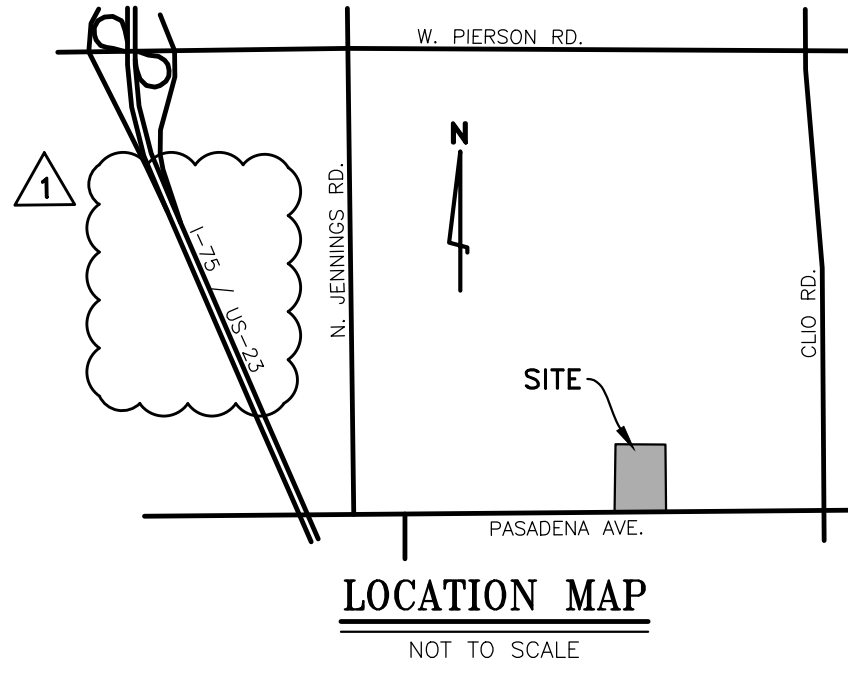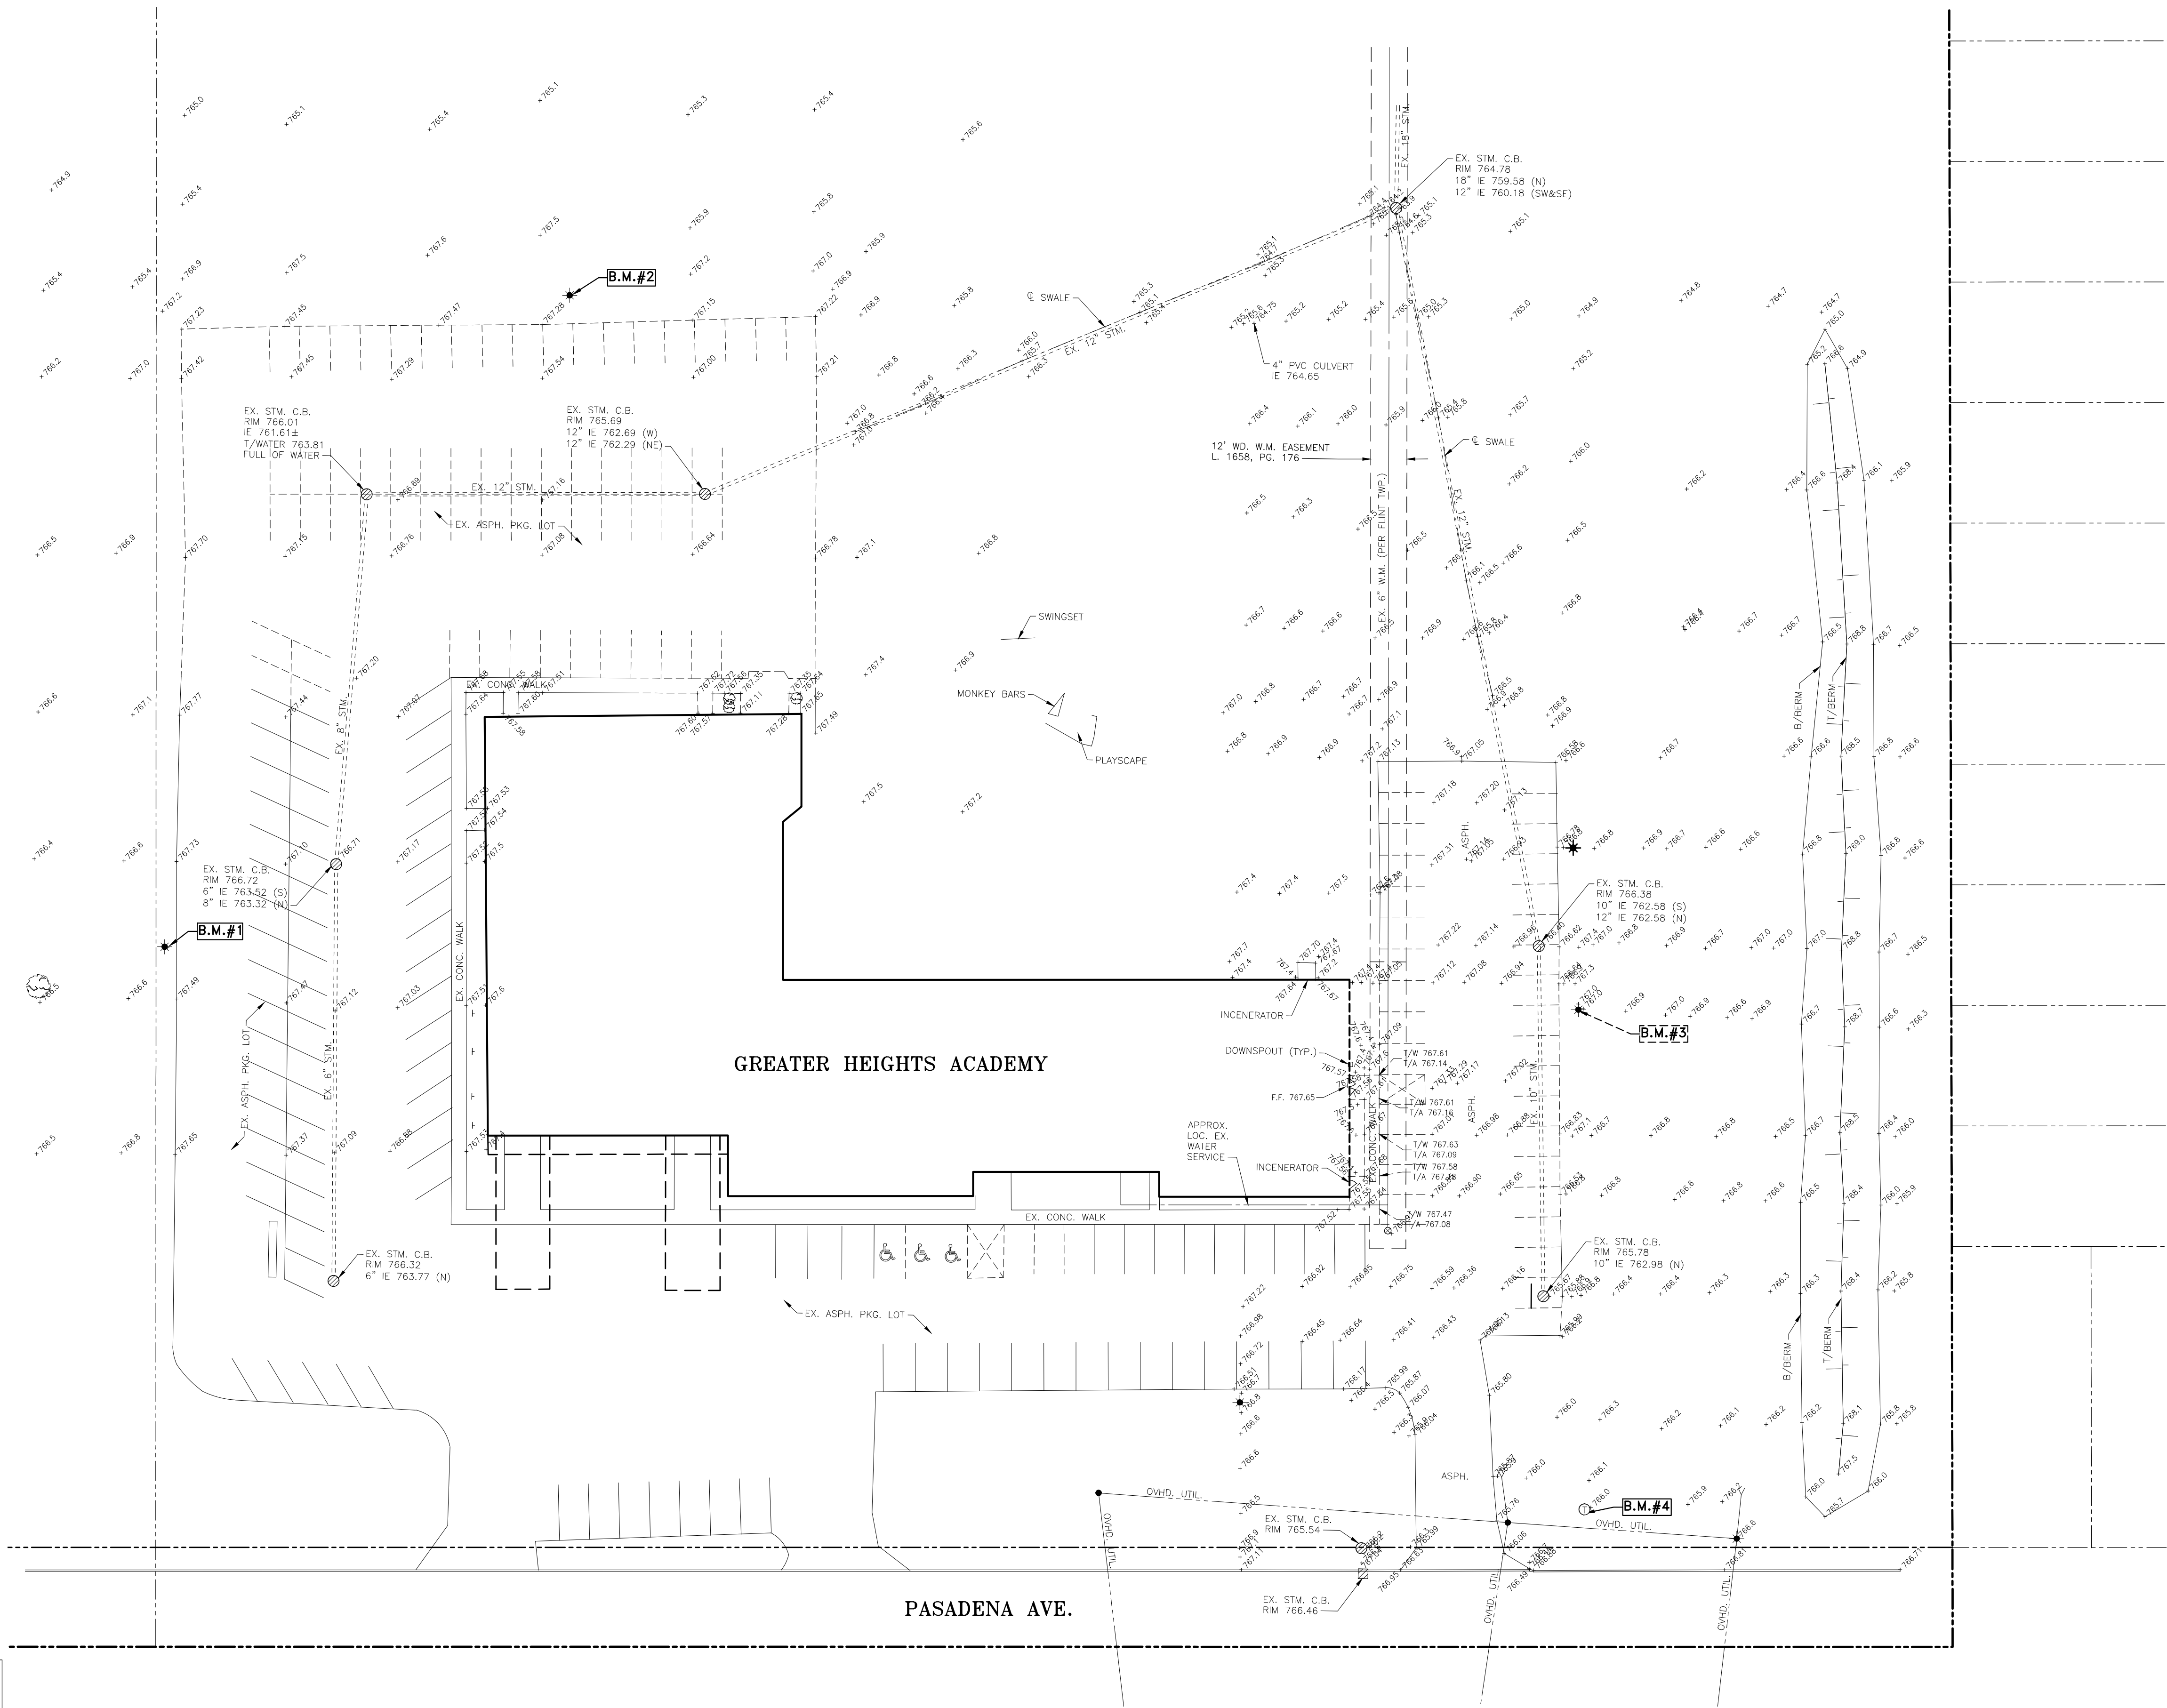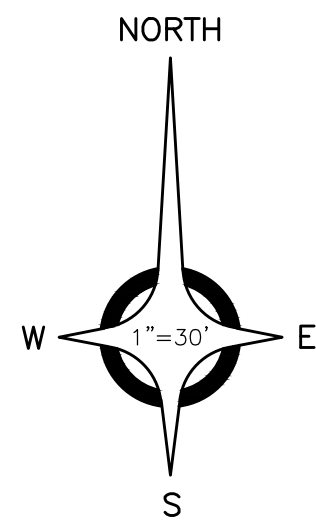

#### BOUNDARY DATA

BOUNDARY AS PER ALTA/ACSM LAND TITLE  
SURVEY DATED 01-13-2012 PREPARED BY  
EXCEL ENGINEERING, INC.

#### BENCH MARKS (NAVD88 DATUM)

BENCH MARK NO. 1  
T/CONC. LIGHT POLE BASE,  
(E/FACE) ON W. SIDE BLDG.  
ELEVATION: 769.03

BENCH MARK NO. 2  
T/CONC. LIGHT POLE BASE,  
(S/FACE) 70'± N. OF N.W.  
COR. BLDG.  
ELEVATION: 768.84

BENCH MARK NO. 3  
T/CONC. LIGHT POLE BASE,  
(W/FACE) 75'± E. OF E. SIDE  
OF BLDG.  
ELEVATION: 769.28

BENCH MARK NO. 4  
"X" ON S. RIM MBT MAN HOLE,  
60'± N. OF PASADENA & 60'±  
E. OF E. DRIVEWAY.  
ELEVATION: 765.97

UTILITY INFORMATION, AS SHOWN, INDICATES APPROXIMATE  
LOCATIONS AND TYPES OF EXISTING FACILITIES ONLY. AS  
DISCLOSED BY RECORDS PROVIDED TO THIS FIRM FROM THE  
VARIOUS UTILITY COMPANIES. NO GUARANTEE IS GIVEN OR  
IMPLIED AS TO THE COMPLETENESS OR ACCURACY THEREOF.

PRIOR TO CONSTRUCTION, ALL LOCATIONS AND DEPTHS OF  
EXISTING OVERHEAD AND UNDERGROUND UTILITIES (IN  
CONFLICT WITH THE CONSTRUCTION OF THESE PROPOSED  
IMPROVEMENTS) SHALL BE VERIFIED IN THE FIELD. DURING  
THE CONSTRUCTION, THE CONTRACTOR SHALL PROTECT AND  
SUPPORT ALL UTILITIES THAT ARE ENCOUNTERED. (ALL  
COSTS FOR UTILITY LOCATION VERIFICATION, SUPPORT AND  
PROTECTION SHALL BE INCLUDED IN THE PROPOSED PAY ITEM  
CONFLICTING WITH THAT UTILITY).


DURING CONSTRUCTION, THE CONTRACTOR SHALL USE  
EXTREME CAUTION WHEN OPERATING NEAR ANY AND ALL  
OVERHEAD AND / OR BURIED UTILITIES.

3 WORKING DAYS BEFORE YOU DIG  
CALL MISS DIG 811 TOLL FREE

WA

WAKELY ASSOCIATES, INC./  
ARCHITECTS

30500 VAN DYKE AVENUE  
SUITE 14-7  
WARREN, MICHIGAN 48093  
PH: 586.573.4100  
FX: 586.573.0822  
www.wakelyaia.com

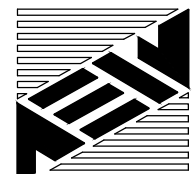

ANDERSON, ROCKSTEIN  
AND WESTRICK, INC.  
51301 Schoenherer Road,  
Shady Township, Michigan 48115  
Phone: 586-725-1124  
Fax: 586-725-1124  
AEW NO. 0577-0074

# GREATER HEIGHTS ACADEMY FOUR CLASSROOM ADDITION FLINT, MICHIGAN

TOPOGRAPHIC  
SURVEY

PRELIMINARY ☒  
DESIGN DEVELOPMENT ☐  
CONSTRUCTION ☐  
FINAL RECORD ☐

DRAWN BY: KJP  
CHECKED BY: JS


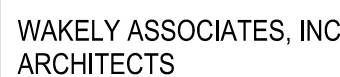
REVISIONS:

REVISIONS:

DATE: MARCH, 2015  
SHEET NO.:

C1.0

JOB NO.: 141601



**ANDERSON, ECKSTEIN  
AND WESTRICK INC.**  
51301 Schoenherr Road,  
Shelby Township, Michigan 48315  
Phone 586-726-1234  
Fax 586-726-8760  
AEW NO. 0577-0074

REMOVAL  
PLAN

DRAWN BY: K  
CHECKED BY: .

REVISIONS:


DATE: MARCH, 20  
SHEET NO.:

JOB NO.: 141601



CONTRACTOR TO CONTACT THE OWNER FOR THE STAKING OF ALL EXISTING UNDERGROUND CABLE ELECTRICAL SERVICES AND IRRIGATION SYSTEMS WITHIN THE PROJECT LIMITS.

IN ADDITION, MISS DIG SHOULD BE CONTACTED FOR ALL MAJOR SERVICES WITHIN THE PROJECT LIMITS.

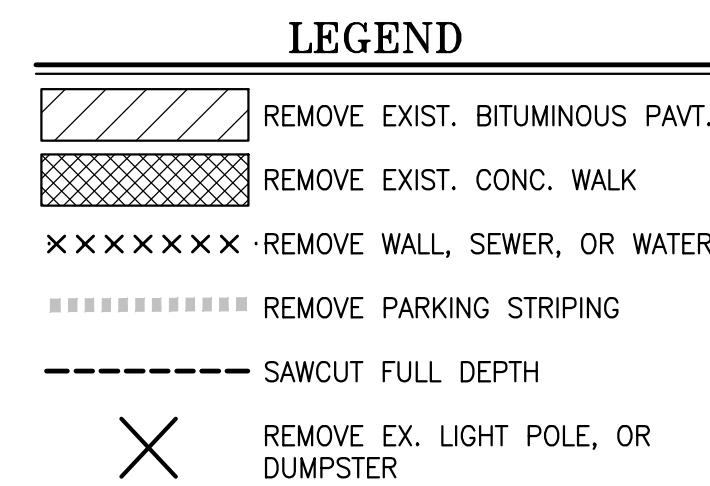

BENCH MARKS  
(NAVD88 DATUM)

BENCH MARK NO. 1  
T/CONC. LIGHT POLE BASE,  
(E/FACE) ON W. SIDE BLDG.  
ELEVATION: 769.03

BENCH MARK NO. 2  
T/CONC. LIGHT POLE BASE,  
(S/FACE) 70'± N. OF N.W.  
COR. BLDG.  
ELEVATION: 768.84

BENCH MARK NO. 3  
T/CONC. LIGHT POLE BASE,  
(W/FACE) 75'± E. OF E. SIDE  
OF BLDG.  
ELEVATION: 769.28

BENCH MARK NO. 4  
"X" ON S. RIM MBT MAN HOLE,  
60'± N. OF PASADENA & 60'±  
E. OF E. DRIVEWAY.  
ELEVATION: 765.97


UTILITY INFORMATION, AS SHOWN, INDICATES APPROXIMATE LOCATIONS AND TYPES OF EXISTING FACILITIES ONLY, AS DISCLOSED BY RECORDS PROVIDED TO THIS FIRM FROM THE VARIOUS UTILITY COMPANIES. NO GUARANTEE IS GIVEN OR IMPLIED AS TO THE COMPLETENESS OR ACCURACY THEREOF.

PRIOR TO CONSTRUCTION, ALL LOCATIONS AND DEPTHS OF EXISTING OVERHEAD AND UNDERGROUND UTILITIES (IN CONFLICT WITH THE CONSTRUCTION OF THESE PROPOSED IMPROVEMENTS) SHALL BE VERIFIED IN THE FIELD. DURING THE CONSTRUCTION, THE CONTRACTOR SHALL PROTECT AND SUPPORT ALL UTILITIES THAT ARE ENCOUNTERED. (ALL COSTS FOR UTILITY LOCATION VERIFICATION, SUPPORT AND PROTECTION SHALL BE INCLUDED IN THE PROPOSED PAY (IN CONFLICTING WITH THAT UTILITY)).

DURING CONSTRUCTION, THE CONTRACTOR SHALL USE EXTREME CAUTION WHEN OPERATING NEAR ANY AND ALL OVERHEAD AND / OR BURIED UTILITIES.

3 WORKING DAYS BEFORE YOU DIG  
CALL MISS DIG 811 TOLL FREE



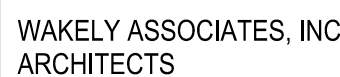

30500 VAN DYKE AVENUE  
SUITE M-7  
WARREN, MICHIGAN 48093  
PH: 586.573.4100  
FX: 586.573.0822  
[www.wakelyaia.com](http://www.wakelyaia.com)



GREATER HEIGHTS ACADEMY  
FOUR CLASSROOM ADDITION  
FLINT MICHIGAN

# SITE PLAN

PRELIMINARY	
DESIGN DEVELOPMENT	
CONSTRUCTION	
FINAL RECORD	

DRAWN BY: K  
CHECKED BY: .

REVISIONS:

---



SHEET NO.:

## C3.0

JOB NO.: 141601



1. THE CONTRACTOR AT ALL TIMES SHALL FOLLOW ALL FEDERAL, STATE AND LOCAL SAFETY REQUIREMENTS DURING CONSTRUCTION OF THIS PROJECT. SPECIAL CARE SHALL BE TAKEN TO PROTECT ALL EXISTING UTILITIES, STRUCTURES, TREES, AND ADJACENT PROPERTIES. ALL TRAFFIC CONTROL DEVICES, INCLUDING BUT NOT LIMITED TO, CONE PLACEMENT, FLAGGING, AND BARRICADES, MUST BE INSTALLED AS REQUIRED TO PROVIDE MAXIMUM SAFETY TO THE CONTRACTOR'S WORKERS IN FULL COMPLIANCE WITH OSHA REGULATIONS.
2. ALL CONSTRUCTION SHALL BE CONDUCTED SUCH THAT THERE WILL BE MINIMAL INTERFERENCE WITH STREETS, DRIVES OR WALKS. THE CONTRACTOR IS RESPONSIBLE FOR MAINTAINING TRAFFIC FLOW, MINIMIZING DELAYS, AND PROVIDING ADEQUATE TRAFFIC OR USER FACILITIES WITHOUT PERMISSION FROM THE OWNER'S REPRESENTATIVE.
3. CONTRACTOR SHALL KEEP EXISTING STREETS, ROADS AND DRIVES CLEAR OF DIRT, DEBRIS AND EQUIPMENT.
4. REVIEW CONSTRUCTION AND AND SCHEDULE AT THE PRECONSTRUCTION MEETING WITH OWNER.
5. THE CONTRACTOR SHALL VERIFY ALL SITE CONDITIONS IN THE FIELD AND CONTACT THE ENGINEER IF THERE ARE ANY QUESTIONS OR CONFLICTS REGARDING THE CONSTRUCTION DOCUMENTS AND/OR FIELD CONDITIONS SO THAT APPROPRIATE REVISIONS CAN BE MADE. FOR CONSTRUCTION OF ALTERNATE FACILITIES (DRAINAGE, BRIDGES, ETC.) SPECIFICATIONS SHALL BE CONFIRMED WITH THE ENGINEER PRIOR TO BIDDING.
6. THE CONTRACTOR SHALL ABIDE BY ALL OSHA, FEDERAL, STATE AND LOCAL REGULATION WHEN OPERATING CRANES, BOOMS, HOISTS, ETC. IN CLOSE PROXIMITY TO OVERHEAD ELECTRIC LINES. IF CONTRACTOR MUST OPERATE EQUIPMENT CLOSE TO ELECTRIC LINES CONTACT THE POWER COMPANY TO MAKE ARRANGEMENTS FOR PROPER SAFEGUARDS.
7. THE OWNER AT ITS DISCRETION RESERVES THE RIGHT TO MODIFY THE DETAILS AND SPECIFICATIONS WRITTEN AND/OR SHOWN FROM THE STATE DOT, LOCAL MUNICIPALITY, COUNTY OR OTHER GOVERNING AUTHORITY IS REQUIRED.
8. CONTRACTOR SHALL MAINTAIN ALL TRAFFIC LANES AND PEDESTRIAN WALKWAYS AT ALL TIMES. UNLESS OTHERWISE NOTICED BY THE STATE DOT, LOCAL MUNICIPALITY, COUNTY OR OTHER GOVERNING AUTHORITY IS REQUIRED.
9. THE CONTRACTOR SHALL NOTIFY THE ENGINEER SHOULD ANY DISCREPANCY REGARDING THE PROPOSED WORK OR UNFORESEEN CONDITIONS ARISE PRIOR TO PROCEEDING FURTHER WITH THE AFFECTED WORK.
10. THE CONTRACTOR SHALL PROVIDE AS-BUILT RECORDS OF ALL CONSTRUCTION (INCLUDING UNDERGROUND UTILITIES) TO THE ENGINEER AND OWNER FOLLOWING COMPLETION OF CONSTRUCTION ACTIVITIES.
11. ALL PAVING AND AGGREGATE MATERIALS AND WORK COMPLETED SHALL BE IN STRICT ACCORDANCE WITH THE STATE DOT SPECIFICATIONS AND STANDARD DETAILS UNLESS OTHERWISE SPECIFIED.
12. THE CONTRACTOR SHALL BE RESPONSIBLE FOR VERIFYING ALL DIMENSIONS FOR BUILDING, WALLS, CONCRETE SLABS, AND UTILITY SERVICE POINT CONNECTIONS AND NOTIFYING THE OWNER AND ENGINEER OF ANY CONFLICTS OR DISCREPANCIES PRIOR TO CONSTRUCTION.
13. THE CONTRACTOR SHALL SUBMIT SHOP DRAWINGS OF ALL PRODUCTS AND MATERIALS TO THE ENGINEER FOR REVIEW AND APPROVAL AS REQUIRED FOR REVIEW AND APPROVAL PRIOR TO FABRICATION OR DELIVERY TO THE SITE. ALLOW A MINIMUM OF 7 DAYS FOR REVIEW.
14. THE CONTRACTOR SHALL REFERENCE ARCHITECTURAL PLANS FOR EXACT DIMENSIONS AND CONSTRUCTION DETAILS OF BUILDING, CANOPY, AND UTILITY CONNECTIONS.
15. TRAFFIC CONTROL SIGNAGE SHALL CONFORM TO THE STATE DOT STANDARD DETAIL SHEETS AND THE MANUAL OF UNIFORM TRAFFIC CONTROL DEVICES. SIGNS SHALL BE INSTALLED PLUMB.
16. FIRE LANES SHALL BE ESTABLISHED AND PROPERLY DESIGNATED IN ACCORDANCE WITH THE LOCAL MUNICIPALITY AND LOCAL FIRE DEPARTMENT REQUIREMENTS.
17. THE CONTRACTOR SHALL REMOVE CONFLICTING PAVEMENT MARKINGS IN A METHOD APPROVED BY THE STATE DOT.
18. AGGREGATES AND BITUMINOUS PAVEMENT MATERIAL AND INSTALLATION SPECIFICATIONS SHALL BE IN ACCORDANCE WITH STATE DOT SPECS. THE CONTRACTOR SHALL SUBMIT AGGREGATE SIZE ANALYSIS AND A JOB-MIX FORMULA FOR THE BITUMINOUS PAVEMENT TO THE ENGINEER FOR REVIEW AND APPROVAL AT LEAST 14 DAYS PRIOR TO THE PULVERIZED BITUMINOUS PAVEMENT.
19. ALTERNATIVE METHODS AND PRODUCTS OTHER THAN THOSE SPECIFIED MAY BE USED IF REVIEWED AND APPROVED BY THE OWNER, ENGINEER, AND APPROPRIATE REGULATORY AGENCIES PRIOR TO INSTALLATION.
20. PROVIDE ADEQUATE BARRICADES AT DRIVES, ENTRANCES, EXCAVATIONS AND OTHER OPENINGS TO KEEP OUT UNAUTHORIZED PERSONS AND FOR PUBLIC SAFETY AND TRAFFIC CONTROL. BARRICADES SHALL BE MAINTAINED AND PROPERLY OBSERVED AT ALL TIMES. BARRICADES LEFT IN PLACE AT NIGHT SHALL BE LIGHTED.
21. NO EQUIPMENT OR MATERIAL STORAGE IS PERMITTED WITHIN THE ROAD RIGHT-OF-WAY.
22. CONTRACTOR'S MANNER AND METHOD OF INGRESS AND EGRESS WITH RESPECT TO THE PROJECT SHALL BE IN NO WAY UNREASONABLY DISTURB NORMAL PEDESTRIAN OR VEHICULAR TRAFFIC IN THE VICINITY AND IS SUBJECT TO REGULATION AND WRITTEN APPROVAL OF APPROPRIATE GOVERNING AGENCIES.
23. CONSTRUCTION SHALL BE IN ACCORDANCE WITH A.D.A. REGULATIONS AS APPLICABLE.

PARKING DATA:

EXISTING: 185 SPACES (3 H.C.)  
PROPOSED: 160 SPACES (6 H.C.)





GREATER HEIGHTS ACADEMY  
FOUR CLASSROOM ADDITION  
FLINT MICHIGAN

MISCELLANEOUS  
PROJECT  
DETAILS

PRELIMINARY	
DESIGN DEVELOPMENT	
CONSTRUCTION	
FINAL RECORD	
<hr/>	
DRAWN BY:	K
CHECKED BY:	

REVISIONS:

---

---

---

---



---

DATE: MARCH, 20SHEET NO.:0505100.0

---



JOB NO.: 141601

---


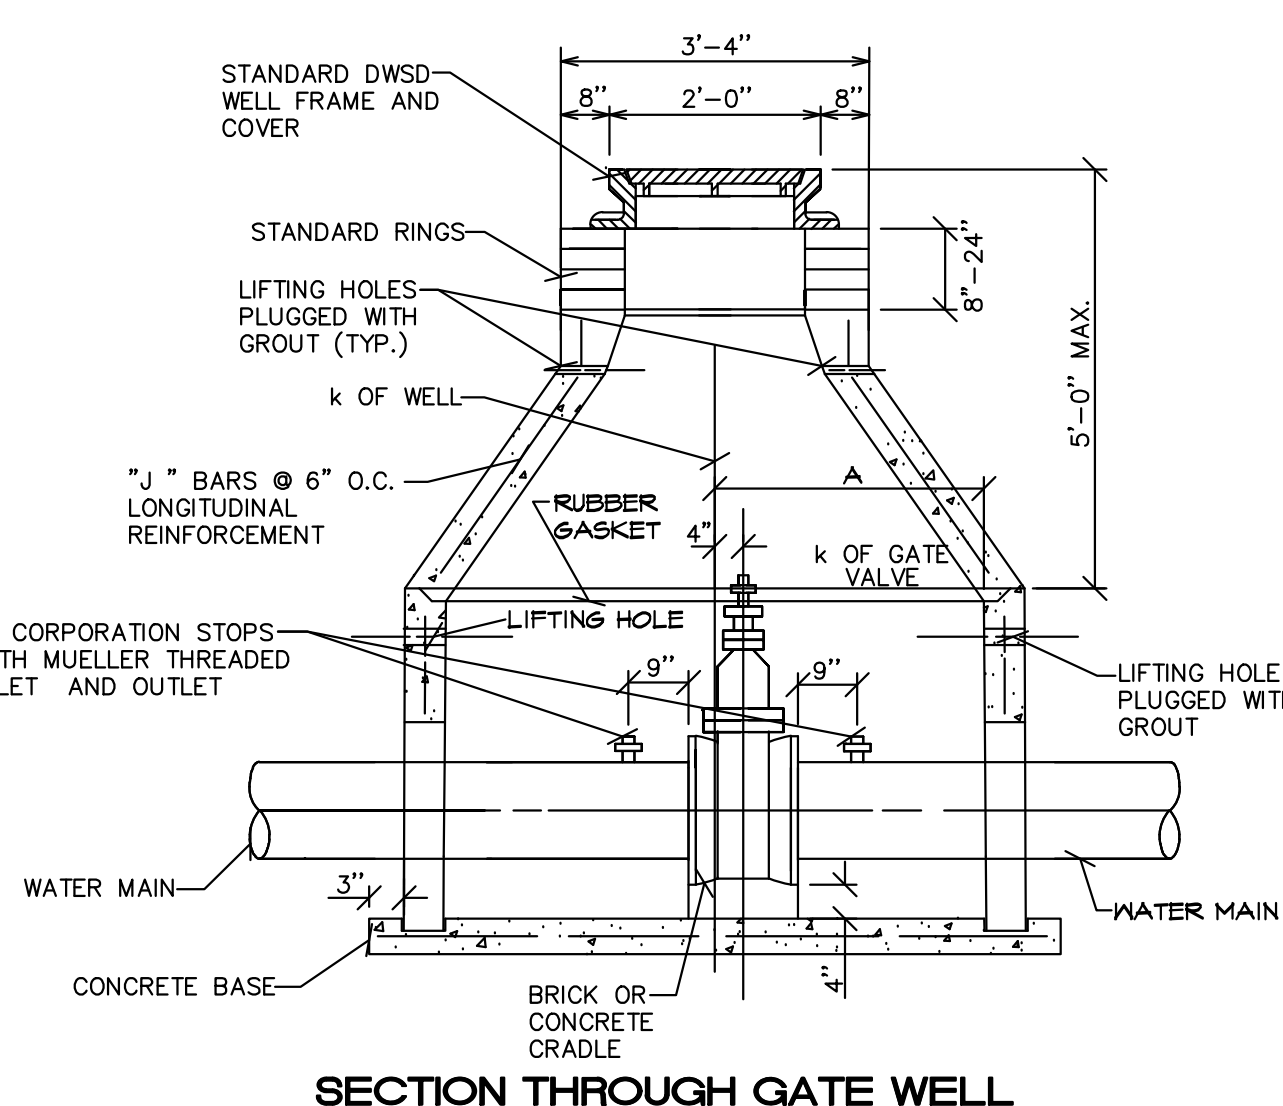
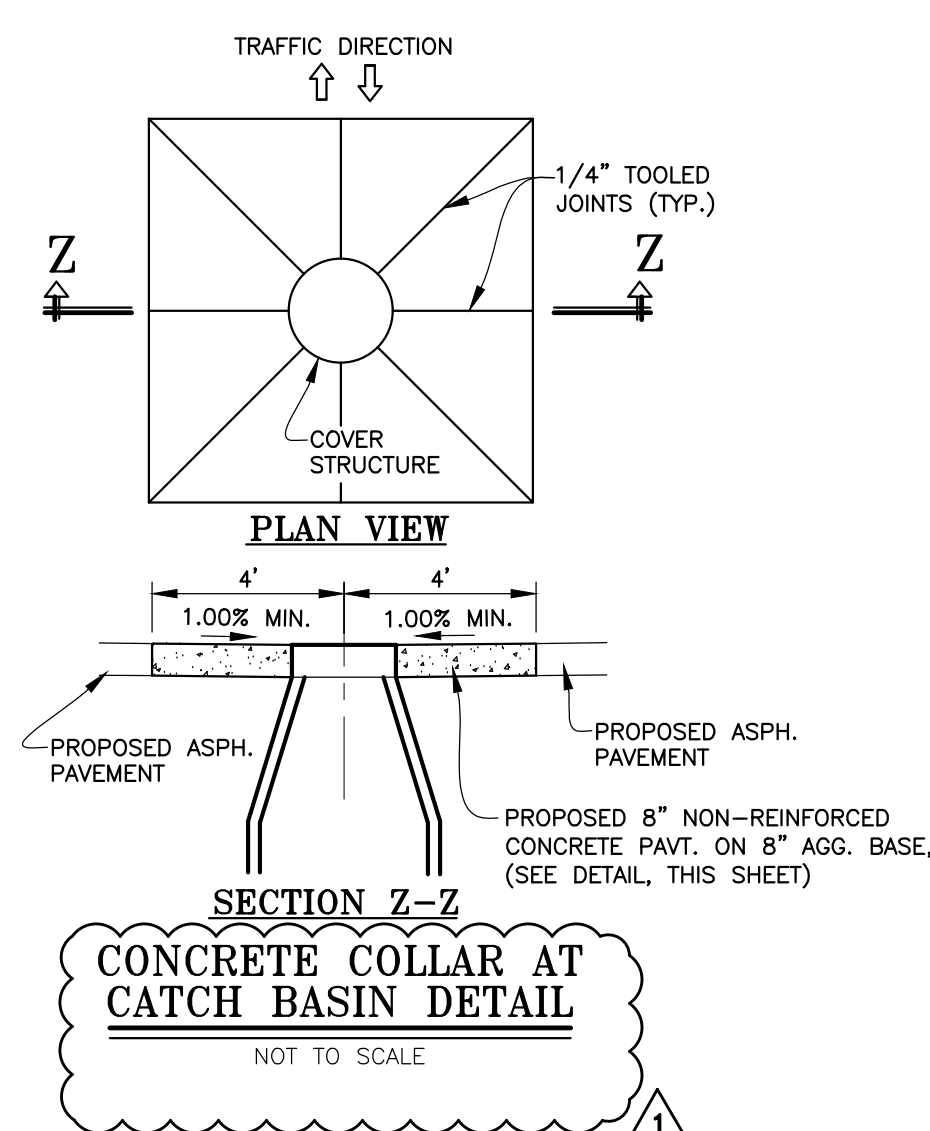


SIZE	A	B	C	D	E	F	G	H	J
6" x 8"	2'-6"	5'-0"	6'-0"	1'-4"	8"	12"	8"	6"	1/2"
12"	3'-0"	6'-0"	7'-2"	2'-0"	1'-0"	1'-0"	8"	7"	5/8"
18"	3'-0"	6'-0"	7'-2"	2'-0"	1'-0"	1'-0"	8"	7"	5/8"




\* DIMENSIONS MAY VARY BY MANUFACTURER

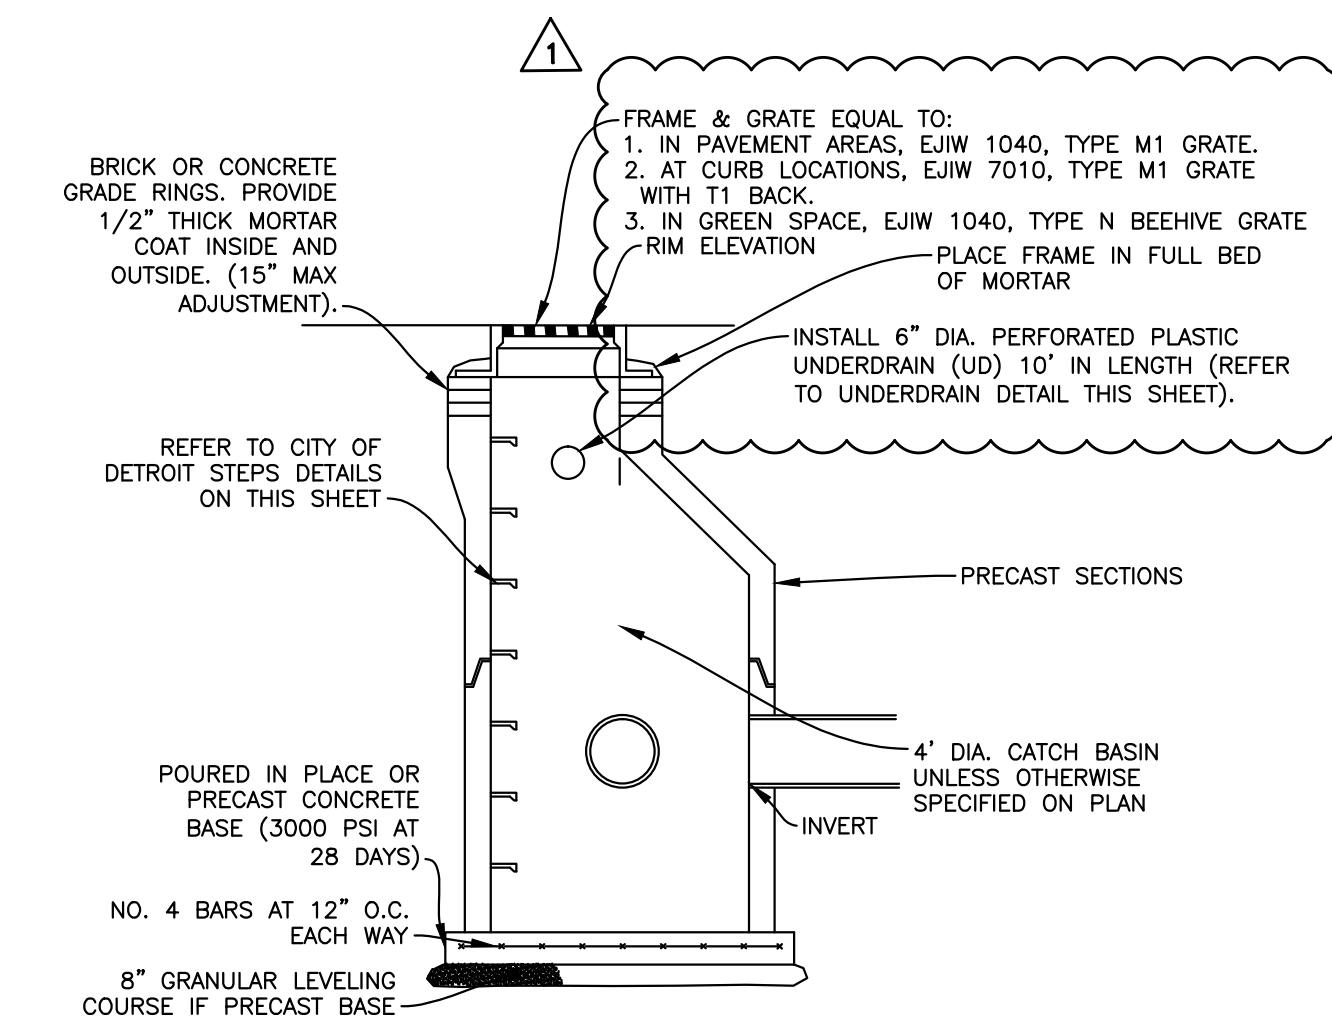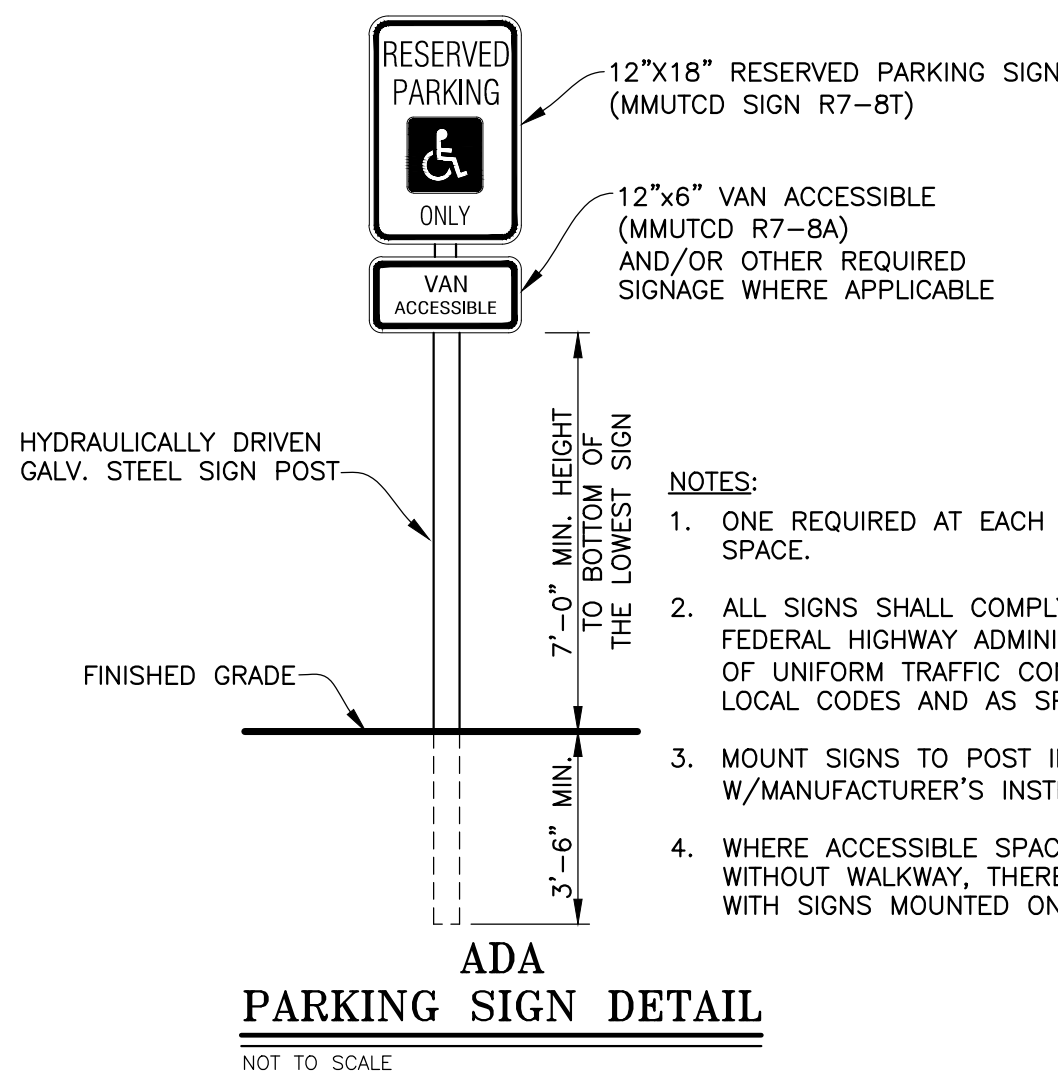

CATCH BASIN  
NOT TO SCALE

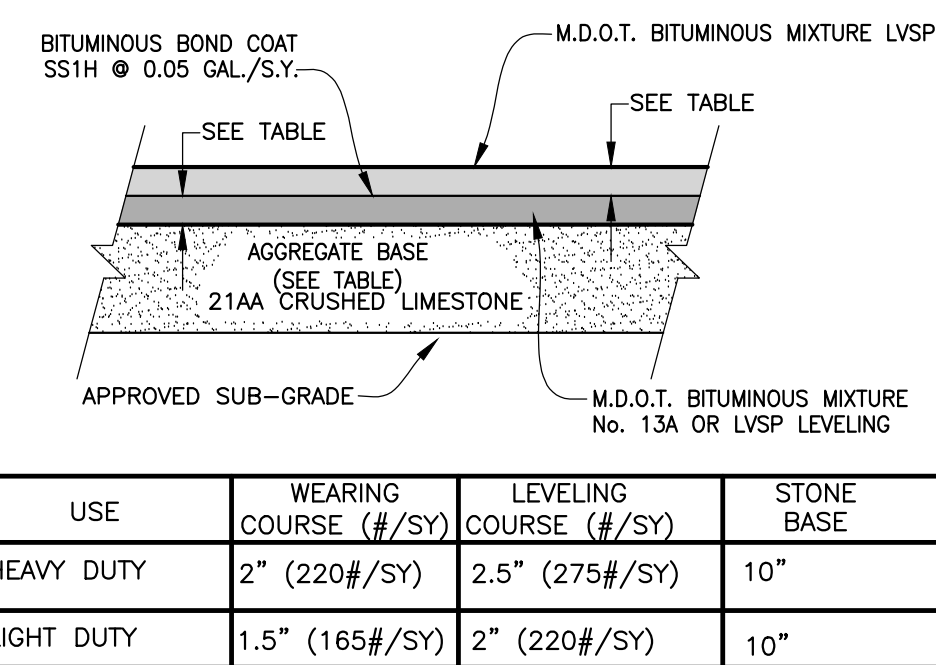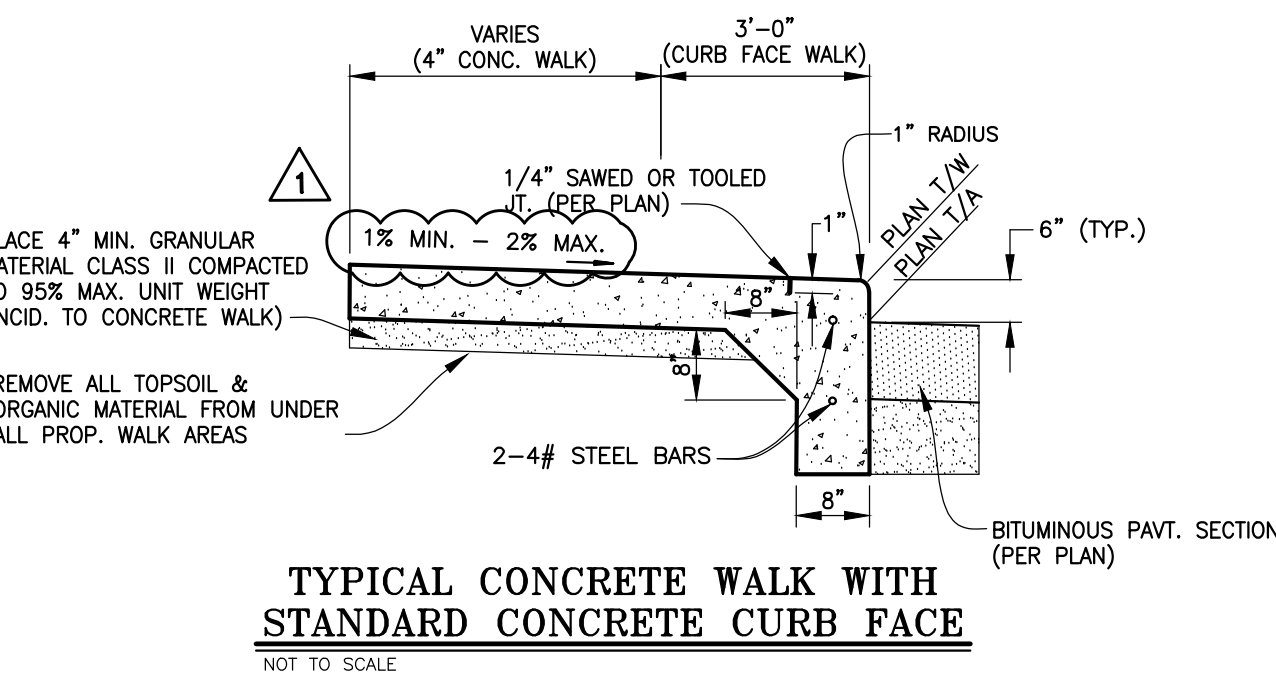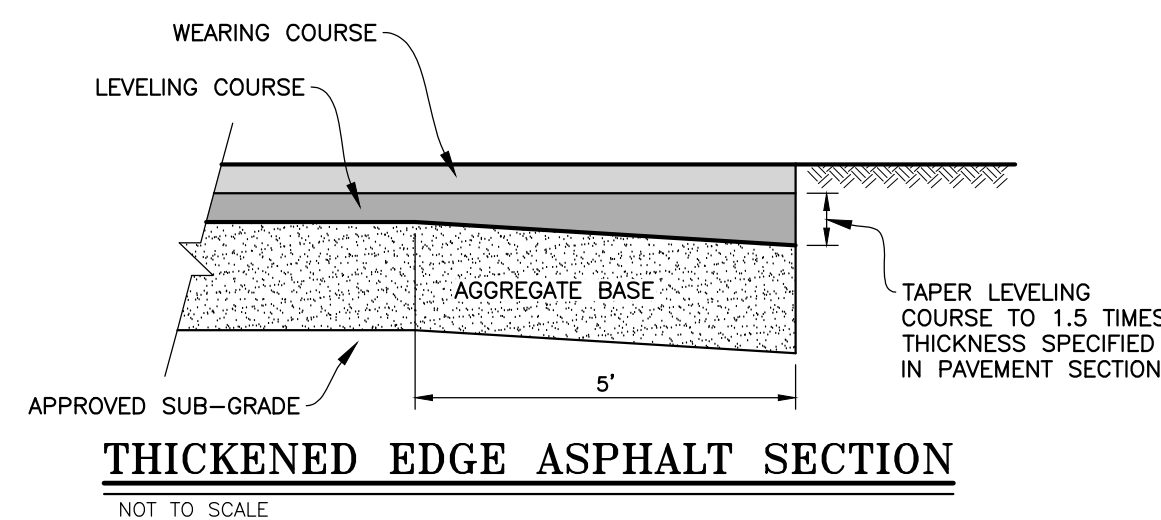


### ASPHALT PAVEMENT SECTION

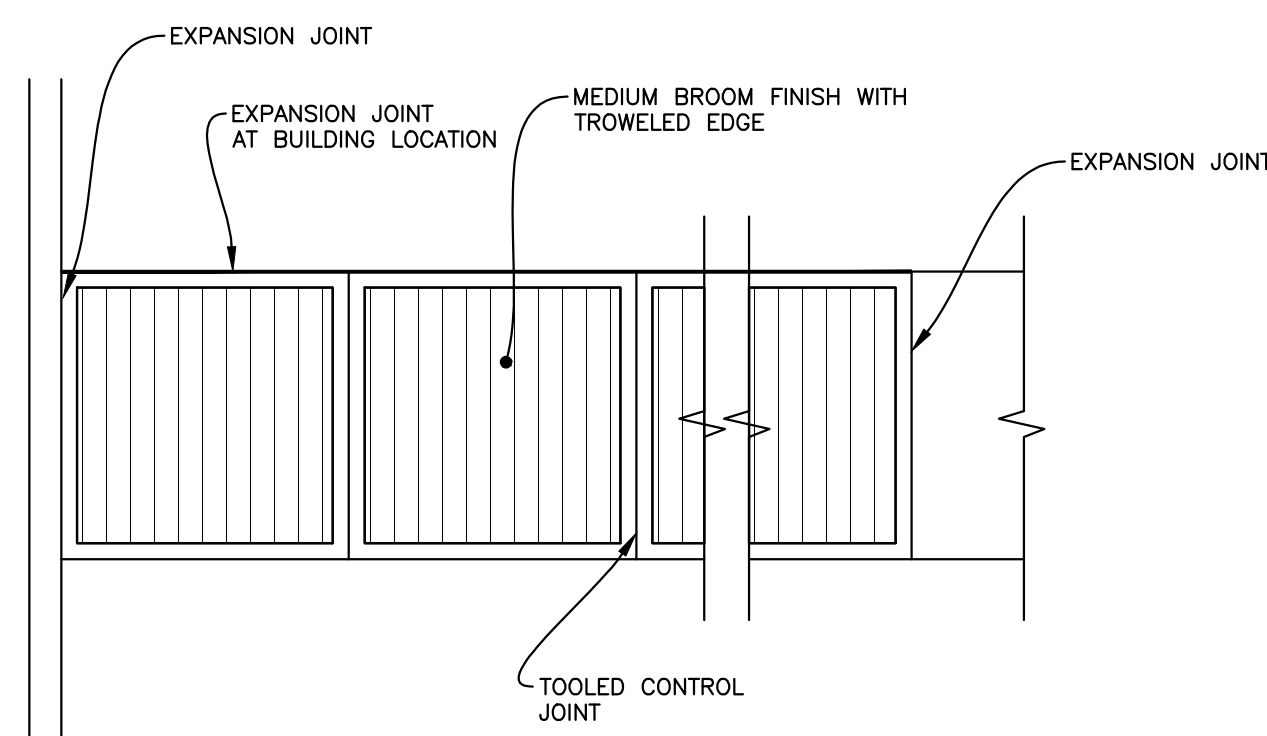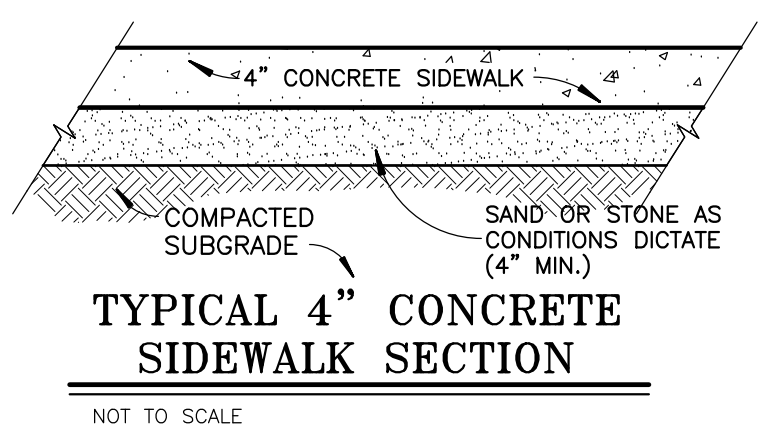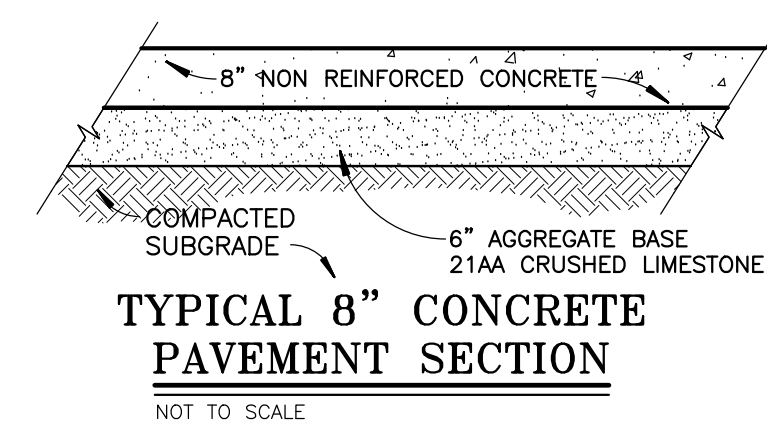

NOTE: PAVING CONTRACTOR TO JOINT  
PAVEMENT AS PER INDUSTRY STANDARDS

### TYPICAL SIDEWALK JOINTING AND FINISH

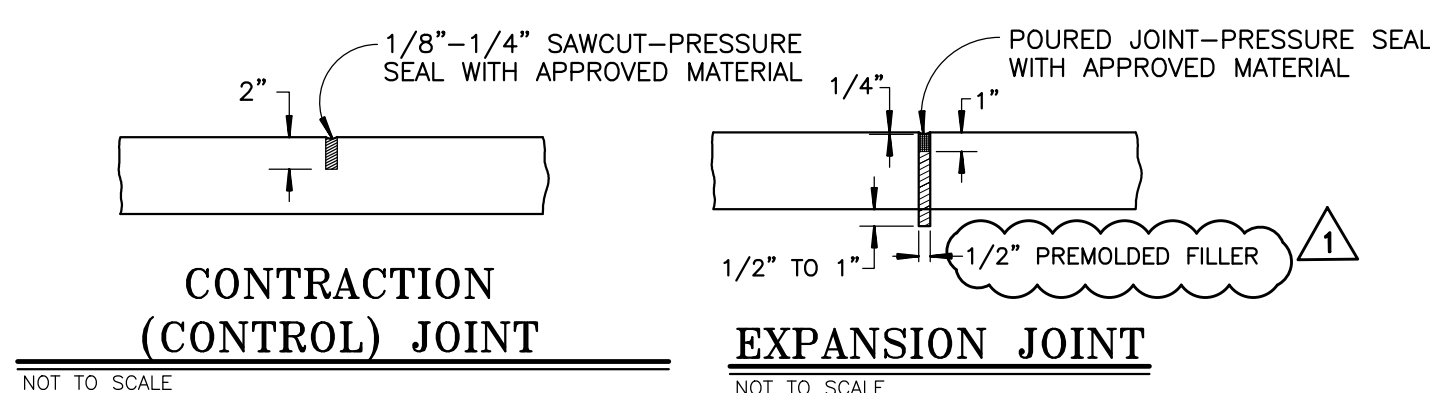

CONTRACTION  
(CONTROL) JOINT

## EXPANSION JOINT










30500 VAN DYKE AVENUE  
SUITE M-7  
WARREN, MICHIGAN 48093  
PH: 586.573.4100  
FX: 586.573.0822  
[www.wakeyala.com](http://www.wakeyala.com)




AEW NO. 0577-0074

JOIST SCHEDULE		
MARK	SIZE	NOTES
J1	18x5	BASE BID AND ALTERNATE - CARRIED TOP + BOTTOM CHORDS
J1A	18x5	BASE BID - CARRIED TOP + BOTTOM CHORDS ALTERNATE - CARRIED TOP STRUCTION BOTTOM

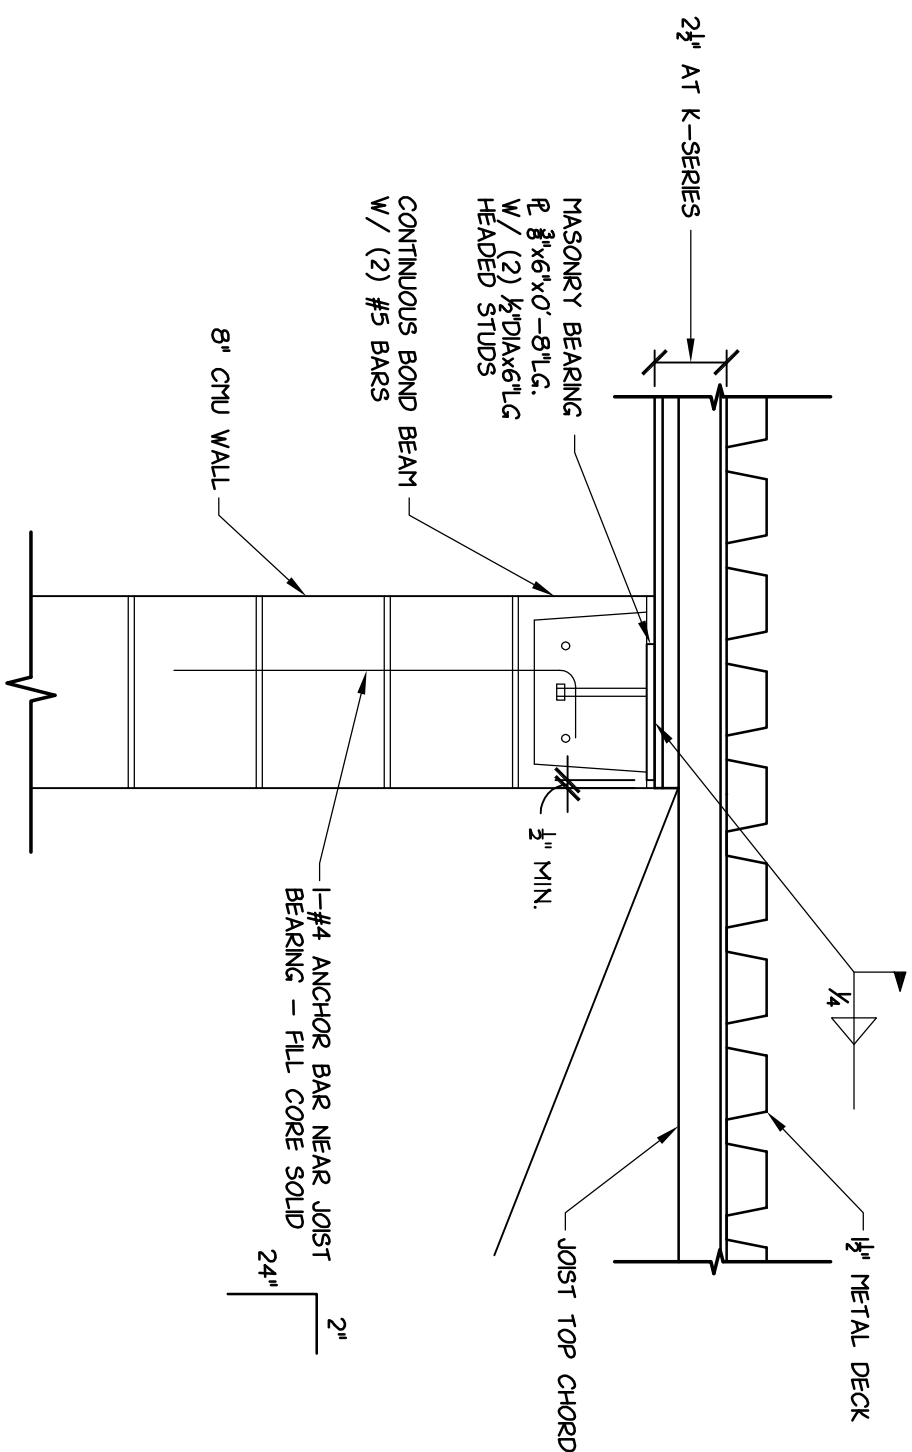


### TYPICAL JOIST BEARING PLATE DETAIL

SCALE: 1" = 1'-0"

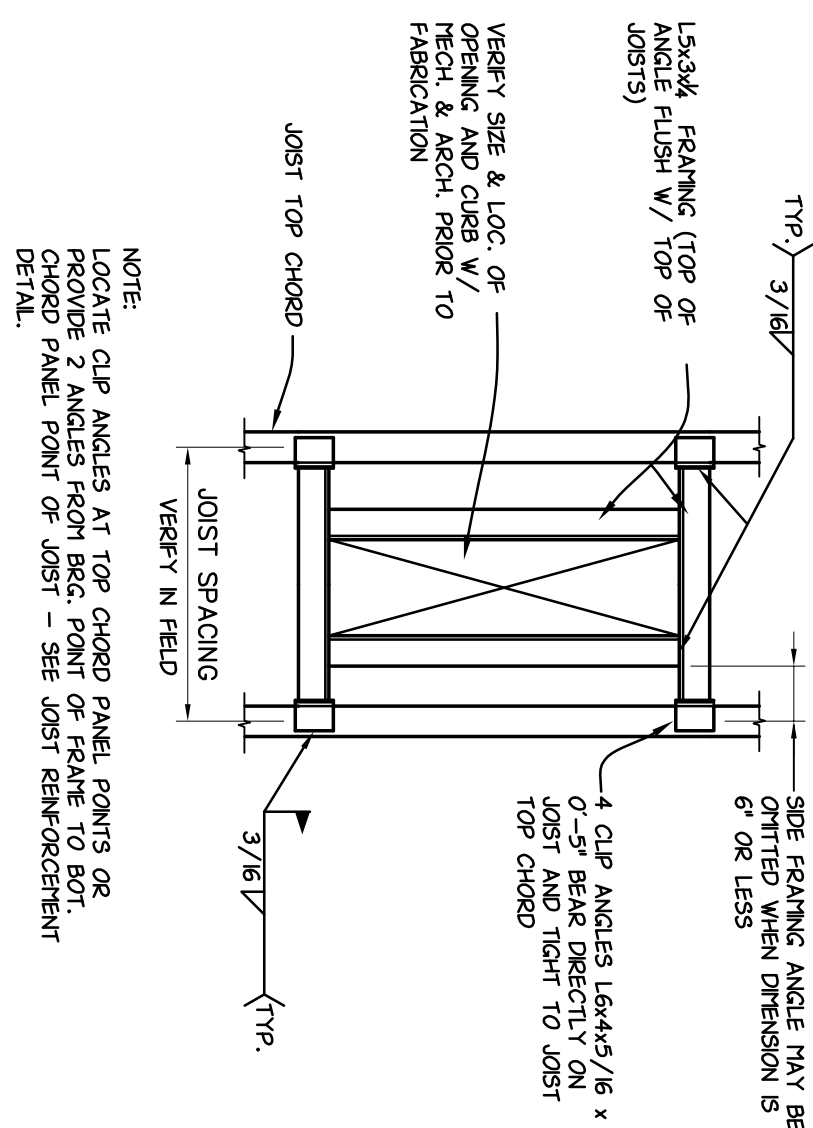

## TYPICAL CURB FRAMING DETAIL


SCALE: N.T.S.

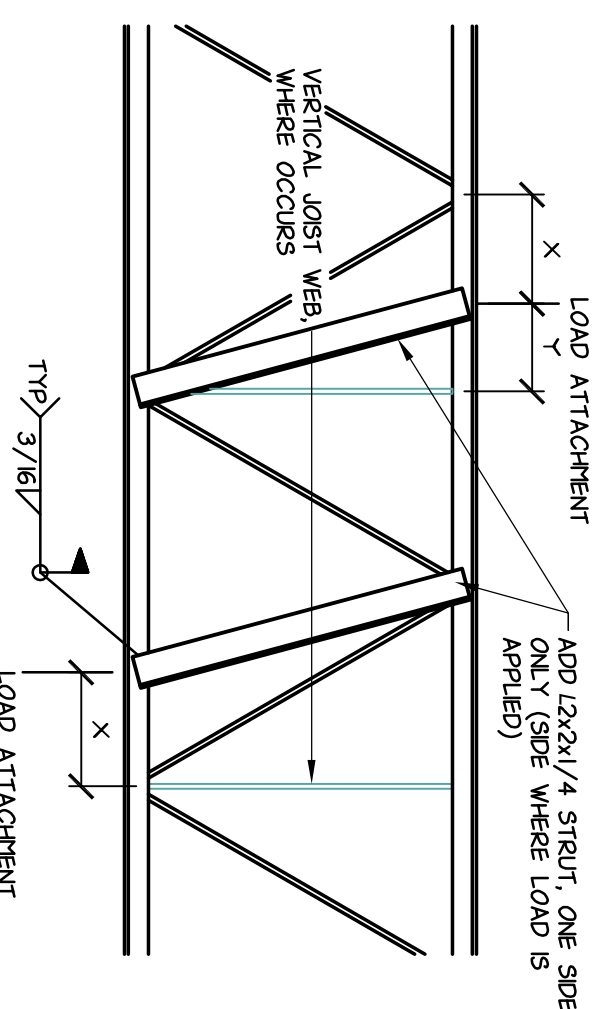

1. AN ADDITIONAL SUPPLEMENTAL STRUT MUST BE INSTALLED IN STEEL JOISTS AT ALL CONCENTRATED LOADS IN EXCESS OF 50 LBS. UNLESS THE LOAD ATTACHMENT IS AT A PANEL POINT OF THE JOIST.
2. AN ADDITIONAL STRUT IS NOT REQUIRED IF "X" OR "Y" IS LESS THAN OR EQUAL TO 6'.
3. CONCENTRATED LOADS GREATER THAN 250 LBS, WHICH ARE NOT SPECIFIED ON THE PLANS, ARE NOT PERMITTED WITHOUT REVIEW BY THE PROFESSIONAL-OF-RECORD.


### TYPICAL JOIST REINFORCEMENT DETAIL

SCALE: N.T.S

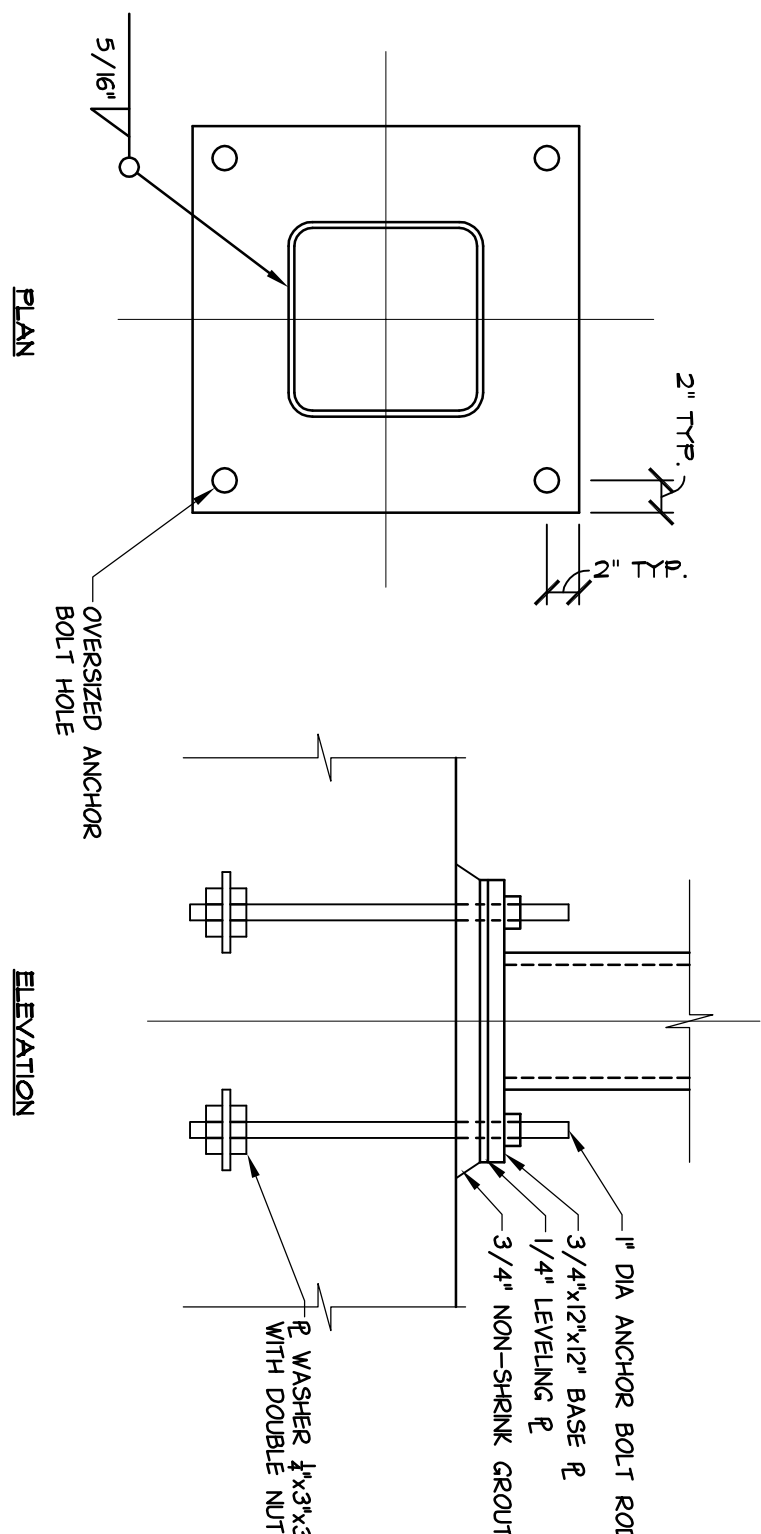


**TYPICAL COLUMN BASE PLATE DETAIL**  
SCALE: NOT TO SCALE

SCALE: NOT TO SCALE

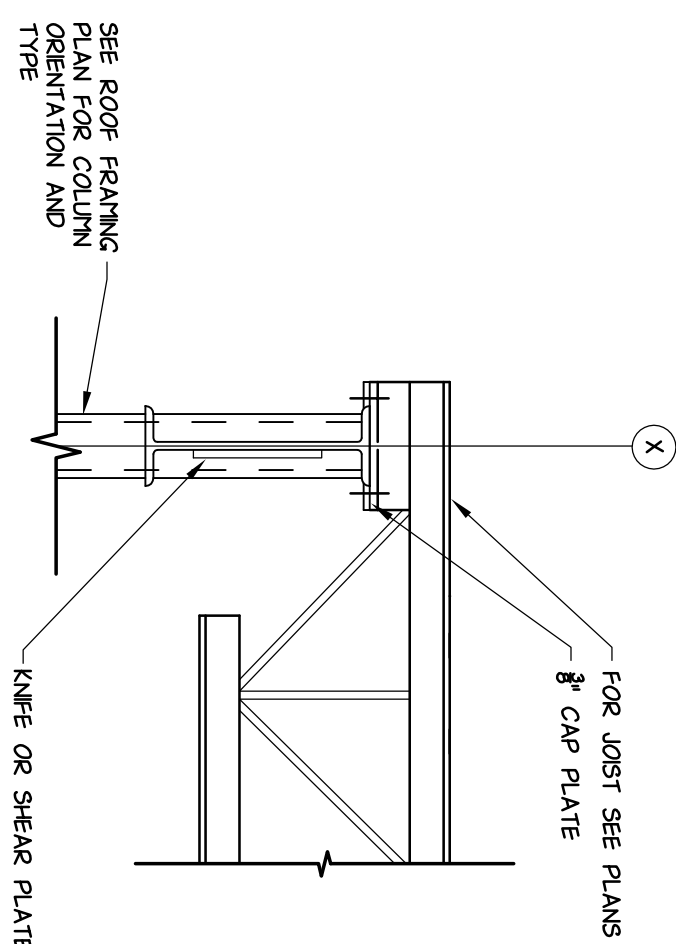


**TYPICAL JOIST / BEAM TO COL. CONN. DETAIL**

SCALE: 1" = 1'-0"

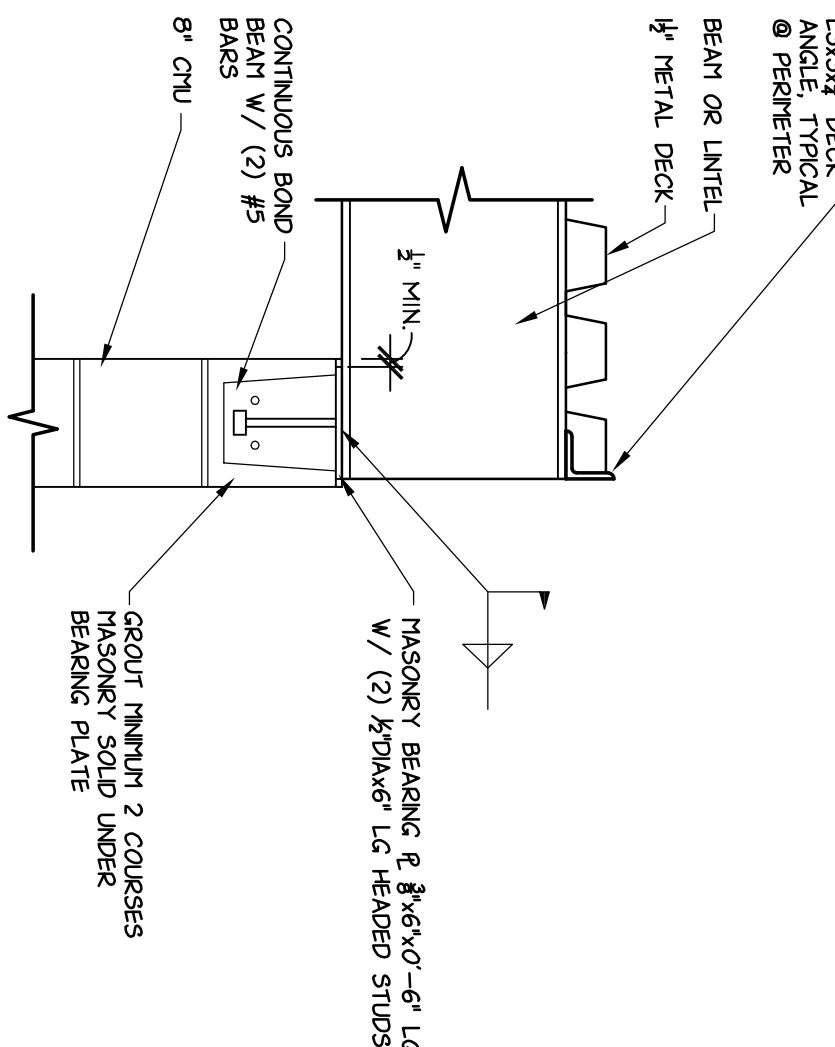

## TYPICAL BEAM / LINTEL BEARING PLATE DETAIL

SCALE: 1" = 1'-0"

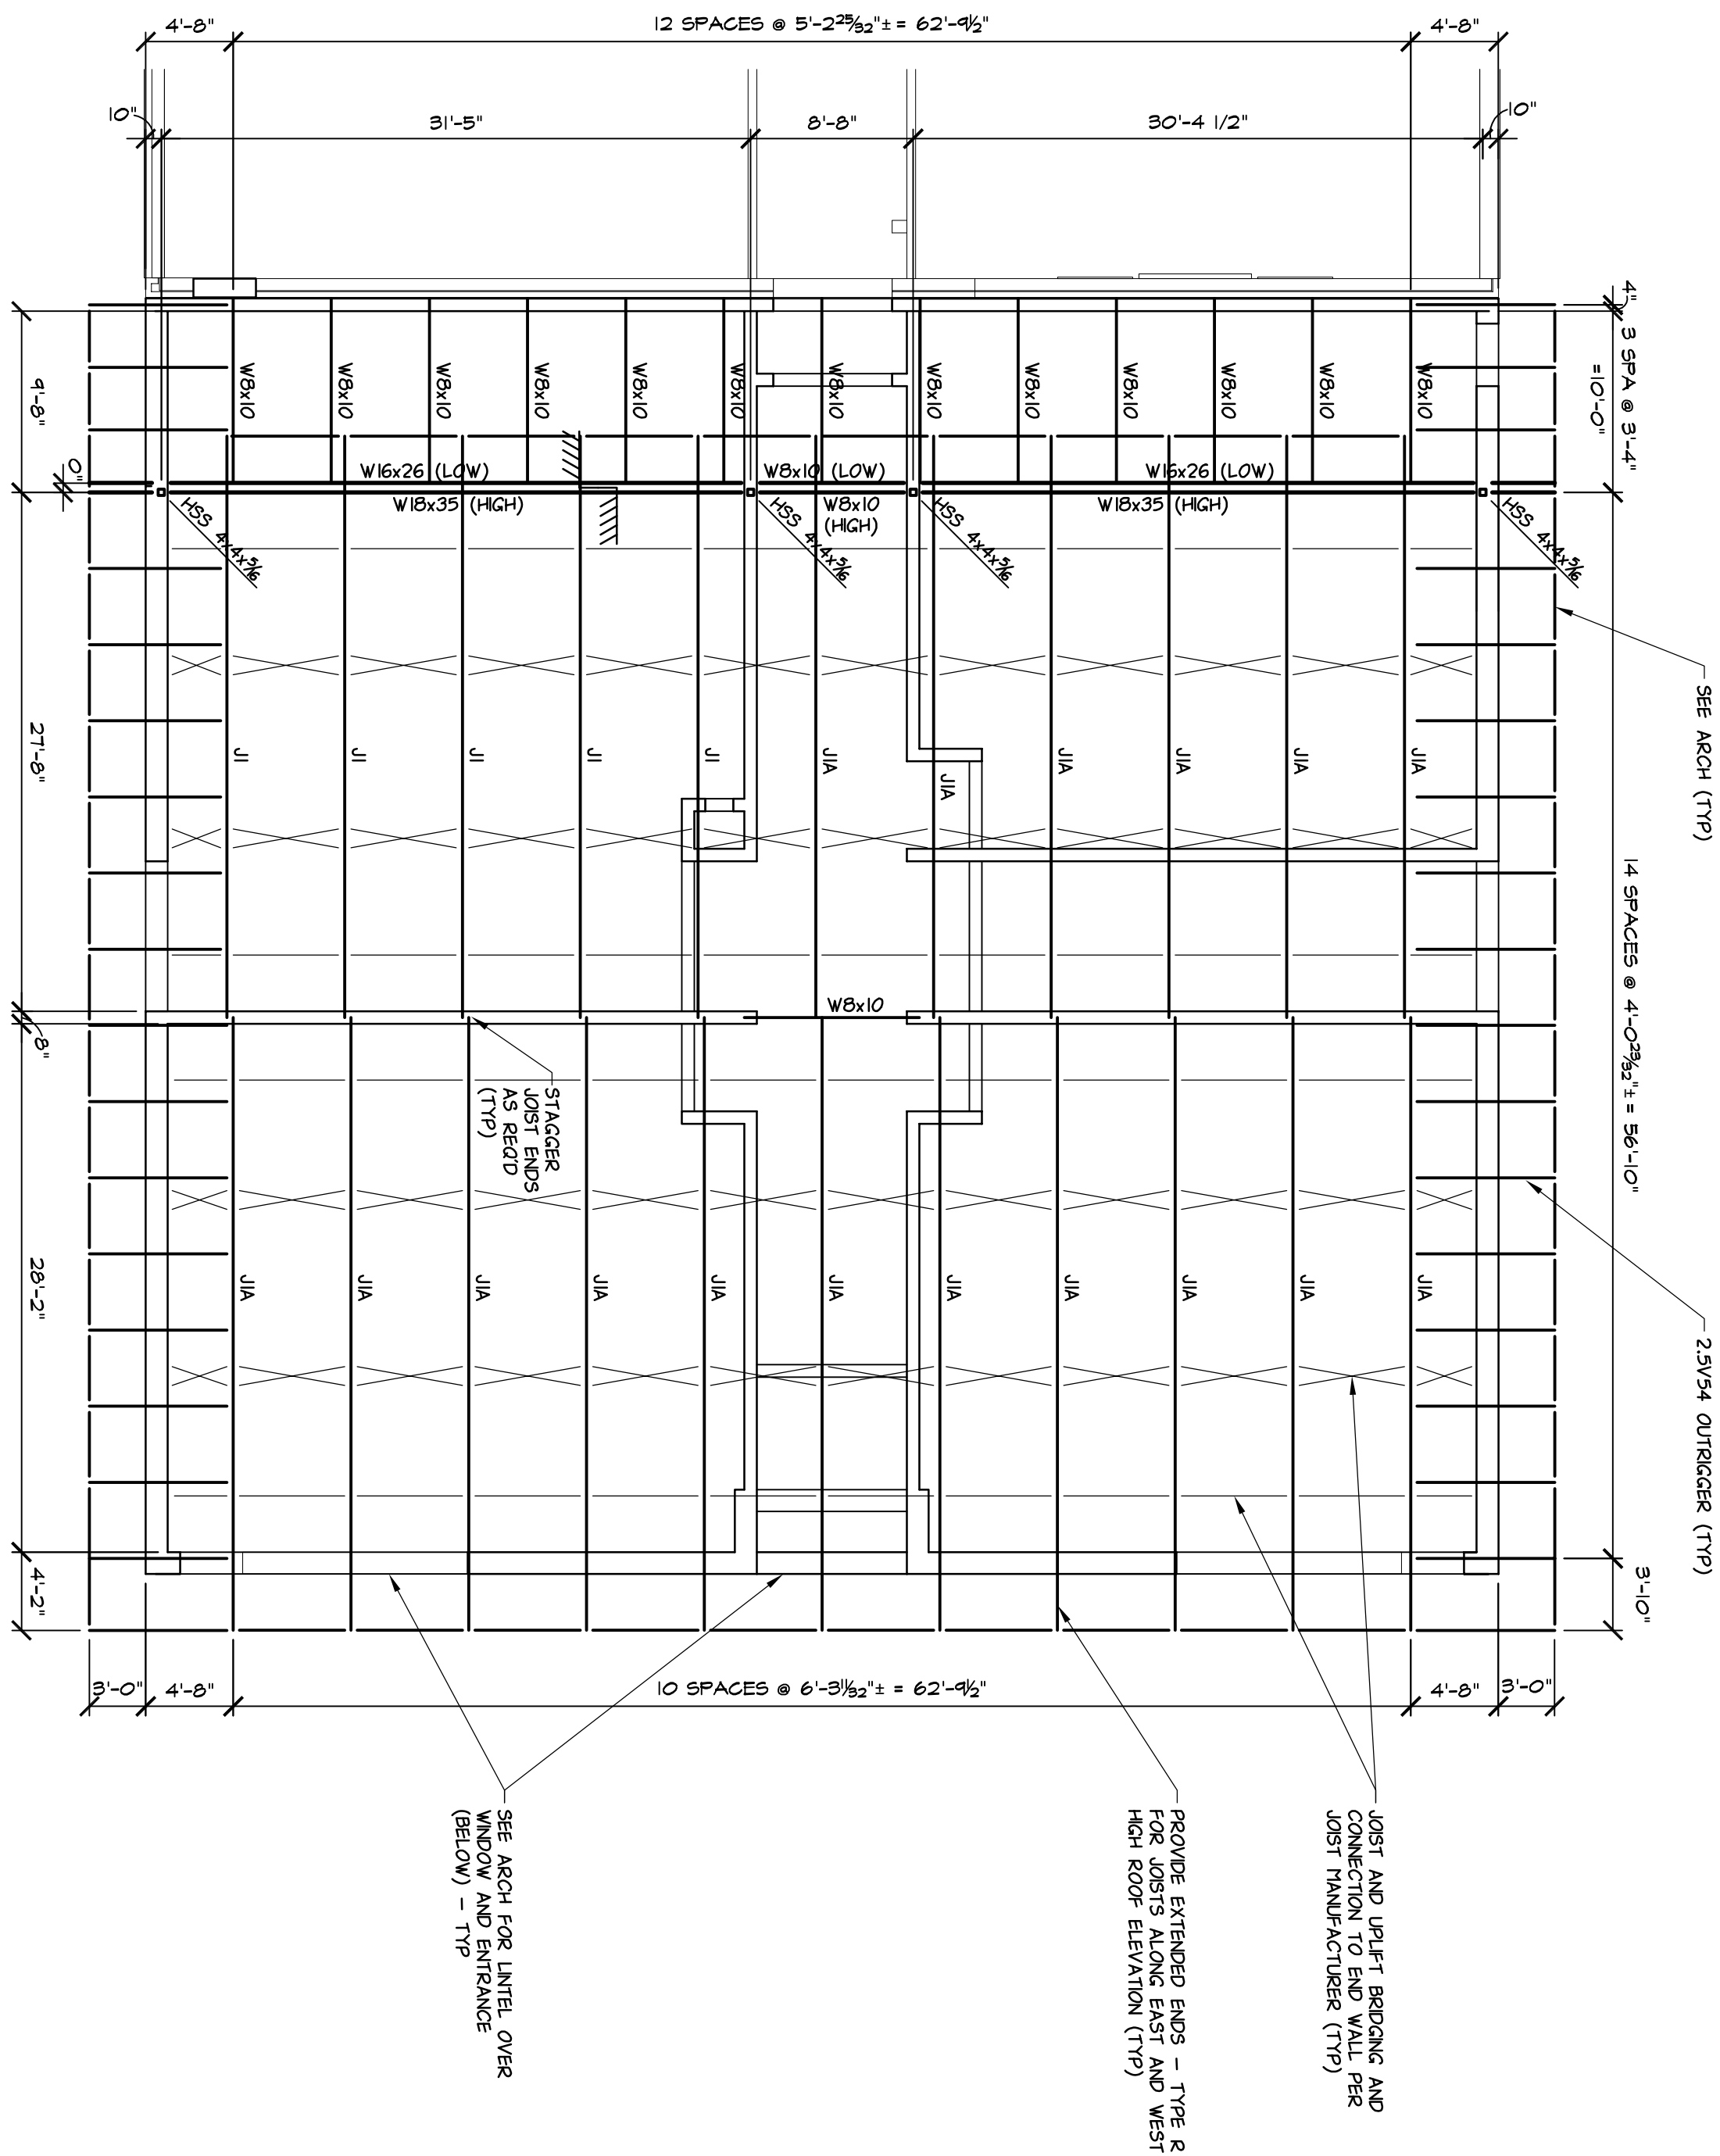

## PARTIAL ROOF FRAMING PLAN

SCALE: 1/8" = 1'-0"

1. ALL MEMBERS ARE EQUALLY SPACED, UNLESS NOTED OTHERWISE.
2. ALL ROOF DECK IS 4" WIDE RIB 30 GAUGE GALVANIZED AND CONTINUOUS OVER A MINIMUM OF THREE SPANS.
3. ALL C/W TO BE REINFORCED W/ # 32 C.C. VERT. REINFORCEMENT - SEE MASONRY NOTES ON SH 52.0 FOR ADD'L REQUIREMENTS.
4. SEE TYPICAL BEAM AND JOIST BEARING PLATE DETAILS ON SHEET FOR BEARING PLATE SIZES.
5. SEE ARCH FOR 7.05. ELEVATIONS, JOIST CHORD RADIUS AND C/W BOND BEAM LOCATIONS.