

#### **ADDENDUM**

Project: Crestwood School District

**Cherry Hill Baptist Church** 

**Administration Relocation and Addition** 

Project No.: 3221

Date: August 17, 2023

Addendum Number: #004

Each Bidder's proposal amount shall include the work described herein.

This Addendum is hereby made a part of the Contract Documents. Unless otherwise indicated, the work described herein shall comply with, and be equal in all respects to the original Specification and Drawings accompanying same. Include incidental work required to properly complete the work, whether stated herein or not.

#### **ARCHITECTURAL DRAWING REVISIONS**

#### TTL - Title Page

ADD: A3.53 Building Sections – Alternate #1

#### A2.10 - Composite Floor Plan

**ADD**: Structural column at canopy to align with structural drawings

**DELETE**: Plastic laminate reception desk gate. **REVISE**: Existing Breakroom 111 door swing.

**REVISE**: Storage 127 to Closet 127.

**REVISE**: Portal doors at Existing Multi-Purpose 149.

**REVISE**: Portal doors at Corridor C 142.

#### A2.11 - Floor Plan (Area A)

**ADD**: Note 29 – "Patch and repair walls at removed frame."

ADD: Note tags to drawing sheet A2.11
ADD: Drawing Note 30 as indicated.
DELETE: Plastic laminate reception desk gate.
REVISE: Existing Breakroom 111 door swing.

**REVISE**: Storage 127 to Closet 127. **REVISE**: Portal doors at Corridor C 142.

**REVISE**: Door tag 106a to 106.

#### A2.12 - Floor Plan (Area B)

**REVISE**: Portal doors at Existing Multi-Purpose 149.

**REVISE**: Portal doors at Corridor C 142.

#### A2.13 - Dimension Plan (Area A)

**DELETE**: Plastic laminate reception desk gate. **REVISE**: Existing Breakroom 111 door swing. **REVISE**: Portal doors at Corridor C 142.



**REVISE**: Portal doors at Existing Multi-Purpose 149.

**REVISE**: Portal doors at Corridor C 142.

A2.61 - Door Schedule

ADD: General Storefront Notes GS1, GS2, GS3, GS4, GS5, GS6, & GS7 as indicated.

A3.00 - Exterior Elevations

ADD: Structural column at canopy to align with structural drawings.

**ADD**: Drawing Note 25 as indicated.

**ADD**: Note tags as indicated to drawings sheet A3.00.

A5.02 – Interior Elevations

CHANGE: Note 37

FROM: Plastic laminate entry gate with self-closing continuous hinge and self-latching

hardware. Refer to materials schedule.

TO: Not used.

DELETE: 8/A5.02 Plastic laminate reception desk gate.
DELETE: 10/A5.02 Plastic laminate reception desk gate.

A6.10 - Reflected Ceiling Plan

**REVISE**: A6.10 Graphically change the reflected ceiling plan to align with electrical drawings.

**REVISE**: Storage 127 to Closet 127.

A9.00 - Exterior Wall Sections

**CHANGE**: 2/A9.00

**FROM**: Graphically shown fixed window. **TO**: Graphically shown operable window.

**REVISE**: A9.00 Graphically change the lintels to align with structural drawings.

<u>A9.10 – Exterior Details</u>

**REVISE**: 3/A9.10 Graphically change the window sill profile. **REVISE**: 4/A9.10 Graphically change the window head profile.

**REVISE**: A9.10 Graphically change the lintels to align with structural drawings.

A9.11 - Exterior Details

**REVISE**: A9.11 Graphically change the lintels to align with structural drawings.

<u>A9.12 – Exterior Details</u>

**REVISE**: A9.12 Graphically change the lintels to align with structural drawings.

**ADD**: Drawing Note 33 as indicated.

**ADD**: Note tags as indicated to drawings sheet A9.12.

A9.60 – Interior Details

**REVISE**: A9.60 Graphically change the lintels to align with structural drawings.

A9.65 - Interior Details

**REVISE**: A9.65 Graphically change the lintels to align with structural drawings.

CHANGE: Note 9

**FROM**: 5" x 5" brick angle to support existing to remain brick above portal wall. **TO**: Structural support for existing brick - Refer to structural drawings.



#### <u>A9.66 - Interior Details</u>

**REVISE**: A9.66 Graphically change the lintels to align with structural drawings.

CHANGE: Note 9

**FROM**: 5" x 5" brick angle to support existing to remain brick above portal wall. **TO**: Structural support for existing brick - Refer to structural drawings.

#### **TECHNOLOGY DRAWING REVISIONS**

#### T2.11 - Structured Cabling System Floor Plan (Part A)

**ADD**: Existing Mechanical 138: Add two (2) category 6 data cables.

ADD: Add Key Note 4 to Structured Cabling Notes.

ADD: Reception 145: Add one (1) category 6 data cable.

ADD: Add Key Note 5 to Structured Cabling Notes.

#### T2.12 – Structured Cabling System Floor Plan (Part B)

**ADD**: Workroom 152: Add one (1) category 6 data cable.

#### **SPECIFICATION REVISIONS**

#### Section 00 0115 List of Drawings

ADD: A3.53 Building Sections – Alternate #1

#### Section 08 0671 Door Hardware Schedule

**ADD:** Section to project manual

#### Section 08 1113 Hollow Metal Doors and Frames

2.04 Hollow Metal Frames

**ADD**: E. Mullions for Pairs of Doors: Removeable type, with profile similar to jambs.

#### Section 08 7100 Door Hardware

Part 2 Products

**ADD:** Items highlighted within the specification section.

#### **GENERAL**

#### RFI Questions and Answers

RFI Question 18: Will there be a hardware set schedule for this project? Please confirm.

RFI Answer 18: Yes, please refer to attached Spec Section 08 0671 Door Hardware Schedule with this

Addendum.

RFI Question 19: Would you happen to know if this is S2 netbox or Lenel onguard?

RFI Answer 19: NetBox

RFI Question 20: Does the S2 system connect to the districts Netbox system?

RFI Answer 20: It will connect to the district-wide system via a leased data circuit.



RFI Question 21: Do you have enough room to accommodate these portals for access control?

RFI Answer 21: No. This is a completely new system in a new building to the district. All equipment

required to support the building shall be included with connection to the district-wide

management system.

RFI Question 22: Are all door contacts going to be connected to the access control system or a

separate intrusion system?

RFI Answer 22: All door contacts will be connected to the access control system with the ability to

send alarms to the district personnel and to an alarm monitoring service provider.

RFI Question 23: I am not sure who to reach out to in regards to seeing if there is the possibility of an

alternative option being approved. I reached out to Axiom but they stated I needed to put in a request. Cameras Alternate-Digital Watchdog. Access Control Alternate-Pro

Data Key.

RFI Answer 23: Due to the existing investments and established district standards, no alternates are

being considered for the cameras or access control.

# Crestwood School District Cherry Hill Baptist Church

# Administration Relocation and Addition

Crestwood School District 1045 North Gulley Rd. Dearborn, MI, 48127

Contact Name: Penny Morgan, CFO Contact Phone: (313) 278-2349

# ARCHITECT:





LANDSCAPE ARCHITECT:



**CIVIL ENGINEER:** 



STRUCTURAL ENGINEER:



MECH. / ELECT. ENGINEER:



TECHNOLOGY CONSULTANT





# LOCATION PLAN



# APPLICABLE CODES:

MICHIGAN REHABILITATION CODE FOR EXISTING BUILDINGS:	2015 EDITION
MICHIGAN BUILDING CODE:	2015 EDITION
MICHIGAN PLUMBING CODE:	2018 EDITION
MICHIGAN MECHANICAL CODE:	2015 EDITION
NATIONAL ELECTRIC CODE (WITH MICHIGAN PART 8 RULES):	2017 EDITION
MICHIGAN UNIFORM ENERGY CODE:	2015 EDITION
ASHRAE 90.1-2013:	
LIFE SAFETY CODE 101:	2012 EDITION
FEDERAL ADA LAW:	CURRENT E
ACCESSIBLE AND USABLE BUILDINGS & FACILITIES (ANSI A117.1):	2009 EDITION
LICENSING RULES FOR CHILD CARE CENTERS	2019 EDITION
REHABILITATION CODE	

# **USE GROUP:**

EXISTING USE: A-3 RELIGIOUS & I-4 CHILDCARE NEW USE: B BUSINESS & I-4 CHILDCARE


# ZONING DISTRICT:

R-1 SINGLE FAMILY RESIDENTIAL

# **CONSTRUCTION TYPE:** III-B, NOT SPRINKLED

# TOTAL FLOOR AREA:

EXISTING FLOOR AREA: 17,711 SF ADDITION FLOOR AREA: 8.905 SF TOTAL FLOOR AREA: 26,616 SF (GROSS FLOOR AREA)

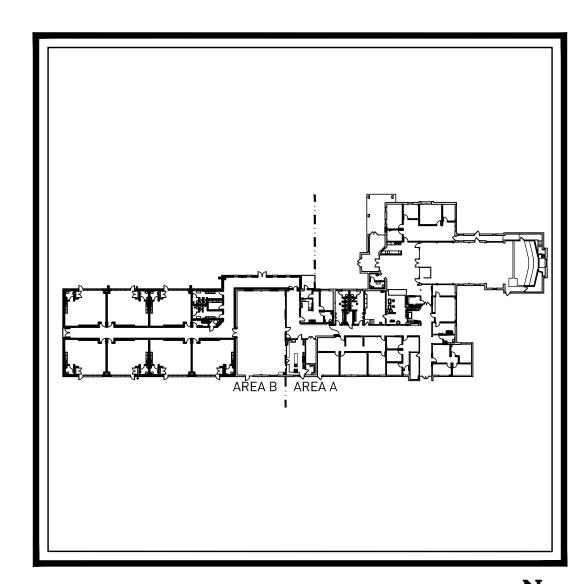

# BUILDING KEY PLAN

# **BUILDING HEIGHT:**

EXISTING: ± 19'-3" TO MIDPOINT OF HIGHEST SLOPE ADDITION: ± 15'-0" TO TOP OF PARAPET

# **DEFERRED SUBMITTALS:**

PER SECTION 107.3.4.1, ANY REQUIRED SUBMITTALS WILL BE SUBMITTED TO THE AUTHORITY HAVING JURISDICTION BY THE REGISTERED DESIGN PROFESSIONAL IN RESPONSIBLE CHARGE ASSUMING THE DUTIES OF CONSTRUCTION SUPERVISION AT THE APPROPRIATE TIME.

FIRE ALARM SYSTEMS

# LIST OF ALTERNATES:

ALTERNATE #1: BOARD ROOM IMPROVEMENTS THE PORTION OF WORK TO BE ADDED TO THE BASE PROPOSAL INCLUDES THE FOLLOWING. ALL FINISHES, MECHANICAL, ELECTRICAL, AND TECHNOLOGY WORK AS INDICATED ON THE DRAWINGS TO IMPROVE THE BOARD ROOM. CONTRACTOR TO REFER TO DRAWINGS AND / OR SPECIFICATIONS FOR FURTHER INFORMATION.

	NICAL DRAWINGS:
M0.01	MECHANICAL STANDARDS AND DRAWING INDEX
MD2.11	PLUMBING DEMOLITION PLAN (PART A)
MD3.11	HVAC PIPING DEMOLITION PLAN (PART A)
MD3.12	HVAC PIPING DEMOLITION PLAN (PART B)
MD4.11	SHEET METAL DEMOLITION PLAN (PART A)
MD4.12	SHEET METAL DEMOLITION PLAN (PART B
M2.01	UNDERGROUND PLUMBING PLAN (PART A)
M2.02	UNDERGROUND PLUMBING PLAN (PART B)
M2.11	PLUMBING PLAN (PART A)
M2.12	PLUMBING PLAN (PART B)
M3.11	HVAC PIPING PLAN (PART A)
M3.12	HVAC PIPING PLAN (PART B)
M4.11	REFRIGERANT PIPING PLAN (PART A)
M4.12	REFRIGERANT PIPING PLAN (PART B)
M5.11	SHEET METAL PLAN (PART A)
M5.11-ALT	SHEET METAL PLAN (PART A) - ALTERNATE
M5.12	SHEET METAL PLAN (PART B)
M6.01	MECHANICAL DETAILS
M6.02	MECHANICAL DETAILS
M6.03	MECHANICAL DETAILS
M6.04	MECHANICAL DETAILS
M6.05	MECHANICAL DETAILS
M7.01	MECHANICAL SCHEDULES
M7.02 M7.03	MECHANICAL SCHEDULES MECHANICAL SCHEDULES
M7.03	MECHANICAL SCHEDULES MECHANICAL SCHEDULES
M7.05	MECHANICAL SCHEDULES
M8.01	TEMPERATURE CONTROL STANDARDS AND GENERAL NOTE
M8.02	TEMPERATURE CONTROLS
M8.03	TEMPERATURE CONTROLS
M8.04	TEMPERATURE CONTROLS
M8.05	TEMPERATURE CONTROLS

ELECTR	TCAL DRAWINGS:
E0.01	ELECTRICAL STANDARDS AND DRAWING INDEX
E0.02	ELECTRICAL STANDARD SCHEDULES
ED0.03	ELECTRICAL SITE DEMOLITION PLAN
E0.03	ELECTRICAL SITE NEW WORK PLAN
E0.04	ELECTRICAL COMPOSITE PLAN
ED1.11	ELECTRICAL DEMOLITION PLAN (PART A)
ED1.12	ELECTRICAL DEMOLITION PLAN (PART B)
E2.11	LIGHTING PLAN (PART A)
E2.12	LIGHTING PLAN (PART B)
E3.11	POWER PLAN (PART A)
E3.12	POWER PLAN (PART B)
E5.01	ONE LINE DIAGRAM
E5.02	PANEL SCHEDULES
EE 0.3	DANIEL COLLEDIU EC

TECHN	OLOGY DRAWINGS:
T2.10	STRUCTURED CABLING SYSTEM COMPOSITE FLOOR F
T2.11	STRUCTURED CABLING SYSTEM FLOOR PLAN (PART A
T2.12	STRUCTURED CABLING SYSTEM FLOOR PLAN (PART E
T7.01	STRUCTURED CABLING SYSTEM DETAILS
TP2.10	PUBLIC ADDRESS SYSTEM COMPOSITE FLOOR PLAN
TP2.11	PUBLIC ADDRESS SYSTEM FLOOR PLAN (PART A)
TP2.12	PUBLIC ADDRESS SYSTEM FLOOR PLAN (PART B)
TY2.10	SECURITY SYSTEMS COMPOSITE FLOOR PLAN
TY2.11	SECURITY SYSTEMS FLOOR PLAN (PART A)
TY2 12	SECURITY SYSTEMS FLOOR PLAN (PART B)

SECURITY SYSTEMS DETAILS

# LIST OF DRAWINGS


<u>S</u>	LIS	STOF DRAWINGS
X	TTL A0.00 A0.01	TITLE SHEET GENERAL INFORMATION CODE REVIEW PLAN
	A0.05 A0.06	COMPOSITE PHASING PLAN PHASE 1
	A0.07 A0.08	
		EY DRAWINGS:  TOPOGRAPHICAL SURVEY  TOPOGRAPHICAL SURVEY
	CIVIL C1.0	DRAWINGS:  GENERAL PLAN
	C2.1 C3.1 C4.1	DEMOLITION PLAN UTILITY PLAN PAVING AND LAYOUT PLAN
	C5.1 C6.1	GRADING PLAN SOIL EROSION AND SEDIMENTATION CONTROL PLAN
	L.101	SCAPE DRAWINGS:  SITE LANDSCAPE PLAN
	L.102 L.301 L.302	
NERAL NOTES	L.601 L.602 L.603	SITE LANDSCAPE PLAN - SPECIFICATIONS SITE LANDSCAPE PLAN - SPECIFICATIONS SITE LANDSCAPE PLAN - SPECIFICATIONS
	STRU( S0.01	CTURAL DRAWINGS:  GENERAL STRUCTURAL NOTES
	S0.02 S0.03 S2.01	SPECIAL INSPECTION SCHEDULES LOAD MAPS
	S2.10 S2.11 S3.00	FOUNDATION PLAN ROOF FRAMING PLAN TYPICAL CONCRETE SECTIONS
	S4.00 S4.01 S6.00	TYPICAL MASONRY SECTIONS TYPICAL MASONRY SECTIONS TYPICAL STEEL DETAILS
	S6.01 S7.00 S7.01	TYPICAL STEEL DETAILS SECTIONS AND DETAILS SECTIONS AND DETAILS
	A0.11	ITECTURAL DRAWINGS:  ARCHITECTURAL SITE PLAN
	A0.12 A1.10	DUMPSTER ENCLOSURE PLAN & DETAILS  REMOVALS COMPOSITE PLAN  REMOVALS COMPOSITE PLAN
	A1.11 A1.12 A1.13	REMOVALS FLOOR PLAN (AREA A) REMOVALS FLOOR PLAN (AREA B) REMOVALS CEILING PLAN (AREA A)
	A1.14 A1.15 A1.16	REMOVALS CEILING PLAN (AREA B) REMOVALS ELEVATIONS REMOVALS ELEVATIONS
OOR PLAN PART A) PART B)	A2.10 A2.11	COMPOSITE FLOOR PLAN FLOOR PLAN (AREA A)
PLAN A)	A2.12 A2.13 A2.14	FLOOR PLAN (AREA B) DIMENSION PLAN (AREA A) DIMENSION PLAN (AREA B)
3)	A2.50	COMPOSITE ROOF PLAN
	A2.60 A2.61	DOOR SCHEDULE DOOR SCHEDULE
	A2.80 A3.00	CABINET SCHEDULE/DETAILS  EXTERIOR ELEVATIONS
	A3.01 A3.02 A3.03	EXTERIOR ELEVATIONS EXTERIOR ELEVATIONS EXTERIOR ELEVATIONS
	A3.50 A3.51	BUILDING SECTIONS BUILDING SECTIONS
2	A3.52 A3.53	BUILDING SECTIONS - ALTERNATE #1
	A4.00 A4.01	ENLARGED FLOOR PLANS (RESTROOMS) ENLARGED FLOOR PLANS
	A5.00 A5.01 A5.02 A5.03	INTERIOR ELEVATIONS INTERIOR ELEVATIONS INTERIOR ELEVATIONS INTERIOR ELEVATIONS
	A6.10	COMPOSITE RCP
	A8.10 A8.11 A8.12	COMPOSITE FINISH PLAN FINISH PLAN (AREA A) FINISH PLAN (AREA B)
	A8.50 A8.51 A8.52	ROOM FINISH SCHEDULES MATERIAL SCHEDULE WALL AND FLOOR TILE DETAILS
	A9.00 A9.01	EXTERIOR WALL SECTIONS EXTERIOR WALL SECTIONS
	A9.02 A9.03	EXTERIOR WALL SECTIONS EXTERIOR WALL SECTIONS
	A9.10 A9.11 A9.12	EXTERIOR DETAILS EXTERIOR DETAILS EXTERIOR DETAILS
	A9.13 A9.14	EXTERIOR DETAILS STANDARD EXTERIOR DETAILS
	A9.50 A9.51 A9.52 A9.55	INTERIOR WALL SECTIONS INTERIOR WALL SECTIONS INTERIOR WALL SECTIONS PORTAL WALL SECTIONS
	A9.60 A9.61 A9.62	INTERIOR DETAILS INTERIOR DETAILS INTERIOR DETAILS Addendum #4: 17 August 202 Addendum #3: 16 August 202
	A9.65 A9.66	PORTAL A DETAILS PORTAL B DETAILS Bidding and Permits: 31 July 202
		- <i>,</i>

Title Sheet



Crestwood School District Cherry Hill Baptist Church Administration Relocation and Addition

Project No. 3221

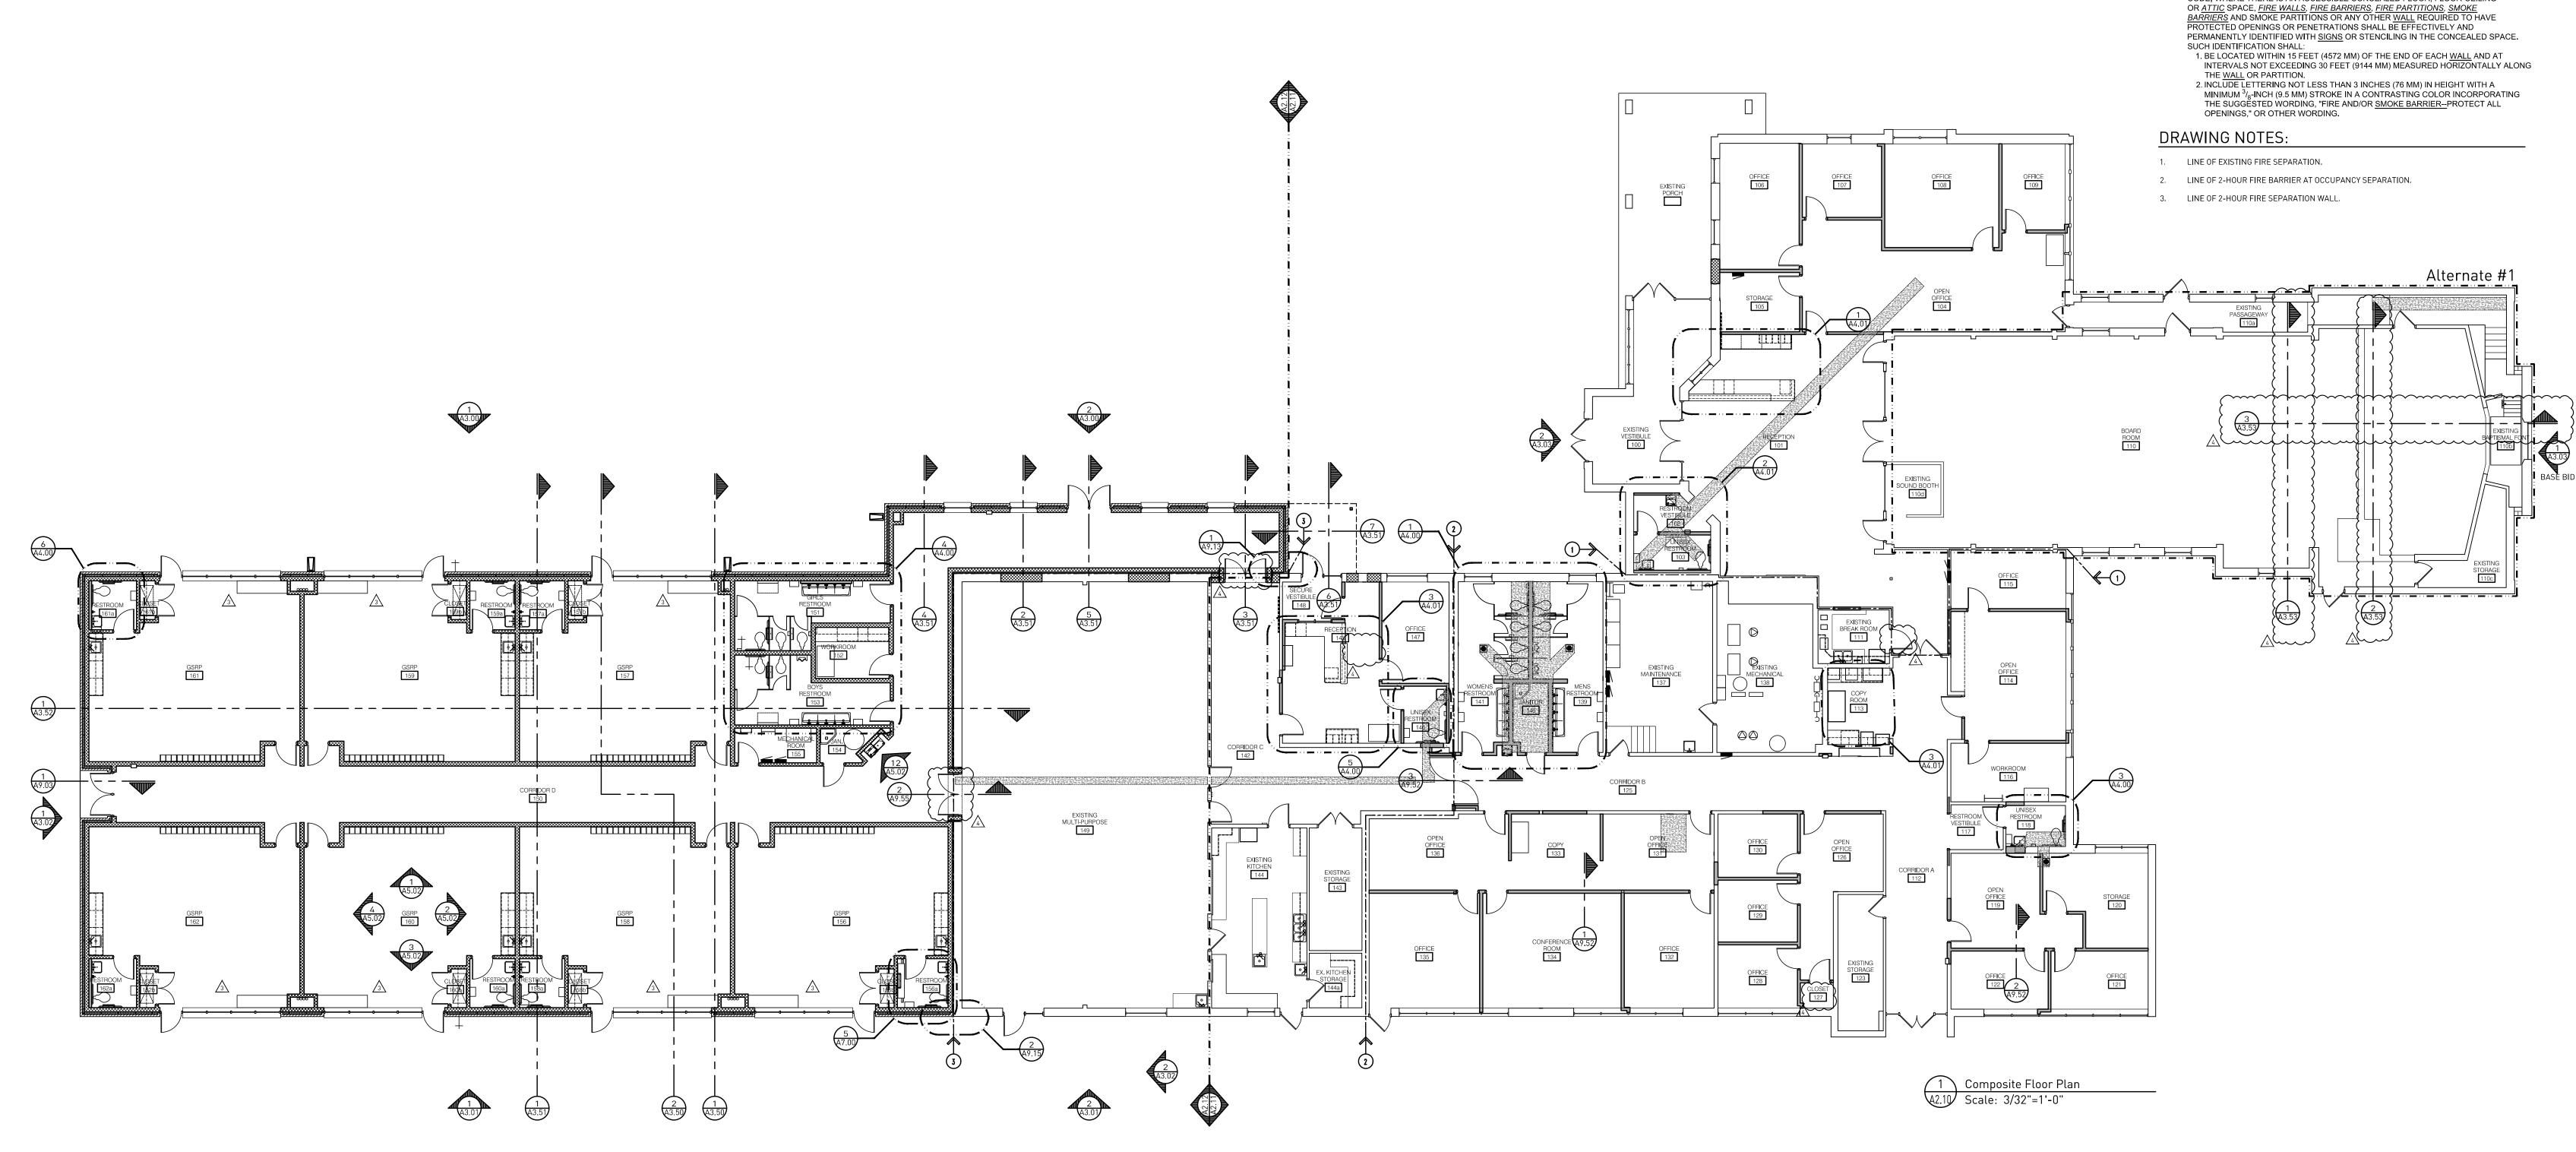



G2. COMPOSITE PLAN ISSUED FOR REFERENCE ONLY.

G3. REFER TO SHEETS A2.11 AND A2.12 FOR FURTHER INFORMATION.

G1. DO NOT SCALE DRAWING. DRAWING SCALE IS SHOWN FOR GENERAL REFERENCE ONLY.

93. PER SECTION 703.7 MARKING AND IDENTIFICATION OF THE 2015 MICHIGAN BUILDING CODE, WHERE THERE IS AN ACCESSIBLE CONCEALED FLOOR, FLOOR-CEILING

Addendum #4: 17 August 2023

Addendum #3: 16 August 2023

Bidding and Permits: 31 July 2023


Composite Floor Plan



Crestwood School District Cherry Hill Baptist Church Administration Relocation and Addition

Project No. 3221

A2.10

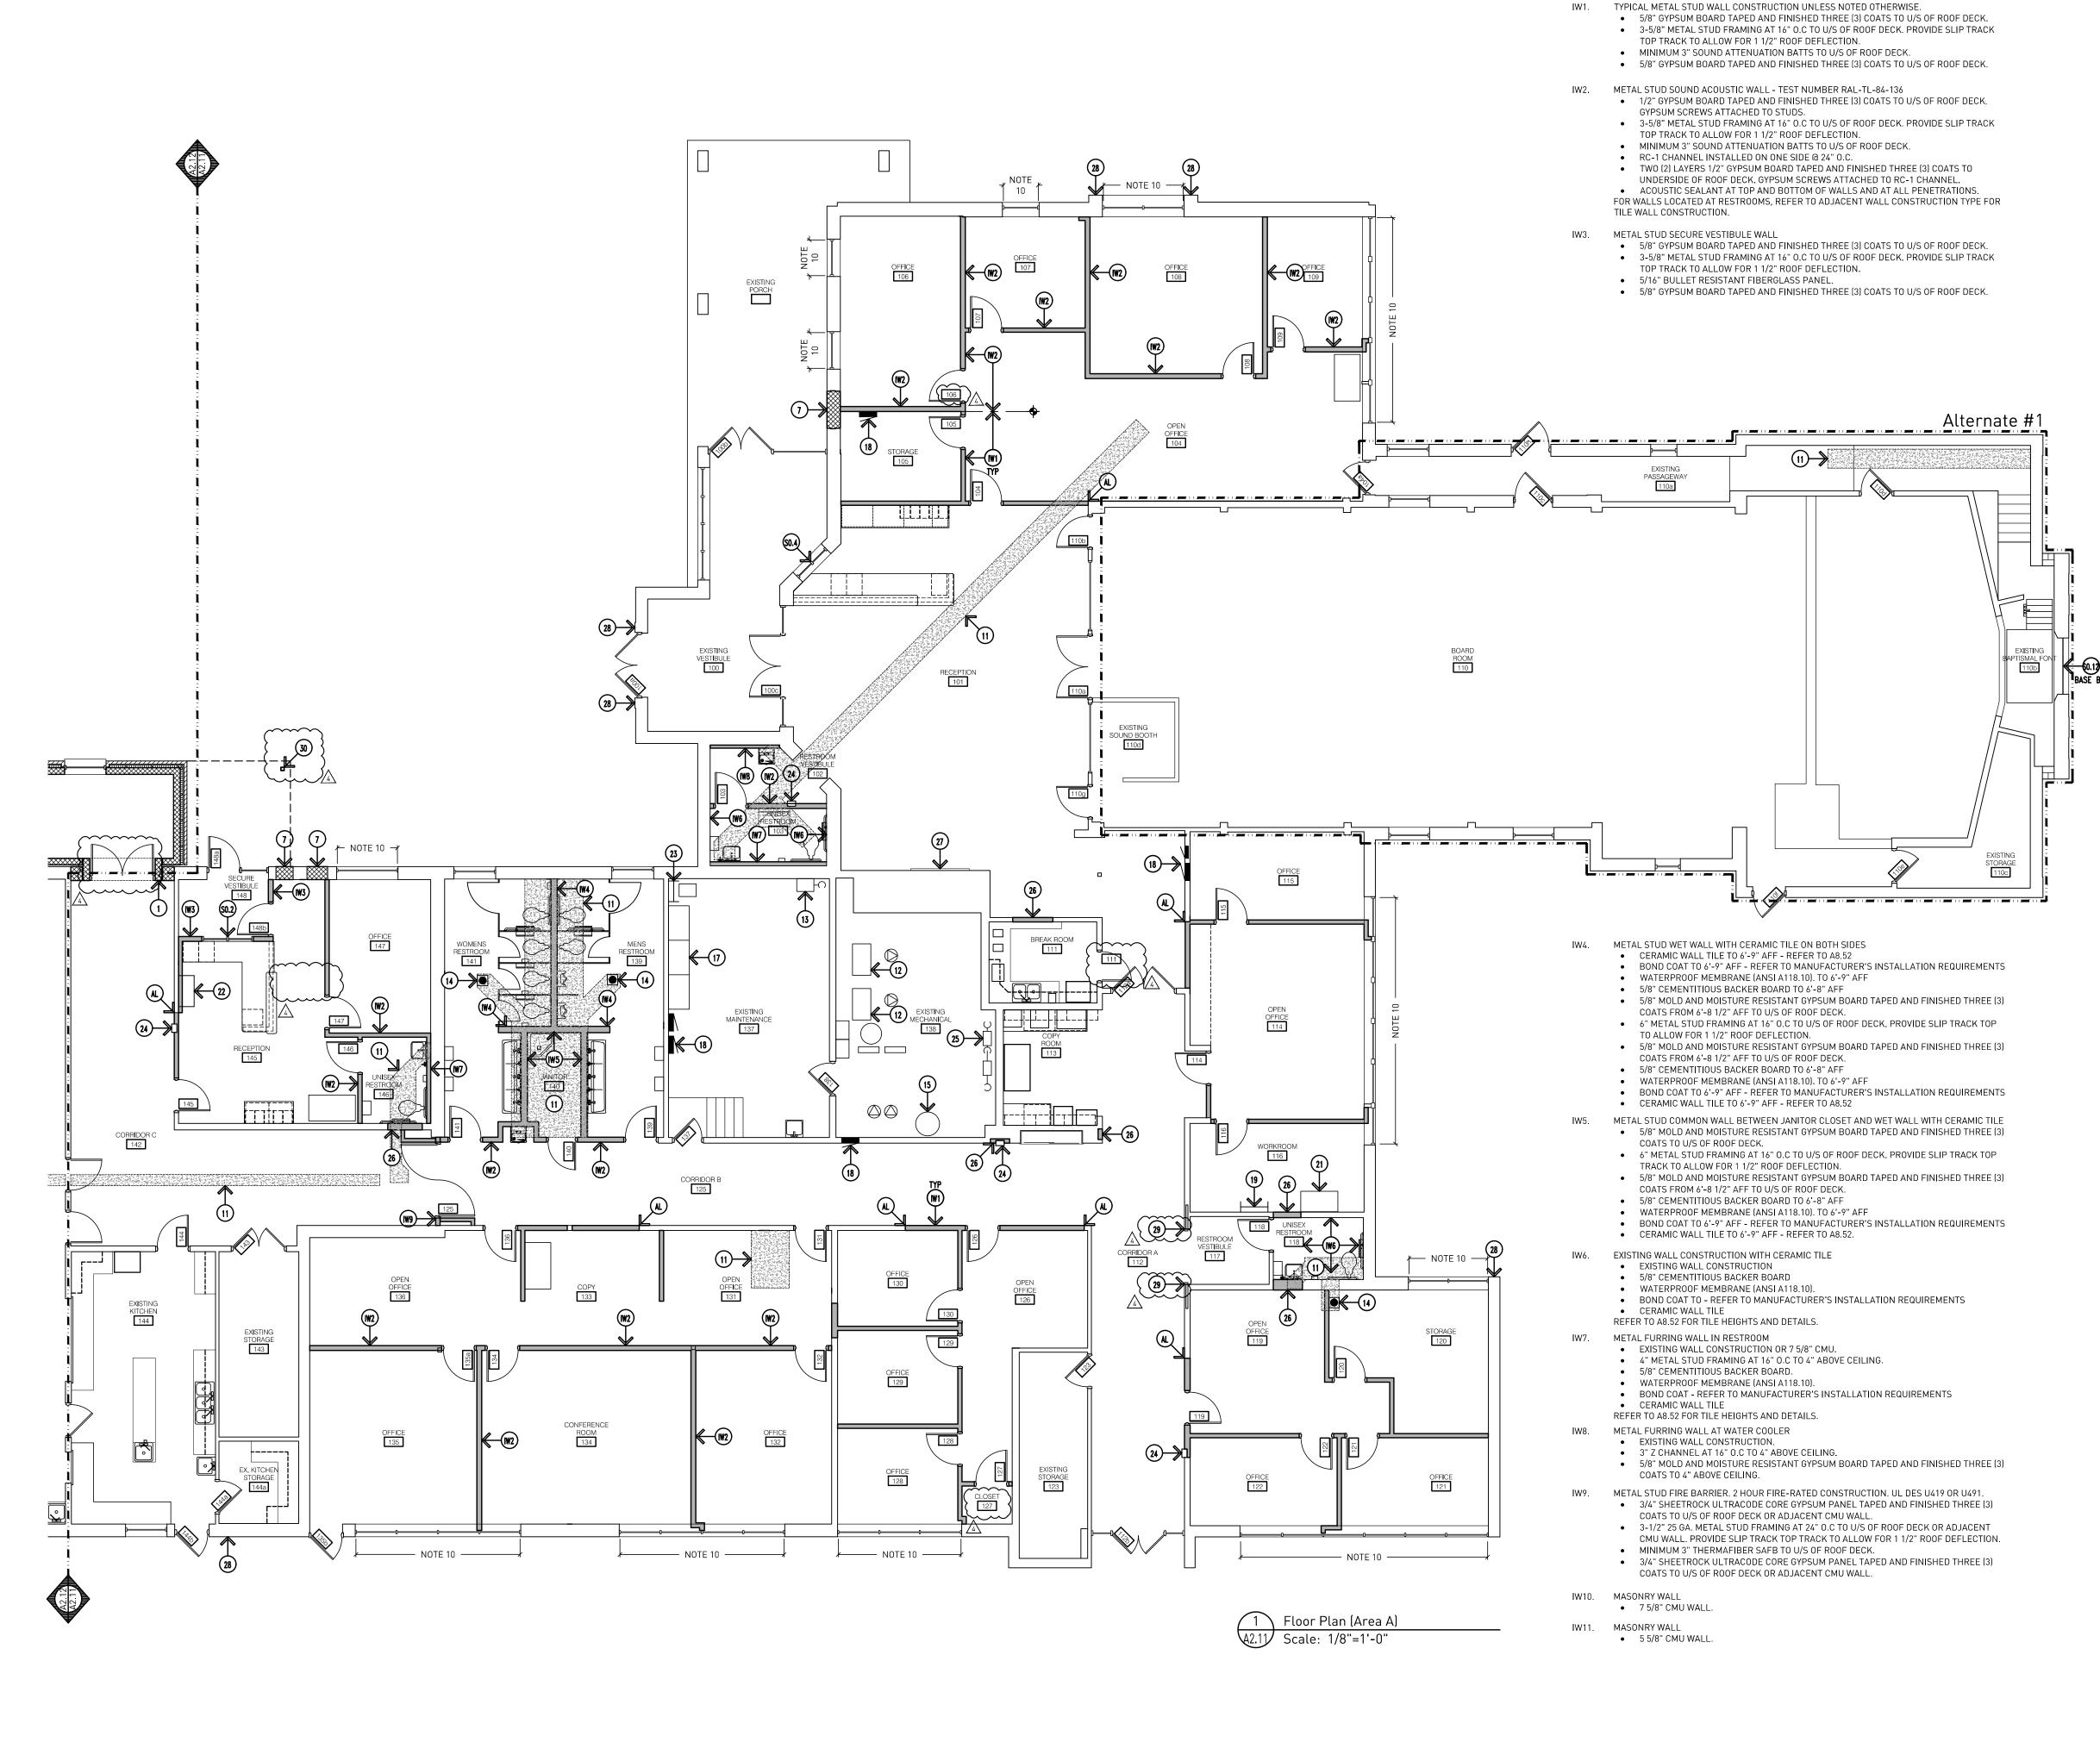

**INTERIOR WALL TAGS:** 

- G1. DO NOT SCALE DRAWING. DRAWING SCALE IS SHOWN FOR GENERAL REFERENCE ONLY.
- G2. COORDINATE THE TIMING OF WORK TO AVOID CONFLICTS WITH NORMAL SCHOOL OPERATIONS AND ACTIVITIES.
- G3. CONTRACTOR TO KEEP ALL AREAS NOT AFFECTED BY CONSTRUCTION OPERATIONS OPEN, CLEAN, AND FREE FOR OWNER USE.
  - CONTRACTOR TO VERIFY ALL EXISTING DIMENSIONS IN FIELD PRIOR TO WORK COMMENCEMENT. IF ANY DISCREPANCIES EXIST BETWEEN PLAN DIMENSIONS AND ACTUAL
  - FIELD CONDITIONS, NOTIFY THE ARCHITECT
  - G5. ALL MASONRY TO MATCH EXISTING COURSING EXACTLY. CONTRACTOR SHALL FIELD VERIFY ALL CONDITIONS PRIOR TO WORK.
  - G6. CONTRACTOR SHALL INSTALL HORIZONTAL JOINT REINFORCING @ 16" O.C. VERTICALLY.
  - G7. CONTRACTOR TO INSTALL ADJUSTABLE BRICK VENEER ANCHORS @ 16" O.C. VERTICALLY AND HORIZONTALLY. FIELD VERIFY CAVITY SIZE TO PROVIDE CORRECT ANCHOR.
  - CONTRACTOR SHALL INSTALL A CONTINUOUS VAPOR BARRIER FROM FOUNDATION TO
  - G9. ALL OUTSIDE CORNERS OF INTERIOR CMU MASONRY TO BE BULLNOSE.

ROOFING. REFER TO SPECIFICATION FOR FURTHER INFORMATION.

- G10. ALL CORRIDOR WALLS TO BE CONSTRUCTED TO RESIST THE PASSAGE OF SMOKE.
- G11. FIRE STOP ANY PENETRATIONS THROUGH FIRE WALLS AND BARRIERS.
- G12. MASONRY CONTROL JOINTS SHOULD BE SPACED 25'-0" APART MAX. AND SHOULD NOT BE SPACED FURTHER THAN 1.5x THE WALL HEIGHT - REFER TO THE MASONRY INSTITUTE FOR FURTHER INFORMATION.
- G13. REFER TO STRUCTURAL DRAWINGS FOR ADDITIONAL DIMENSIONS. NOTIFY ARCHITECT OF ANY DISCREPANCIES PRIOR TO COMMENCING THE WORK.
- G13. ALL INTERIOR WALLS TO BE CONSTRUCTED TO UNDERSIDE OF ROOF DECK. PROVIDE COMPRESSIVE FIRE SAFE MATERIAL (FIRE-RATED TO MEET CODE, AS REQUIRED) AT TOP OF WALL TO ALLOW FOR MINIMUM 1" ROOF DEFLECTION.
- G14. PROVIDE NON-COM WOOD BLOCKING AS REQUIRED TO INSTALL MISC. ACCESSORIES, IFP'S, MARKER BOARDS ETC WHETHER INDICATED OR NOT. VERIFY ALL LOCATIONS WITH OWNER AT A PRE-CONSTRUCTION MEETING
- G15. CONTRACTOR TO COORDINATE CONDUIT RUNS AND TERMINATIONS ASSOCIATED WITH LOW-VOLTAGE COMMUNICATIONS, FIRE ALARM, SECURITY, ETC. AT A PRE-CONSTRUCTION
- G16. ALL WALLS TO BE PAINTED UNLESS NOTED OTHERWISE.
- G17. PATCH AND REPAIR ALL EXPOSED SURFACES, WHETHER NOTED OR NOT, AT REMOVED ITEMS, REMOVED EQUIPMENT, REMOVED WALLS, CONSTRUCTION DAMAGE, ETC.

## DRAWING NOTES:

- 1. PORTAL WALL SYSTEM PROVIDE MINIMUM 1" GAP AT ALL SIDES.
- 2. UNIT VENTILATOR. REFER TO MECHANICAL DRAWINGS.
- 3. PLASTIC LAMINATE CUBBIES. REFER TO INTERIOR ELEVATIONS AND SPECIFICATIONS.
- 4. VISUAL DISPLAY BOARD. REFER TO SPECIFICATIONS.
- 5. INTERACTIVE FLAT PANEL. FURNISHED AND INSTALLED BY TECHNOLOGY VENDOR.
- WALL MOUNTED ROOF LADDER.
- INFILL EXISTING EXTERIOR WALL OPENING. TOOTH IN EXTERIOR MASONRY AS REQUIRED TO MATCH ADJACENT WALL EXACTLY. PROVIDE INTERIOR FINISH TO MATCH EXISTING.
- INSTALL TWO FIXED AND PAINTED SHELVES IN CLOSET, @3'-6" AND 5'-0" AFF.
- SINGLE ROLLER WINDOW SHADE, ROOM DARKENING. REFER TO MATERIAL SCHEDULE AND
- 10. SINGLE ROLLER WINDOW SHADE, 5% OPEN REFER TO MATERIAL SCHEDULE AND
- TRENCH INFILL. MIN 4" THICK CONCRETE FLOOR SLAB ON 15 MIL VAPOR BARRIER. TOP OF NEW CONCRETE TO BE FLUSH WITH EXISTING ADJACENT SLAB EXACTLY.
- 12. BOILER REFER TO MECHANICAL.
- 13. WATER METER REFER TO MECHANICAL.
- 14. FLOOR DRAIN REFER TO MECHANICAL.
- 15. HOT WATER TANK REFER TO MECHANICAL
- 16. LOCKABLE HOSE BIB REFER TO MECHANICAL.
- 18. ELECTRICAL PANEL REFER TO ELECTRICAL.
- 19. TMBD REFER TO ELECTRICAL AND TECHNOLOGY. 20. TGB - REFER TO ELECTRICAL AND TECHNOLOGY.
- 21. DATA RACK REFER TO TECHNOLOGY.
- 22. FIRE ALARM PANEL REFER TO ELECTRICAL.
- 23. GROUNDING BAR REFER TO ELECTRICAL.
- 24. SEMI-RECESSED FIRE EXTINGUISHER CABINET WITH FIRE EXTINGUISHER.
- EXISTING GAS METER.
- 26. INFILL INTERIOR WALL OPENING AS REQUIRED TO PROVIDE FLUSH APPEARANCE.
- 27. FIREPLACE DESIGN INTENT: PATCH AND REPAIR SURFACES AFTER REMOVAL OF MARBLE SURROUND AND BRASS INSERT. PAINT SURROUND AND FIREBOX FOR FINISHED
- 28. CLEAN, PATCH AND REPAIR LIMESTONE/BRICK AT REMOVED OR REPLACED EXTERIOR LIGHT
- 29. PATCH AND REPAIR WALLS AT REMOVED FRAME.
- PAINTED STRUCTURAL COLUMN AT CANOPY REFER TO STRUCTURAL DRAWINGS FOR FURTHER INFORMATION.

### **EXTERIOR WALL TAGS:**

- 7 5/8" CMU MASONRY (PAINT ALL SURFACES EXPOSED TO VIEW). • 3" SPRAY FOAM BUILDING INSULATION OVER CONTINUOUS VAPOR BARRIER.
- 3 5/8" BRICK VENEER WITH ADJACENT BRICK TIES @ 16" O.C. VERTICALLY AND
- HORIZONTALLY (PROVIDE LENGTH AS REQUIRED DUE TO WALL CAVITY SIZE).



Addendum #4: 17 August 2023 Bidding and Permits: 31 July 2023

Floor Plan (Area A)



**Crestwood School District** Cherry Hill Baptist Church Administration Relocation and Addition

Project No. 3221





# IW7. METAL FURRING WALL IN RESTROOM

- EXISTING WALL CONSTRUCTION OR 7 5/8" CMU.
- 4" METAL STUD FRAMING AT 16" O.C TO 4" ABOVE CEILING.
- 5/8" CEMENTITIOUS BACKER BOARD.
- WATERPROOF MEMBRANE (ANSI A118.10).
- BOND COAT REFER TO MANUFACTURER'S INSTALLATION REQUIREMENTS CERAMIC WALL TILE

# REFER TO A8.52 FOR TILE HEIGHTS AND DETAILS.

- IW8. METAL FURRING WALL AT WATER COOLER EXISTING WALL CONSTRUCTION.
- 3" Z CHANNEL AT 16" O.C TO 4" ABOVE CEILING. • 5/8" MOLD AND MOISTURE RESISTANT GYPSUM BOARD TAPED AND FINISHED THREE (3 COATS TO 4" ABOVE CEILING.
- IW9. METAL STUD FIRE BARRIER. 2 HOUR FIRE-RATED CONSTRUCTION. UL DES U419 OR U491. 3/4" SHEETROCK ULTRACODE CORE GYPSUM PANEL TAPED AND FINISHED THREE (3)

(W10)

- COATS TO U/S OF ROOF DECK OR ADJACENT CMU WALL.
- 3-1/2" 25 GA. METAL STUD FRAMING AT 24" O.C TO U/S OF ROOF DECK OR ADJACENT
- CMU WALL. PROVIDE SLIP TRACK TOP TRACK TO ALLOW FOR 1 1/2" ROOF DEFLECTION. MINIMUM 3" THERMAFIBER SAFB TO U/S OF ROOF DECK.
- 3/4" SHEETROCK ULTRACODE CORE GYPSUM PANEL TAPED AND FINISHED THREE (3) COATS TO U/S OF ROOF DECK OR ADJACENT CMU WALL.

### IW10. MASONRY WALL

#### IW11. MASONRY WALL

5 5/8" CMU WALL.

# 7 5/8" CMU WALL.

IW2. METAL STUD SOUND ACOUSTIC WALL - TEST NUMBER RAL-TL-84-136

RC-1 CHANNEL INSTALLED ON ONE SIDE @ 24" O.C.

COATS FROM 6'-8 1/2" AFF TO U/S OF ROOF DECK.

• 5/8" CEMENTITIOUS BACKER BOARD TO 6'-8" AFF WATERPROOF MEMBRANE (ANSI A118.10). TO 6'-9" AFF

• CERAMIC WALL TILE TO 6'-9" AFF - REFER TO A8.52

COATS FROM 6'-8 1/2" AFF TO U/S OF ROOF DECK. • 5/8" CEMENTITIOUS BACKER BOARD TO 6'-8" AFF

WATERPROOF MEMBRANE (ANSI A118.10). TO 6'-9" AFF

• CERAMIC WALL TILE TO 6'-9" AFF - REFER TO A8.52.

COATS TO U/S OF ROOF DECK.

IW6. EXISTING WALL CONSTRUCTION WITH CERAMIC TILE EXISTING WALL CONSTRUCTION

 5/8" CEMENTITIOUS BACKER BOARD WATERPROOF MEMBRANE (ANSI A118.10).

REFER TO A8.52 FOR TILE HEIGHTS AND DETAILS.

1 \ Floor Plan (Area B

CERAMIC WALL TILE

TOP TRACK TO ALLOW FOR 1 1/2" ROOF DEFLECTION.

MINIMUM 3" SOUND ATTENUATION BATTS TO U/S OF ROOF DECK.

GYPSUM SCREWS ATTACHED TO STUDS.

INTERIOR WALL TAGS:

IW1. TYPICAL METAL STUD WALL CONSTRUCTION UNLESS NOTED OTHERWISE. • 5/8" GYPSUM BOARD TAPED AND FINISHED THREE (3) COATS TO U/S OF ROOF DECK.

• 5/8" GYPSUM BOARD TAPED AND FINISHED THREE (3) COATS TO U/S OF ROOF DECK.

• 1/2" GYPSUM BOARD TAPED AND FINISHED THREE (3) COATS TO U/S OF ROOF DECK.

• 3-5/8" METAL STUD FRAMING AT 16" O.C TO U/S OF ROOF DECK. PROVIDE SLIP TRACK

• TWO (2) LAYERS 1/2" GYPSUM BOARD TAPED AND FINISHED THREE (3) COATS TO

UNDERSIDE OF ROOF DECK. GYPSUM SCREWS ATTACHED TO RC-1 CHANNEL.

• 5/8" MOLD AND MOISTURE RESISTANT GYPSUM BOARD TAPED AND FINISHED THREE (3

• BOND COAT TO 6'-9" AFF - REFER TO MANUFACTURER'S INSTALLATION REQUIREMENTS

• 5/8" MOLD AND MOISTURE RESISTANT GYPSUM BOARD TAPED AND FINISHED THREE (3

• BOND COAT TO 6'-9" AFF - REFER TO MANUFACTURER'S INSTALLATION REQUIREMENTS

BOND COAT TO - REFER TO MANUFACTURER'S INSTALLATION REQUIREMENTS

METAL STUD COMMON WALL BETWEEN JANITOR CLOSET AND WET WALL WITH CERAMIC TILE

G2. COORDINATE THE TIMING OF WORK TO AVOID CONFLICTS WITH NORMAL SCHOOL OPERATIONS • 3-5/8" METAL STUD FRAMING AT 16" O.C TO U/S OF ROOF DECK. PROVIDE SLIP TRACK AND ACTIVITIES. TOP TRACK TO ALLOW FOR 1 1/2" ROOF DEFLECTION. • MINIMUM 3" SOUND ATTENUATION BATTS TO U/S OF ROOF DECK.

**GENERAL NOTES:** 

- G3. CONTRACTOR TO KEEP ALL AREAS NOT AFFECTED BY CONSTRUCTION OPERATIONS OPEN, CLEAN, AND FREE FOR OWNER USE.
  - G4. CONTRACTOR TO VERIFY ALL EXISTING DIMENSIONS IN FIELD PRIOR TO WORK
  - COMMENCEMENT. IF ANY DISCREPANCIES EXIST BETWEEN PLAN DIMENSIONS AND ACTUAL FIELD CONDITIONS, NOTIFY THE ARCHITECT.

G1. DO NOT SCALE DRAWING. DRAWING SCALE IS SHOWN FOR GENERAL REFERENCE ONLY.

- G5. ALL MASONRY TO MATCH EXISTING COURSING EXACTLY. CONTRACTOR SHALL FIELD VERIFY
- ALL CONDITIONS PRIOR TO WORK. G6. CONTRACTOR SHALL INSTALL HORIZONTAL JOINT REINFORCING @ 16" O.C. VERTICALLY.
- G7. CONTRACTOR TO INSTALL ADJUSTABLE BRICK VENEER ANCHORS @ 16" O.C. VERTICALLY AND HORIZONTALLY. FIELD VERIFY CAVITY SIZE TO PROVIDE CORRECT ANCHOR.
- ROOFING. REFER TO SPECIFICATION FOR FURTHER INFORMATION.
- G9. ALL OUTSIDE CORNERS OF INTERIOR CMU MASONRY TO BE BULLNOSE.
- G10. ALL CORRIDOR WALLS TO BE CONSTRUCTED TO RESIST THE PASSAGE OF SMOKE.
- G11. FIRE STOP ANY PENETRATIONS THROUGH FIRE WALLS AND BARRIERS.
- G12. MASONRY CONTROL JOINTS SHOULD BE SPACED 25'-0" APART MAX. AND SHOULD NOT BE SPACED FURTHER THAN 1.5x THE WALL HEIGHT - REFER TO THE MASONRY INSTITUTE FOR
- G13. REFER TO STRUCTURAL DRAWINGS FOR ADDITIONAL DIMENSIONS. NOTIFY ARCHITECT OF
- ANY DISCREPANCIES PRIOR TO COMMENCING THE WORK. G13. ALL INTERIOR WALLS TO BE CONSTRUCTED TO UNDERSIDE OF ROOF DECK. PROVIDE COMPRESSIVE FIRE SAFE MATERIAL (FIRE-RATED TO MEET CODE, AS REQUIRED) AT TOP OF
- G14. PROVIDE NON-COM WOOD BLOCKING AS REQUIRED TO INSTALL MISC. ACCESSORIES, IFP'S, MARKER BOARDS ETC WHETHER INDICATED OR NOT. VERIFY ALL LOCATIONS WITH OWNER
- AT A PRE-CONSTRUCTION MEETING. G15. CONTRACTOR TO COORDINATE CONDUIT RUNS AND TERMINATIONS ASSOCIATED WITH
  - LOW-VOLTAGE COMMUNICATIONS, FIRE ALARM, SECURITY, ETC. AT A PRE-CONSTRUCTION
- G16. ALL WALLS TO BE PAINTED UNLESS NOTED OTHERWISE. G17. PATCH AND REPAIR ALL EXPOSED SURFACES, WHETHER NOTED OR NOT, AT REMOVED ITEMS,
- 6" METAL STUD FRAMING AT 16" O.C TO U/S OF ROOF DECK. PROVIDE SLIP TRACK TOP REMOVED EQUIPMENT, REMOVED WALLS, CONSTRUCTION DAMAGE, ETC. TRACK TO ALLOW FOR 1 1/2" ROOF DEFLECTION. • 5/8" MOLD AND MOISTURE RESISTANT GYPSUM BOARD TAPED AND FINISHED THREE (3

# DRAWING NOTES:

- 1. PORTAL WALL SYSTEM PROVIDE MINIMUM 1" GAP AT ALL SIDES.
- 2. UNIT VENTILATOR. REFER TO MECHANICAL DRAWINGS.
- 3. PLASTIC LAMINATE CUBBIES. REFER TO INTERIOR ELEVATIONS AND SPECIFICATIONS. 4. VISUAL DISPLAY BOARD. REFER TO SPECIFICATIONS.
- INTERACTIVE FLAT PANEL. FURNISHED AND INSTALLED BY TECHNOLOGY VENDOR. WALL MOUNTED ROOF LADDER.
- INFILL EXISTING EXTERIOR WALL OPENING. TOOTH IN EXTERIOR MASONRY AS REQUIRED TO MATCH ADJACENT WALL EXACTLY. PROVIDE INTERIOR FINISH TO MATCH EXISTING.
- INSTALL TWO FIXED AND PAINTED SHELVES IN CLOSET, @3'-6" AND 5'-0" AFF.
- SINGLE ROLLER WINDOW SHADE, ROOM DARKENING. REFER TO MATERIAL SCHEDULE AND SPECIFICATIONS.
- SINGLE ROLLER WINDOW SHADE, 5% OPEN REFER TO MATERIAL SCHEDULE AND SPECIFICATIONS.
- TRENCH INFILL. MIN 4" THICK CONCRETE FLOOR SLAB ON 15 MIL VAPOR BARRIER. TOP OF
- NEW CONCRETE TO BE FLUSH WITH EXISTING ADJACENT SLAB EXACTLY.
- 12. BOILER REFER TO MECHANICAL. 13. WATER METER - REFER TO MECHANICAL.
- 14. FLOOR DRAIN REFER TO MECHANICAL.
- 15. HOT WATER TANK REFER TO MECHANICAL 16. LOCKABLE HOSE BIB - REFER TO MECHANICAL.
- 18. ELECTRICAL PANEL REFER TO ELECTRICAL.
- 19. TMBD REFER TO ELECTRICAL AND TECHNOLOGY.
- 20. TGB REFER TO ELECTRICAL AND TECHNOLOGY. 21. DATA RACK - REFER TO TECHNOLOGY.
- 22. FIRE ALARM PANEL REFER TO ELECTRICAL.
- 23. GROUNDING BAR REFER TO ELECTRICAL.
- 24. SEMI-RECESSED FIRE EXTINGUISHER CABINET WITH FIRE EXTINGUISHER.
- 25. EXISTING GAS METER.
- 26. INFILL INTERIOR WALL OPENING AS REQUIRED TO PROVIDE FLUSH APPEARANCE.
  - FIREPLACE DESIGN INTENT: PATCH AND REPAIR SURFACES AFTER REMOVAL OF MARBLE SURROUND AND BRASS INSERT. PAINT SURROUND AND FIREBOX FOR FINISHED
- 28. CLEAN, PATCH AND REPAIR LIMESTONE/BRICK AT REMOVED OR REPLACED EXTERIOR LIGHT
- 29. PATCH AND REPAIR WALLS AT REMOVED FRAME.

# **EXTERIOR WALL TAGS:**

- 7 5/8" CMU MASONRY (PAINT ALL SURFACES EXPOSED TO VIEW). • 3" SPRAY FOAM BUILDING INSULATION OVER CONTINUOUS VAPOR BARRIER.
- 3 5/8" BRICK VENEER WITH ADJACENT BRICK TIES @ 16" O.C. VERTICALLY AND HORIZONTALLY (PROVIDE LENGTH AS REQUIRED DUE TO WALL CAVITY SIZE).



Addendum #4: 17 August 2023 Addendum #3: 16 August 2023 Bidding and Permits: 31 July 2023

Floor Plan (Area B)



Crestwood School District Cherry Hill Baptist Church Administration Relocation and Addition


Project No. 3221


A2.12

803 W. Big Beaver Road, Suite 350, Troy, MI 48084 | 248.244.9710



EXISTING KITCHEN 144

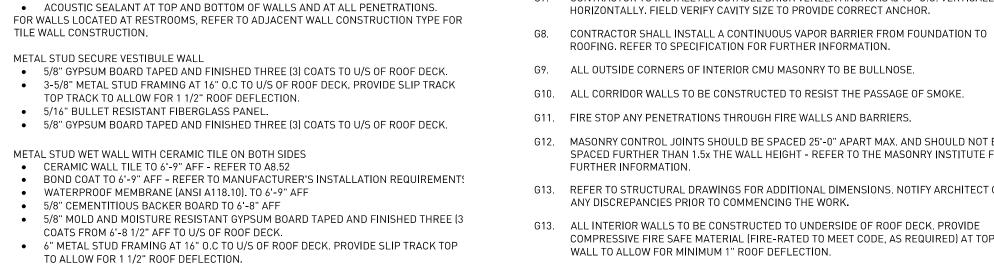

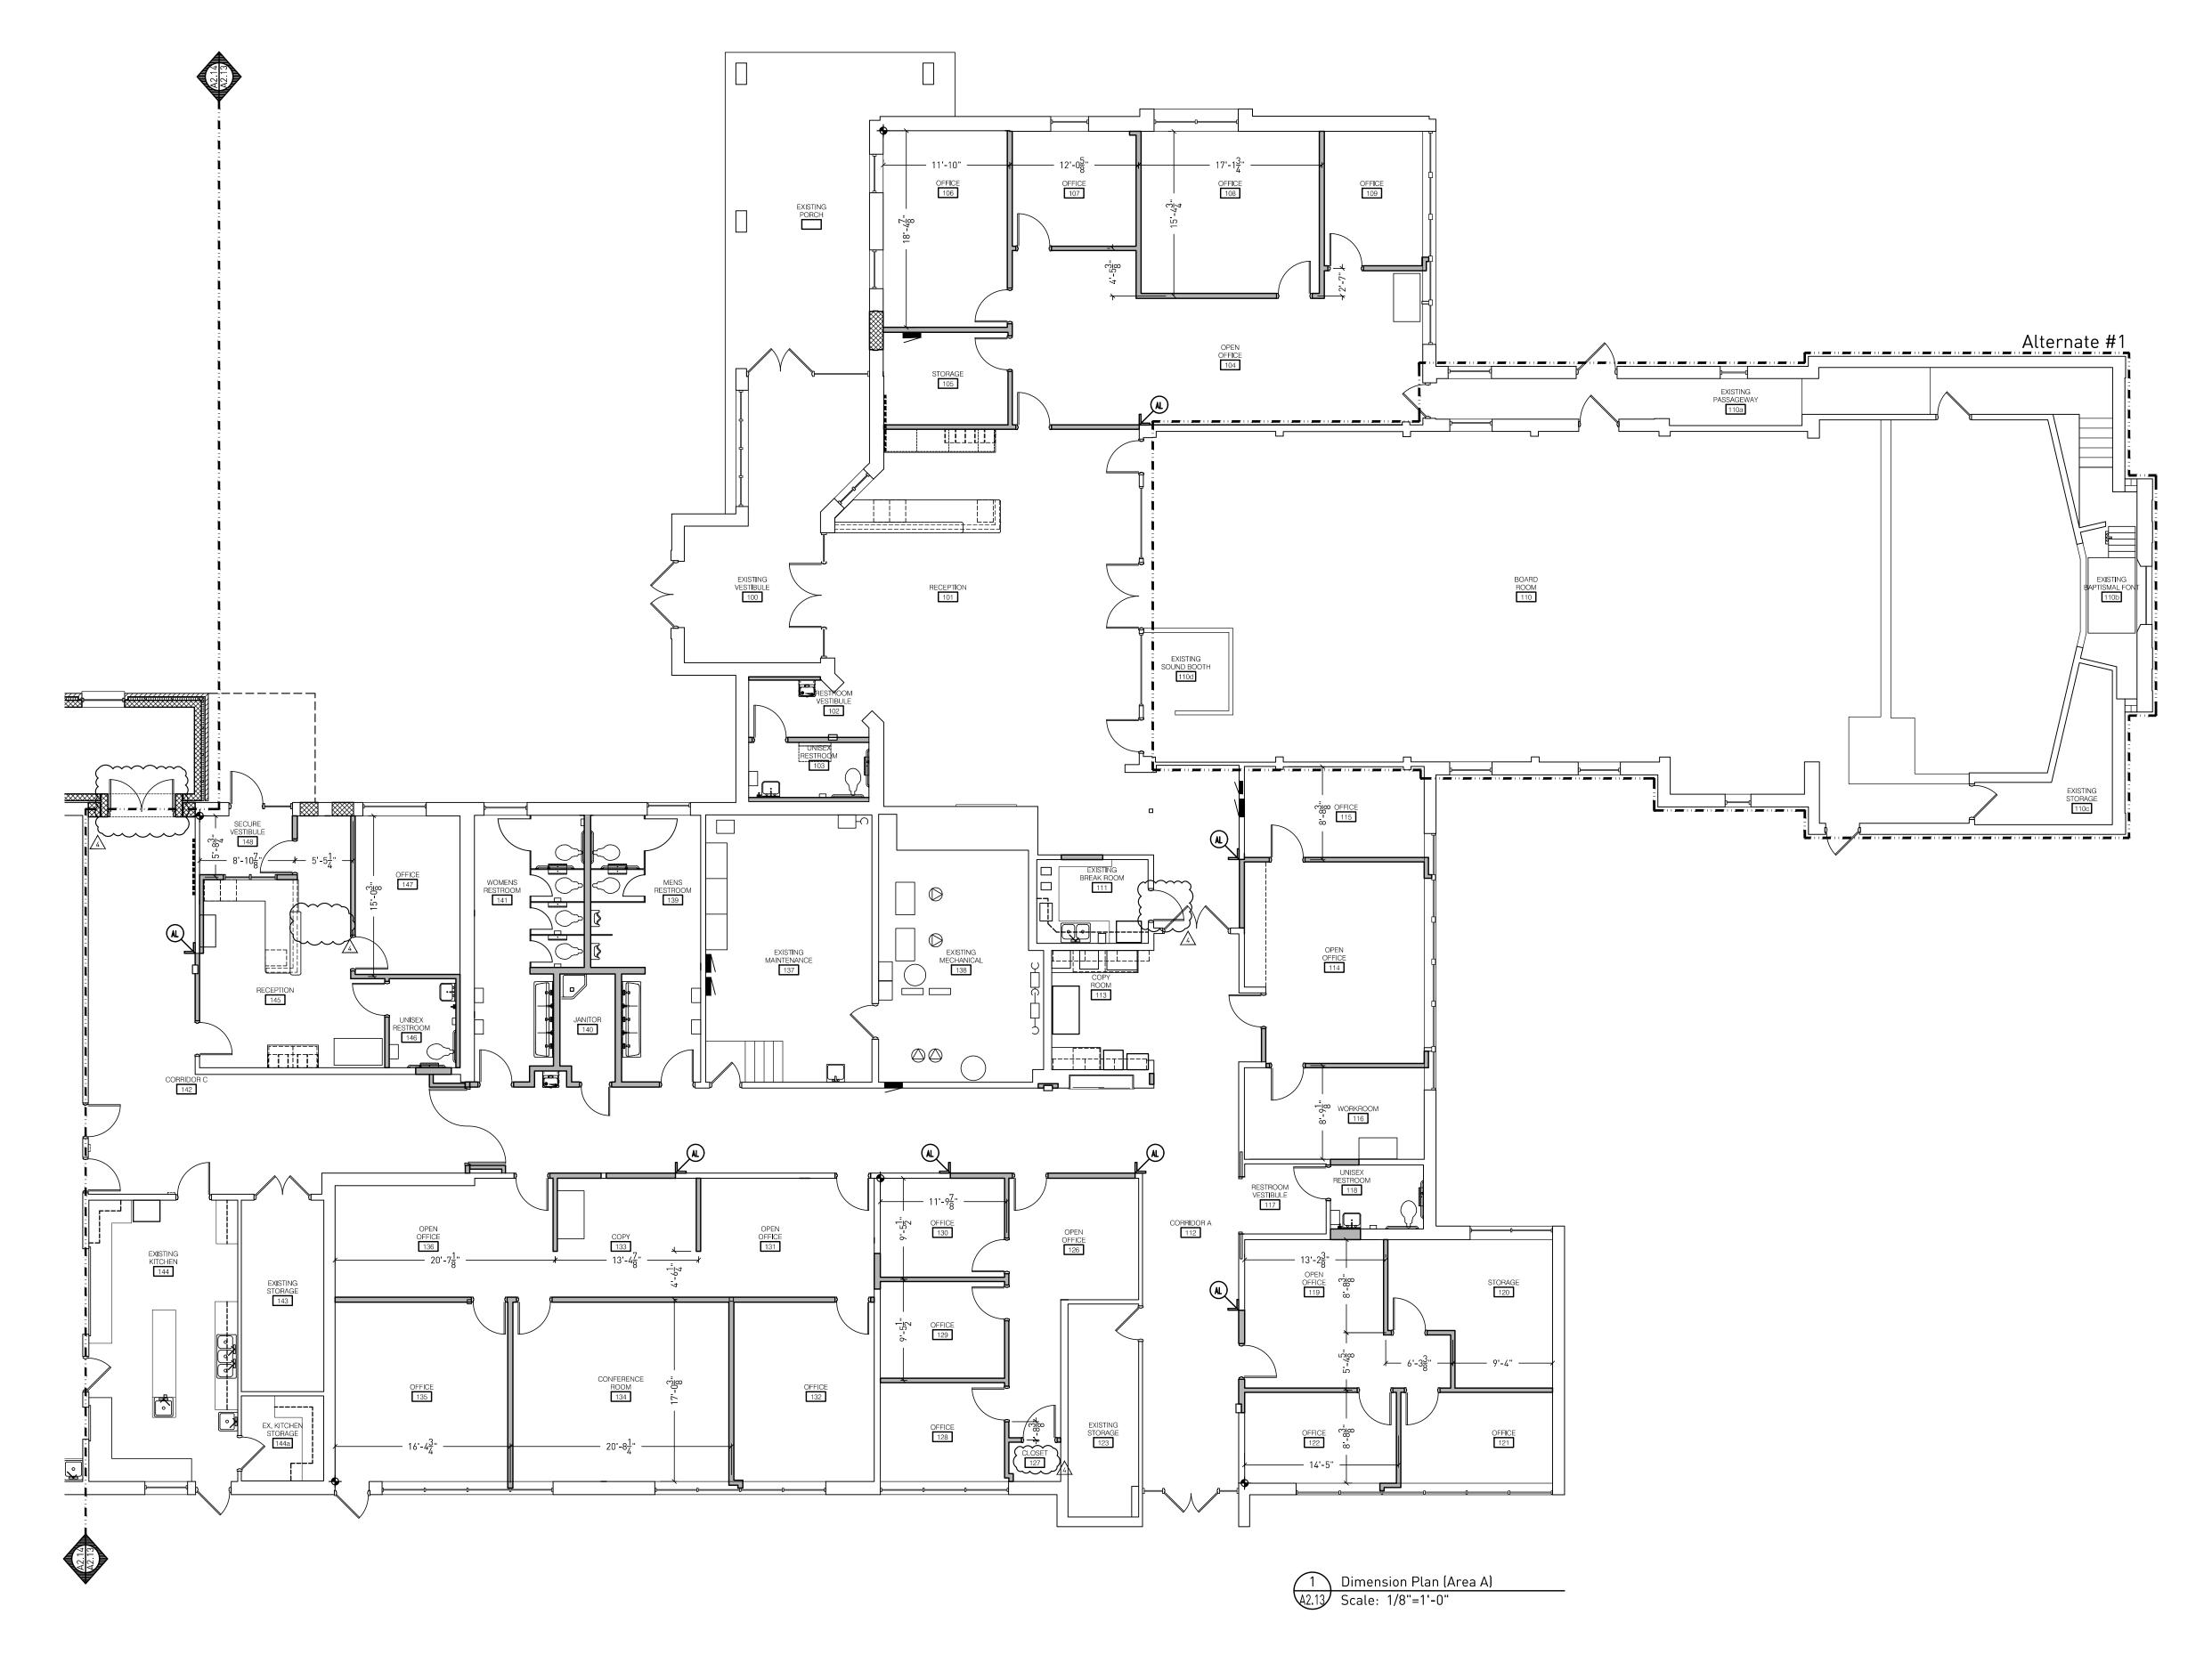



- G1. DO NOT SCALE DRAWING. DRAWING SCALE IS SHOWN FOR GENERAL REFERENCE ONLY.
- G2. ALL EXTERIOR WALLS ARE 1'-3 1/2" UNLESS DIMENSIONED OTHERWISE.
- G3. ALL DOORS ARE LOCATED 4" TO HINGE SIDE FROM ADJACENT WALL UNLESS DIMENSIONED OTHERWISE.
- G4. ALL MASONRY DIMENSIONS ARE TO FACE OF WALL.
- G5. ALL STUD FRAMING DIMENSIONS ARE TO THE CENTER OF WALL.





Dimension Plan (Area A)




Crestwood School District Cherry Hill Baptist Church Administration Relocation and Addition

Project No. 3221

A2.13



- G1. DO NOT SCALE DRAWING. DRAWING SCALE IS SHOWN FOR GENERAL REFERENCE ONLY.
- G2. ALL EXTERIOR WALLS ARE 1'-3 1/2" UNLESS DIMENSIONED OTHERWISE.
   G3. ALL DOORS ARE LOCATED 4" TO HINGE SIDE FROM ADJACENT WALL UNLESS DIMENSIONED
- G3. ALL DOORS ARE LOCATED 4" TO HINGE SIDE FROM ADJACENT WALL UNLESS DIMENSION OTHERWISE.
- G4. ALL MASONRY DIMENSIONS ARE TO FACE OF WALL.
- G5. ALL STUD FRAMING DIMENSIONS ARE TO THE CENTER OF WALL.

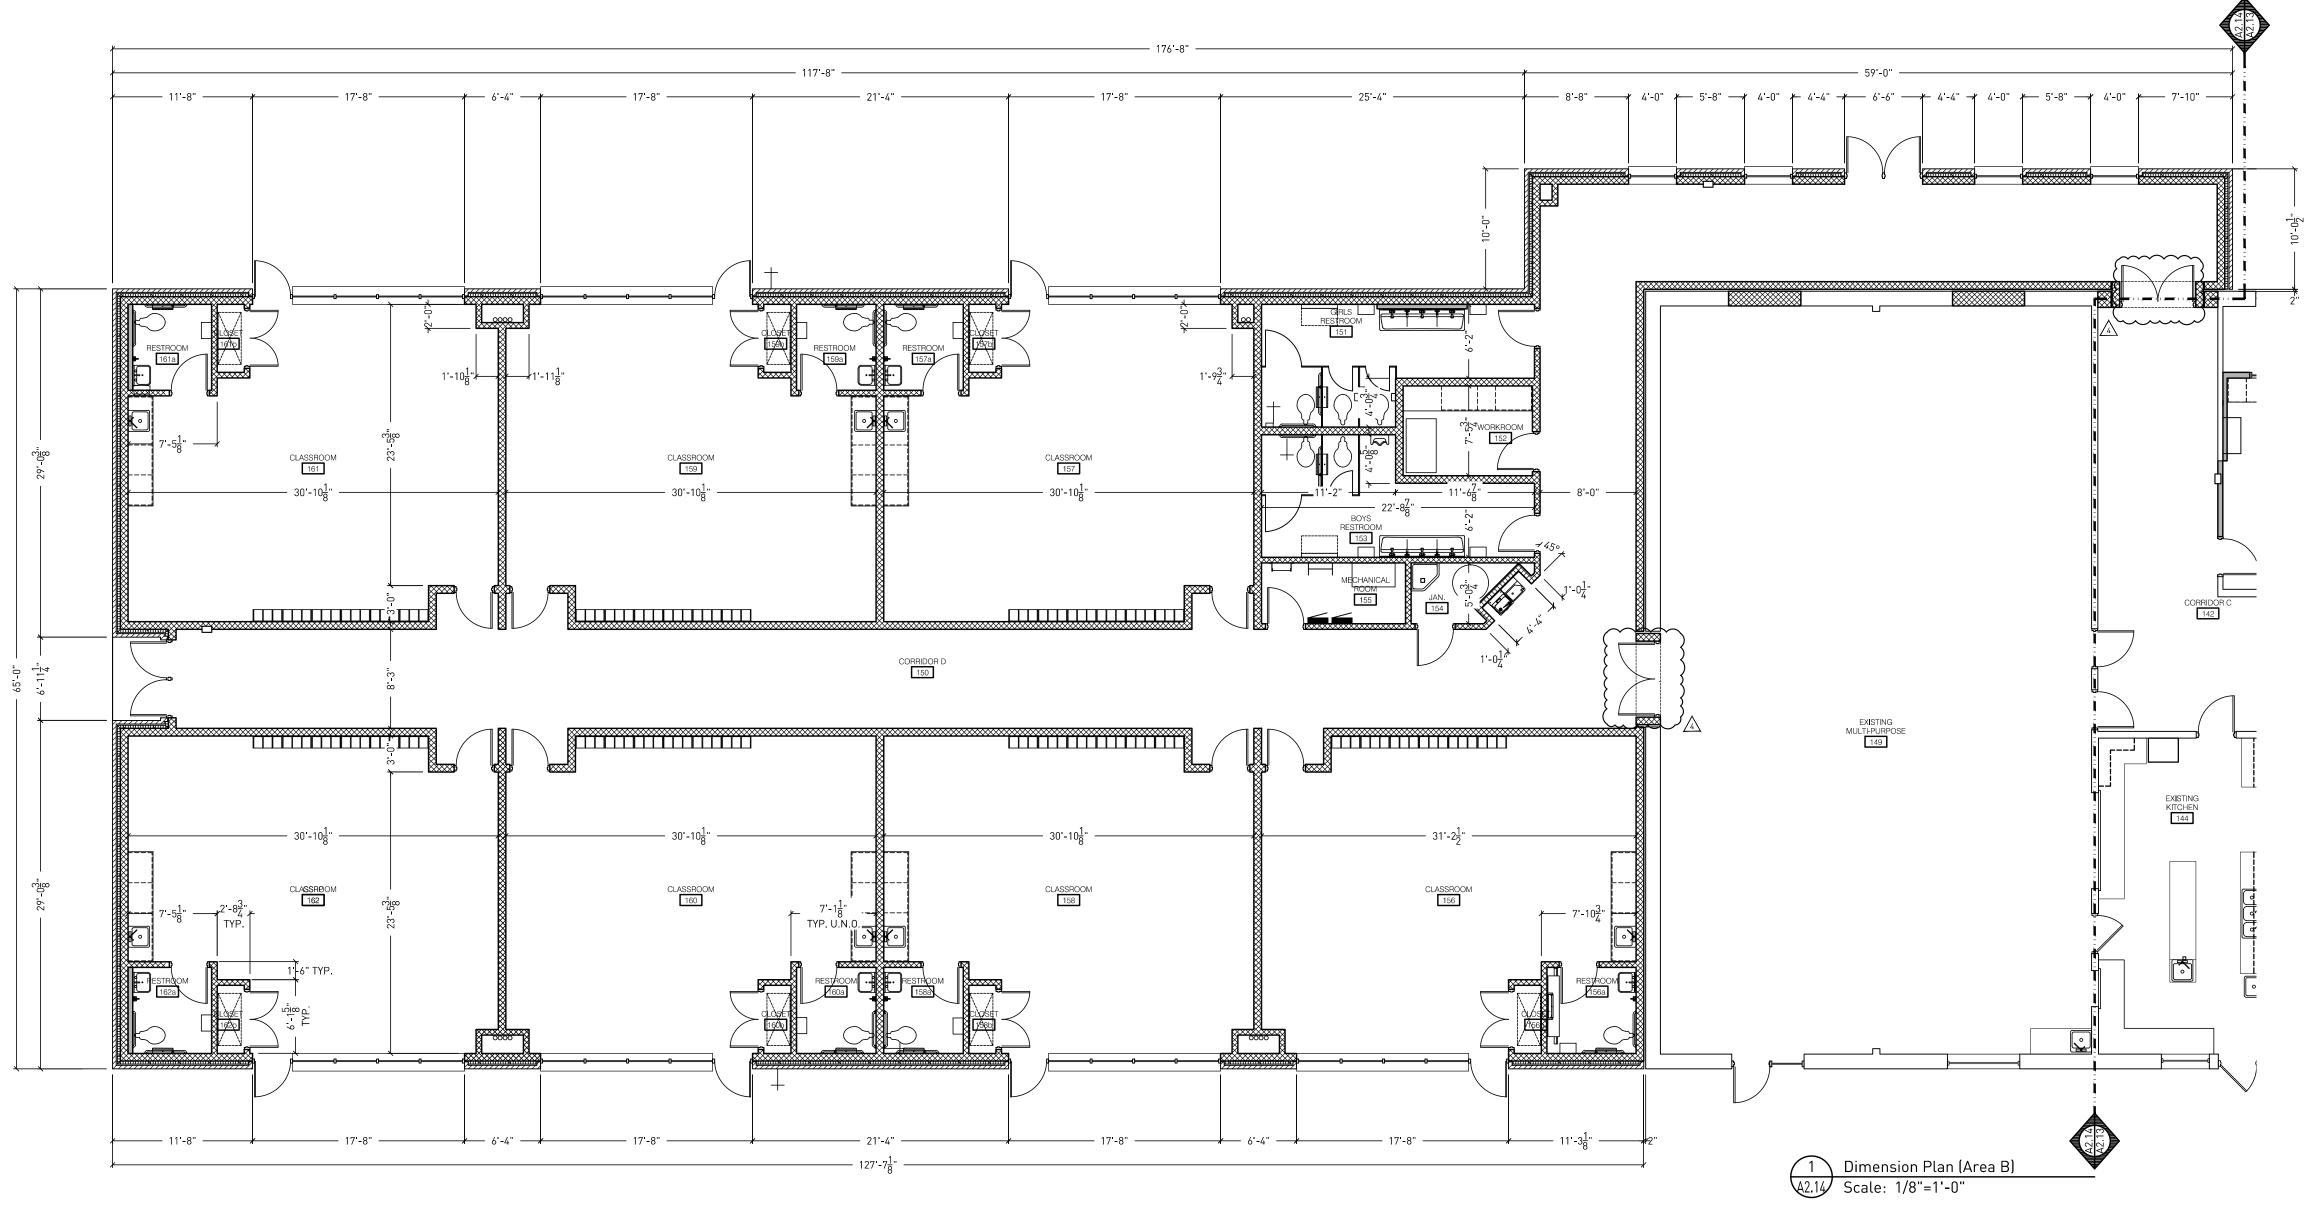



Addendum #4: 17 August 2023
Bidding and Permits: 31 July 2023

Dimension Plan (Area B)



Crestwood School District Cherry Hill Baptist Church Administration Relocation and Addition

Project No. 3221

A2.14

	DOOR SCHEDULE A																	
						EDAME.	INICODMATIC		SCHEDULE	- A			DOOD INFORM	AATION				
DOOR NO.	OPENING LOCATION	FIRE RATING	HARDW. HEADING	LOCK FUNCTION			INFORMATION OPENING	FRAME	JAMB	FRAME	FRAME	1	DOOR INFORI		DOOR	DOOR	DOOR	<u></u>
,,,,,					HARDWARE REMARKS	WIDTH	HEIGHT	ELEV.	DEPTH	MATER.	FINISH	FRAME REMARKS	SIZE	DOOR THICK.	ELEV.	MATER.	FINISH	DOOR REMARKS
100a	TO EXTERIOR FROM EXISTING VESTIBULE 100		(SET #1)		GHN3, H4, H5	ETR	ETR	ETR	ETR	ETR	ETR		ETR	ETR	ETR	ETR	ETR	
100b	TO EXISTING PORCH FROM EXISTING VESTIBULE 100				GHN3	ETR	ETR	ETR	ETR	ETR	ETR		ETR	ETR	ETR	ETR	ETR	
100c	TO VESTIBULE 100 FROM RECEPTION 101		SET #6	EXIT	(H4, H5, H6	11'-8"	7'-2"	S2.4	(5-3/4")	ALUM	PREFIN	DF3	(2) 3'-0" x 7'-0"	(1-3/4")	G	FRP	PREFIN	D1
103	TO UNISEX RESTROOM 103 FROM RESTROOM VESTIBULE 102		SET #18	PRIVACY		3'-4"	7'-2"	1.0	(5-3/4")	НМ	PAINT (PT-11)		3'-0" x 7'-0"	(1-3/4")	F	WD	STAIN	
104	TO OPEN OFFICE 104 FROM RECEPTION 101	20 MIN.	SET #15	SECURE	H5	3'-4"	7'-2"	1.0	(5-3/4")	НМ	PAINT (PT-11)		3'-0" x 7'-0"	[1-3/4"]	NL	WD	STAIN	
104a	TO OPEN OFFICE 104 FROM EXISTING PASSAGEWAY 110a				GHN3	ETR	ETR	ETR	ETR	ETR	PAINT (PT-11)		ETR	ETR	ETR	ETR	ETR	
105	TO STORAGE 105 FROM OPEN OFFICE 104		SET #20	STORER00M		3'-4"	7'-2"	1.0	(5-3/4")	НМ	PAINT (PT-11)		3'-0" x 7'-0"	[1-3/4"]	F	WD	STAIN	
106	TO OFFICE 106 FROM OPEN OFFICE 104		SET #16	OFFICE		3'-4"	7'-2"	1.0	(5-3/4")	НМ	PAINT (PT-11)		3'-0" x 7'-0"	(1-3/4")	NL	WD	STAIN	
107	TO OFFICE 107 FROM OPEN OFFICE 104		SET #16	OFFICE		3'-4"	7'-2"	1.0	(5-3/4")	НМ	PAINT (PT-11)		3'-0" x 7'-0"	[1-3/4"]	NL	WD	STAIN	
108	TO OFFICE 108 FROM OPEN OFFICE 104		SET #16	OFFICE		3'-4"	7'-2"	1.0	(5-3/4")	+	PAINT (PT-11)		3'-0" x 7'-0"	[1-3/4"]	NL	WD	STAIN	
109	TO OFFICE 109 FROM OPEN OFFICE 104		SET #16	OFFICE	$\sim$	3'-4"	7'-2"	1.0	(5-3/4")	╣	PAINT (PT-11)		3'-0" x 7'-0"	[1-3/4"]	NL	WD	STAIN	
110a	TO RECEPTION 101 FROM BOARD ROOM 110	<del>  </del>	SET #12	EXIT }	(H7)	6'-4"	7'-2"	2.0	(5-3/4")	<del>K  </del>	PAINT (PT-11)		[2] 3'-0" × 7'-0"		HG )	WD	STAIN	
110b	TO RECEPTION 101 FROM BOARD ROOM 110	20 MIN.	SET #22	EXIT		3'-4"	7'-2"	1.0	(5-3/4")	<del>11  </del>	PAINT (PT-11)			[1-3/4"]	(HG)	WD	STAIN	
110c	TO EXISTING PASSAGEWAY 110a FROM BOARD ROOM 110				GHN3	ETR	ETR	ETR	ETR	ETR	ETR		ETR	ETR	ETR	ETR	ETR	<u> </u>
110d	TO EXISTING PASSAGEWAY 110a FROM BOARD ROOM 110	<b> </b>			GHN3	ETR	ETR	ETR	ETR	+	PAINT (PT-11)		ETR	ETR	ETR	ETR	PAINT	
110e	TO EXISTING STORAGE 110c FROM BOARD ROOM 110				GHN3	ETR	ETR	ETR	ETR	<del>                                     </del>	PAINT (PT-11)		ETR	ETR	ETR	ETR	PAINT	
110f	TO EXTERIOR FROM BOARD ROOM 110			FVIT	GHN3	ETR	ETR	ETR	ETR	<del>                                     </del>	PAINT (PT-11)		2' 0"x 7' 0"	ETR	ETR	ETR	PAINT	
110g	TO RECEPTION 101 FROM BOARD ROOM 110	ZU MIN.)	SET #22	EXIT	GHN3	3'-4" ETD	7'-2" ETD	1.0 	(5-3/4")	<del>ll l</del>	PAINT (PT-11)		3'-0"x 7'-0"	(1-3/4")	HG HG	WD	STAIN	
110h	TO EXTERIOR FROM EXISTING PASSAGEWAY 110a	30 7377	CET #47	CLASSROOM 2	<b>b</b> \	ETR 3'-2"	ETR 7'-2"		ETR (5-3/4")	╢	PAINT (PT-11)		2' 10" v 7' 0"	ETR	ETR	ETR	PAINT STAIN	
111		$\parallel \sim \sim$	<del>lk</del> ₹	CLASSRUUM 2	<del>)                                    </del>	$\parallel$ $\sim$ $\sim$	$\parallel$	1.0	<b> </b>	╂──┤	PAINT (PT-11)		2'-10" x 7'-0"		NL ) ETR	WD		
112a	TO RECEPTION 101 FROM CORRIDOR A 112	ETR	SET #23		GHN3, H5	ETR	ETR	ETR	ETR	<del>    </del>	PAINT (PT-11)		ETR	ETR	-	ETR	PAINT	
112b	TO EXTERIOR FROM CORRIDOR A 112	20 1411	SET #17	CLASSROOM	GHN3	3'-4"	ETR 7'-2"	ETR 1.0	ETR (5-3/4")	ETR	ETR PAINT (PT-11)		ETR 3'-0" x 7'-0"	ETR	ETR	ETR	ETR STAIN	
115	TO CORRIDOR A 112 FROM OPEN OFFICE 114  TO OFFICE 115 FROM OPEN OFFICE 114	20 MIN.)	SET #17	OFFICE	H2	3'-4"	7'-2"	1.0	(5-3/4")	<del> </del>	PAINT (PT-11)		3'-0" x 7'-0"	(1-3/4") (1-3/4")	NL NL	WD	STAIN	
116	TO WORKROOM 116 FROM OPEN OFFICE 114		SET #16	CLASSROOM 2		3'-4"	7'-2"	1.0	(5-3/4")	<del> </del>	PAINT (PT-11)		3'-0" x 7'-0"	(1-3/4")	(NL)	WD WD	STAIN	
110	TO RESTROOM VESTIBULE 117 FROM UNISEX RESTROOM 118		SET #18	PRIVACY		3'-4"	7'-2"	1.0	(5-3/4")	<del> </del>	PAINT (PT-11)		3'-0" x 7'-0"	(1-3/4")		WD	STAIN	
119		20 MIN.)	14 1	CLASSROOM	(H2)	3'-4"	7'-2"	1.0	(5-3/4")	<del> </del>	PAINT (PT-11)		3'-0" x 7'-0"	(1-3/4")	NL	WD	STAIN	
120	TO STORAGE 120 FROM OPEN OFFICE 119		SET #20	STOREROOM		3'-4"	7'-2"	1.0	(5-3/4")	<del> </del>	PAINT (PT-11)		3'-0" x 7'-0"	(1-3/4")	F	WD	STAIN	
121	TO OFFICE 121 FROM OPEN OFFICE 119		SET #16	OFFICE		3'-4"	7'-2"	1.0	(5-3/4")	<del> </del>	PAINT (PT-11)		3'-0" x 7'-0"	[1-3/4"]	NL	WD	STAIN	
122	TO OFFICE 122 FROM OPEN OFFICE 119		SET #16	OFFICE		3'-4"	7'-2"	1.0	(5-3/4")	<del> </del>	PAINT (PT-11)		3'-0" x 7'-0"	[1-3/4"]	NL	WD	STAIN	
123	TO STORAGE 123 FROM CORRIDOR A 112	(ETR)			GHN3	ETR	ETR	ETR	ETR	ETR	ETR		ETR	ETR	ETR	ETR	PAINT	
125	TO CORRIDOR C 142 FROM CORRIDOR B 125	$\parallel \sim \sim$	SET #11	DOUBLE EGRESS	<del>( )                                   </del>	7'-4"	7'-2"	2.1	(5-3/4")	<del>                                     </del>	PAINT (PT-11)	DF1	3'-6" x 7'-0"	[1-3/4"]	(F)	WD	STAIN	
126	TO OPEN OFFICE 126 FROM CORRIDOR B 125	20 MIN.)	SET #17	CLASSROOM	H2	3'-4"	7'-2"	1.0	(5-3/4")	<del>    </del>	PAINT (PT-11)		3'-0" x 7'-0"	[1-3/4"]	NL	WD	STAIN	
127	TO OPEN OFFICE 126 FROM CLOSET)127		SET #20	STOREROOM		3'-4"	7'-2"	1.0	(5-3/4")	+ +	PAINT (PT-11)		3'-0" x 7'-0"	[1-3/4"]	F	WD	STAIN	
128	TO OFFICE 128 FROM OPEN OFFICE 126		SET #16	OFFICE		3'-4"	7'-2"	1.0	(5-3/4")	НМ	PAINT (PT-11)		3'-0" x 7'-0"	[1-3/4"]	NL	WD	STAIN	
129	TO OFFICE 129 FROM OPEN OFFICE 126		SET #16	OFFICE		3'-4"	7'-2"	1.0	(5-3/4")	НМ	PAINT (PT-11)		3'-0" x 7'-0"	[1-3/4"]	NL	WD	STAIN	
130	TO OFFICE 130 FROM OPEN OFFICE 126		SET #16	OFFICE		3'-4"	7'-2"	1.0	(5-3/4")	НМ	PAINT (PT-11)		3'-0" x 7'-0"	[1-3/4"]	NL	WD	STAIN	
131	TO OPEN OFFICE 131 FROM CORRIDOR B 125	20 MIN.	SET #17	CLASSROOM	(H2)	3'-4"	7'-2"	1.0	(5-3/4")	НМ	PAINT (PT-11)		3'-0" x 7'-0"	[1-3/4"]	NL	WD	STAIN	
132	TO OFFICE 132 FROM OPEN OFFICE 131		SET #16	OFFICE		3'-4"	7'-2"	1.0	(5-3/4")	НМ	PAINT (PT-11)		3'-0" x 7'-0"	[1-3/4"]	NL	WD	STAIN	
134	TO CONFERENCE ROOM 134 FROM OPEN OFFICE 136		SET #16	OFFICE		3'-4"	7'-2"	1.0	(5-3/4")	НМ	PAINT (PT-11)		3'-0" x 7'-0"	[1-3/4"]	NL	WD	STAIN	
135a	TO OFFICE 135 FROM OPEN OFFICE 136		SET #16	OFFICE		3'-4"	7'-2"	1.0	(5-3/4")	НМ	PAINT (PT-11)		3'-0" x 7'-0"	[1-3/4"]	NL	WD	STAIN	
135b	TO EXTERIOR FROM OFFICE 135				GHN3	ETR	ETR	ETR	ETR	ETR	PAINT (PT-11)		ETR	ETR	ETR	ETR	PAINT	
136	TO OPEN OFFICE 136 FROM CORRIDOR B 125	20 MIN.	SET #17	CLASSROOM	H2	3'-4"	7'-2"	1.0	(5-3/4")	НМ	PAINT (PT-11)		3'-0" x 7'-0"	[1-3/4"]	NL	WD	STAIN	
137	TO EXISTING MAINTENANCE 137 FROM CORRIDOR B 125	ETR	1 ]		GHN3	ETR	ETR	ETR	ETR	ETR	PAINT (PT-11)		ETR	ETR	ETR	ETR	PAINT	
138	TO EXISTING MAINTENANCE ROOM 137 FROM EXISTING MECHANICAL 138	ETR			(GHN3)	ETR	ETR	ETR	ETR	ETR	PAINT (PT-11)		ETR	ETR	ETR	ETR	PAINT	
139	TO MENS RESTROOM 139 FROM CORRIDOR B 125		SET #19	RESTROOM		3'-4"	7'-2"	1.0	(5-3/4")	НМ	PAINT (PT-11)		3'-0" x 7'-0"	[1-3/4"]	F	WD	STAIN	
140	TO JANITOR 140 FROM CORRIDOR B 125	45 MIN.	SET #21	STOREROOM	H3	3'-4"	7'-2"	1.0	(5-3/4")	НМ	PAINT (PT-11)	DF2	3'-0" x 7'-0"	[1-3/4"]	F	WD	STAIN	
141	TO WOMENS RESTROOM 141 FROM CORRIDOR B 125		SET #19	RESTROOM		3'-4"	7'-2"	1.0	(5-3/4")	<del>                                     </del>	PAINT (PT-11)		3'-0" x 7'-0"	[1-3/4"]	F	WD	STAIN	
143	TO CORRIDOR C 142 FROM EXISTING STORAGE 143	ETR			GHN3	ETR	ETR	ETR	ETR	<del>                                     </del>	PAINT (PT-11)		ETR	ETR	ETR	ETR	PAINT	
144	TO CORRIDOR C 142 FROM EXISTING KITCHEN 144	20 MIN.	SET #17	CLASSROOM 2	H2, H3	3'-4"	7'-2"	1.0	[5-3/4"]	<del>ľ l</del>	PAINT (PT-11)	DF2	3'-0" X 7'-0"	[1-3/4"]	NL	WD	STAIN	
144a	TO EX. KITCHEN STORAGE 144A FROM EXISTING KITCHEN 144				GHN3	ETR	ETR	ETR	ETR	ETR	ETR		ETR	ETR	ETR	ETR	ETR	
144b	TO EXTERIOR FROM EXISTING KITCHEN 144			~~~~	GHN3	ETR	ETR	ETR	ETR	ETR	ETR		ETR	ETR	ETR	ETR	ETR	
145	TO RECEPTION 145 FROM CORRIDOR C 142	20 MIN.)	SET #15	SECURE	H5, H6	3'-4"	7'-2"	1.0	[5-3/4"]	НМ	PAINT (PT-11)		3'-0" x 7'-0"	[1-3/4"]	HG	WD	STAIN	
146	TO RECEPTION 145 FROM UNISEX RESTROOM 146		SET #18	PRIVACY		3'-4"	7'-2"	1.0	[5-3/4"]	-	PAINT (PT-11)		3'-0" x 7'-0"	[1-3/4"]	F	WD	STAIN	
147	TO OFFICE 147 FROM FROM RECEPTION 145		SET #16	OFFICE		3'-4"	7'-2"	1.0	(5-3/4")	<del> </del>	PAINT (PT-11)		3'-0" x 7'-0"	[1-3/4"]	NL	WD	STAIN	
148a	TO EXTERIOR FROM SECURE VESTIBULE 148		SET #4	EXIT	H4, H5	3'-4"	7'-2"	S1.1	(5-3/4")	ALUM	PREFIN		3'-0" x 7'-0"	[1-3/4"]	G	FRP	PREFIN	
148b	TO RECEPTION 145 FROM SECURE VESTIBULE 148		SET #7	EXIT	H4, H5, H6	3'-4"	7'-2"	S1.0	(5-3/4")	ALUM	PREFIN		3'-0" x 7'-0"	[1-3/4"]	G	FRP	PREFIN	D1

# LOCK FUNCTION NOTES:

SIMILAR TO SCHLAGE L9050 WITH VISUAL SECURITY INDICATOR AND ADA THUMBTURN. INDICATOR TO SAY "LOCKED/UNLOCKED, OR VON DUPRIN EXIT

DEVICE WITH SECURITY INDICATOR AND ADA THUMBTURN.

CLASSROOM 2: SIMILAR TO SCHLAGE L9070. EXIT: EXIT DEVICE WITH LEVER TRIM

OFFICE: SIMILAR TO SCHLAGE L9056.

**GENERAL HARDWARE NOTES:** 

PRIVACY: SIMILAR TO SCHLAGE L9444. RESTROOM: SIMILAR TO SCHLAGE L463 DEADBOLT (DOOR CAN BE UNLOCKED FROM INSIDE,

BUT NOT LOCKED). SECURE: SIMILAR TO SCHLAGE L9060 STOREROOM/CLASSROOM. STOREROOM FUNCTION ON RECEPTION SIDE. CLASSSROOM FUNCTION ON CORRIDOR/OFFICE SIDE.

#### STOREROOM: SIMILAR TO SCHLAGE L9080.

GHN1. LOCK FUNCTIONS INDICATED ARE APPROXIMATE. FINAL LOCK FUNCTION, ETC. TO BE DETERMINED AT SPECIAL MEETING WITH OWNER AND HARDWARE SUPPLIER SPECIFICALLY

INTENDED FOR THAT PURPOSE -REFER TO SPECIFICATIONS. GHN2. REFER TO SPECIFICATIONS FOR HARDWARE SET DESCRIPTIONS.

GHN3. REFER TO SPECIFICATIONS FOR FINISH DESIGNATIONS.

GHN4. RE-KEY EXISTING HARDWARE TO ALIGN WITH NEW KEYING SYSTEM.

## HARDWARE NOTES

- PROVIDE MAGNETIC HOLD OPEN AT FIRE DOOR.
- H2. THUMBTURN FOR VISUAL INDICATOR ORIENTATION TO BE VERTICAL (UP/DOWN) FOR UNLOCKED, HORIZONTAL (LEFT/RIGHT) FOR LOCKED.

H3. PROVIDE 180 DEGREE OPEN. H4. ADA PUSH BUTTON OPERATOR.

CARD READER. H6. REMOTE RELEASE.

H7. HM REMOVABLE MULLION. 

# **GENERAL DOOR FRAME NOTES:**

GDFN1. PROVIDE PERIMETER SEALANT. (INTERIOR AND EXTERIOR SIDES)

# DOOR FRAME NOTES

- DF1. PROVIDE DOUBLE EGRESS FRAME.
- DF2. PROVIDE 180 DEGREE OPEN.
- DF2. PROVIDE SGG IN SIDELITES. INSTALLED PER MANUFACTUERER'S REQUIREMENTS.

#### **GENERAL DOOR NOTES:**

- GD1. DO NOT SCALE DRAWING. DRAWING SCALE IS SHOWN FOR GENERAL REFERENCE ONLY.
- GD2. COORDINATE DIMENSIONS WITH MANUFACTURER.
- REFER TO SPECIFICATIONS FOR ADDITIONAL INFORMATION.
- ALL CLASSROOM DOORS TO CORRIDOR ARE TO BE FIRE RATED UNLESS NOTED OTHERWISE. REFER TO DOOR SCHEDULE FOR RATING.

## DOOR NOTES:

D1. PROVIDE SGG IN DOOR, INSTALLED PER MANUFACTURER'S REQUIREMENTS.

# LEGEND:

FRP FIBERGLASS REINFORCED POLYMER

GL GLASS

HM HOLLOW METAL IMP INSULATED METAL PANEL

PREFIN PREFINISHED

SGG SCHOOL GUARD GLASS

TEMP TEMPERED WD WOOD





# Door Schedule




Crestwood School District Cherry Hill Baptist Church Administration Relocation and Addition

Project No. 3221


A2.60

								DOOR	SCHEDUL	ЕВ									
DOOR	OOR FIRE HARDW. LOCK						FRAME INFORMATION D								DOOR INFORMATION				
NO.	OPENING LOCATION		HEADING		HARDWARE REMARKS	OPENING WIDTH	OPENING HEIGHT	FRAME ELEV.	JAMB DEPTH	FRAME MATER.	FRAME FINISH	FRAME REMARKS	DOOR SIZE	DOOR THICK.	DOOR ELEV.	DOOR MATER.	DOOR FINISH	DOOR REMARKS	
149a	TO CORRIDOR D 150 FROM EXISTING MULTI-PURPOSE 149	90 MIN.	SET #12	EXIT	H7 )	3'-4"	7'-4"	2.0	(5-3/4")	НМ	PAINT (PT-11)		(2) 3'-0" x 7'-0'	(1-3/4")	NL	НМ	PAINT		
149b	TO EXTERIOR FROM EXISTING MULTI-PURPOSE 149		SET #5	EXIT	3	3'-4"	7'-4"	S1.1	(5-3/4")	ALUM	PREFIN		3'-0" x 7'-0"	(1-3/4")	F	FRP	PREFIN		
149c	TO EXISTING KITCHEN 144 FROM EXISTING MULTI-PURPOSE 149	)				ETR	ETR	ETR	ETR	ETR	PAINT (PT-11)		ETR	ETR	ETR	ETR	ETR		
149d	TO CORRIDOR C 142 FROM EXISTING MULTI-PURPOSE 149	20 MIN.	SET #22	EXIT		3'-4"	7'-4"	1.0	(5-3/4")	) нм	PAINT (PT-11)		3'-0" x 7'-0"	(1-3/4")	NL	WD	STAIN		
149e	TO CORRIDOR C 142 FROM EXISTING MULTI-PURPOSE 149	20 MIN.	SET #22	EXIT		3'-4"	7'-4"	1.0	(5-3/4")	} нм	PAINT (PT-11)		3'-0" x 7'-0"	(1-3/4")	NL	WD	STAIN		
150a	TO CORRIDOR D 150 FROM CORRIDOR C 142	90 MIN.	SET #10	EXIT	(H1)	6'-4"	7'-4"	S2.0	(5-3/4")	НМ	PAINT (PT-11)		(2) 3'-0" x 7'-0'	(1-3/4")	NL	НМ	PAINT		
150b	TO EXTERIOR FROM CORRIDOR D 150		SET #3	EXIT		6'-6"	7'-4"	S2.2	(5-3/4")	ALUM	PREFIN		(2) 3'-0" x 7'-0'	(1-3/4")	G	FRP	PREFIN		
150c	TO EXTERIOR FROM CORRIDOR D 150		SET #2	EXIT	(H5)	6'-6"	7'-4"	S2.2	(5-3/4")	ALUM	PREFIN		(2) 3'-0" x 7'-0'	(1-3/4")	G	FRP	PREFIN		
151	TO GIRLS RESTROOMS 151 FROM CORRIDOR D 150		SET #19	RESTROOM		3'-4"	7'-4"	1.0	(5-3/4")	НМ	PAINT (PT-11)		3'-0" x 7'-0"	(1-3/4")	F	WD	STAIN		
152	TO WORKROOM 152 FROM CORRIDOR D 150	20 MIN.	SET #17	CLASSROOM	H2	3'-4"	7'-4"	1.0	(5-3/4")	НМ	PAINT (PT-11)		3'-0" x 7'-0"	(1-3/4")	NL	WD	STAIN		
153	TO BOYS RESTROOMS 153 FROM CORRIDOR D 150		SET #19	RESTROOM		3'-4"	7'-4"	1.0	(5-3/4")	НМ	PAINT (PT-11)		3'-0" x 7'-0"	(1-3/4")	F	WD	STAIN		
154	TO CORRIDOR D 150 FROM JANITOR 154	45 MIN.	SET #21	STOREROOM	H3	3'-4"	7'-4"	1,0	(5-3/4")	НМ	PAINT (PT-11)		3'-0" x 7'-0"	(1-3/4")	F	WD	STAIN		
155	TO MECHANICAL ROOM 155 FROM CORRIDOR D 150	45 MIN.	SET #21	STOREROOM		3'-4"	7'-4"	1.0	(5-3/4")	НМ	PAINT (PT-11)		3'-0" x 7'-0"	(1-3/4")	F	WD	STAIN		
156	TO CORRIDOR D 150 FROM GSRP CLASSROOM 156	20 MIN.	SET #17	CLASSROOM	H2	3'-4"	7'-4"	1.0	(5-3/4")	НМ	PAINT (PT-11)		3'-0" x 7'-0"	(1-3/4")	HG	WD	STAIN		
156a	TO RESTROOM 156a FROM GSRP CLASSROOM 156		SET #18	PRIVACY		3'-4"	7'-4"	1.0	(5-3/4")	НМ	PAINT (PT-11)		3'-0" x 7'-0"	(1-3/4")	F	WD	STAIN		
156b	TO GSRP CLASSROOM 156 FROM CLOSET 156b		SET #13	CLASSROOM 2		5'-0"	7'-4"	2.0	(5-3/4")	НМ	PAINT (PT-11)		(2) 2'-4" x 7'-0'	(1-3/4")	F	WD	STAIN		
156c	TO EXTERIOR FROM GSRP CLASSROOM 156		SET #5	EXIT		3'-4"	7'-4"	S1.4	(5-3/4")	ALUM	PAINT (PT-11)		3'-0" x 7'-0"	(1-3/4")	F	FRP	PREFIN		
157	TO CORRIDOR D 150 FROM GSRP CLASSROOM 157	20 MIN.	SET #17	CLASSROOM	H2	3'-4"	7'-4"	1.0	(5-3/4")	НМ	PAINT (PT-11)		3'-0" x 7'-0"	(1-3/4")	HG	WD	STAIN		
157a	TO RESTROOM 157a FROM GSRP CLASSROOM 157		SET #18.	PRIVACY		3'-4"	7'-4" {	1.0	(5-3/4")	НМ	PAINT (PT-11)		3'-0" x 7'-0"	(1-3/4")	F	WD	STAIN		
157b	TO GSRP CLASSROOM 157 FROM CLOSET 157b		SET #13	CLASSROOM 2		5'-0"	7'-4"	2.0	(5-3/4")	НМ	PAINT (PT-11)		(2) 2'-4" x 7'-0'	[1-3/4"]	F	WD	STAIN		
157c	TO EXTERIOR FROM GSRP CLASSROOM 157		SET #5	EXIT		3'-4"	7'-4"	S1.4	(5-3/4")	ALUM	PREFIN		3'-0" x 7'-0"	[1-3/4"]	F	FRP	PREFIN		
158	TO CORRIDOR D 150 FROM GSRP CLASSROOM 158	20 MIN.	SET #17	CLASSROOM	H2	3'-4"	7'-4"	1.0	(5-3/4")	НМ	PAINT (PT-11)		3'-0" x 7'-0"	[1-3/4"]	HG	WD	STAIN		
158a	TO RESTROOM 158a FROM GSRP CLASSROOM 158		SET #18	PRIVACY		3'-4"	7'-4"	1.0	(5-3/4")	НМ	PAINT (PT-11)		3'-0" x 7'-0"	[1-3/4"]	F	WD	STAIN		
158b	TO GSRP CLASSROOM 158 FROM CLOSET 158b		SET #13	CLASSROOM 2		5'-0"	7'-4"	2.0	(5-3/4")	НМ	PAINT (PT-11)		(2) 2'-4" x 7'-0'	[1-3/4"]	F	WD	STAIN		
158c	TO EXTERIOR FROM GSRP CLASSROOM 158		SET #5	EXIT		3'-4"	7'-4"	S1.4	(5-3/4")	ALUM	PREFIN		3'-0" x 7'-0"	[1-3/4"]	F	FRP	PREFIN		
159	TO CORRIDOR D 150 FROM GSRP CLASSROOM 159	20 MIN.	SET #17.	CLASSROOM	H2	3'-4"	7'-4	1.0	(5-3/4")	НМ	PAINT (PT-11)		3'-0" x 7'-0"	[1-3/4"]	HG	WD	STAIN		
159a	TO RESTROOM 159A FROM GSRP CLASSROOM 159		SET #18.	PRIVACY		3'-4"	7'-4'	1.0	(5-3/4")	НМ	PAINT (PT-11)		3'-0" x 7'-0"	[1-3/4"]	F	WD	STAIN		
159b	TO GSRP CLASSROOM 159 FROM CLOSET 159b		SET #13	CLASSROOM 2		5'-0"	7'-4"	2.0	(5-3/4")	НМ	PAINT (PT-11)		(2) 2'-4" x 7'-0'	(1-3/4")	F	WD	STAIN		
159c	TO EXTERIOR FROM GSRP CLASSROOM 159		SET #5	EXIT		3'-4"	7'-4"	S1.4	(5-3/4")	ALUM	PREFIN		3'-0" x 7'-0"	(1-3/4")	F	FRP	PREFIN		
160	TO CORRIDOR D 150 FROM GSRP CLASSROOM 160	20 MIN.	SET #17	CLASSROOM	H2	3'-4"	7'-4"	1.0	(5-3/4")	НМ	PAINT (PT-11)		3'-0" x 7'-0"	(1-3/4")	HG	WD	STAIN		
160a	TO RESTROOM 160a FROM GSRP CLASSROOM 160		SET #18	PRIVACY		3'-4"	7'-4"	1.0	(5-3/4")	НМ	PAINT (PT-11)		3'-0" x 7'-0"	(1-3/4")	F	WD	STAIN		
160b	TO GSRP CLASSROOM 160 FROM CLOSET 160b		SET #13	CLASSROOM 2		5'-0"	7'-4"	2.0	(5-3/4")	НМ	PAINT (PT-11)		(2) 2'-4" x 7'-0'	(1-3/4")	F	WD	STAIN		
160c	TO EXTERIOR FROM GSRP CLASSROOM 160		SET #5	EXIT		3'-4"	7'-4"	S1.4	(5-3/4")	ALUM	PREFIN		3'-0" x 7'-0"	(1-3/4")	F	FRP	PREFIN		
161	TO CORRIDOR D 150 FROM GSRP CLASSROOM 161	20 MIN.	SET #17	CLASSROOM	H2	3'-4"	7'-4"}	1.0	(5-3/4")	НМ	PAINT (PT-11)		3'-0" x 7'-0"	(1-3/4")	HG	WD	STAIN		
161a	TO RESTROOM 161a FROM GSRP CLASSROOM 161		SET #18	PRIVACY		3'-4"	7'-4"	1.0	(5-3/4")	НМ	PAINT (PT-11)		3'-0" x 7'-0"	(1-3/4")	F	WD	STAIN		
161b	TO GSRP CLASSROOM 161 FROM CLOSET 161b		SET #13	CLASSROOM 2		5'-0"	7'-4"	2.0	(5-3/4")	НМ	PAINT (PT-11)		(2) 2'-4" x 7'-0'	(1-3/4")	F	WD	STAIN		
161c	TO EXTERIOR FROM GSRP CLASSROOM 161		SET #5	EXIT		3'-4"	7'-4"	S1.4	(5-3/4")	ALUM	PREFIN		3'-0" x 7'-0"	(1-3/4")	F	FRP	PREFIN		
162	TO CORRIDOR D 150 FROM GSRP CLASSROOM 162	20 MIN.	SET #17.	CLASSR00M	H2	3'-4"	7'-4"	1.0	(5-3/4")	НМ	PAINT (PT-11)		3'-0" x 7'-0"	(1-3/4")	HG	WD	STAIN		
162a	TO RESTROOM 162a FROM GSRP CLASSROOM 162		SET #18	PRIVACY		3'-4"	7'-4" {	1.0	(5-3/4")	НМ	PAINT (PT-11)		3'-0" x 7'-0"	(1-3/4")	F	WD	STAIN		
162b	TO GSRP CLASSROOM 162 FROM CLOSET 162b		SET #13	CLASSROOM 2		5'-0"	7'-4"	2.0	(5-3/4")	НМ	PAINT (PT-11)		(2) 2'-4" x 7'-0'	(1-3/4")	F	WD	STAIN		
162c	TO EXTERIOR FROM GSRP CLASSROOM 162		SET #5	EXIT		3'-4"	7'-4"	S1.4	(5-3/4")	ALUM	PREFIN		3'-0" x 7'-0"	(1-3/4")	F	FRP	PREFIN		


#### HM FRAME ELEVATIONS:

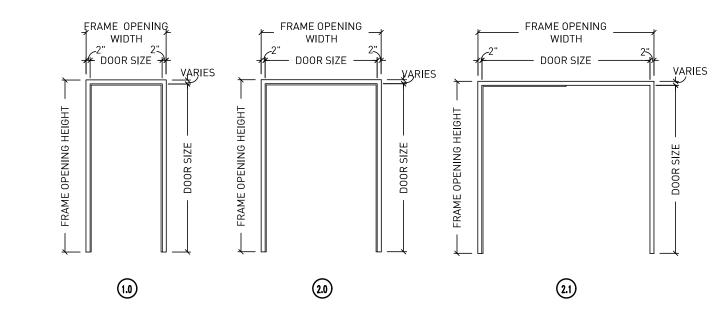



### DOOR ELEVATIONS:

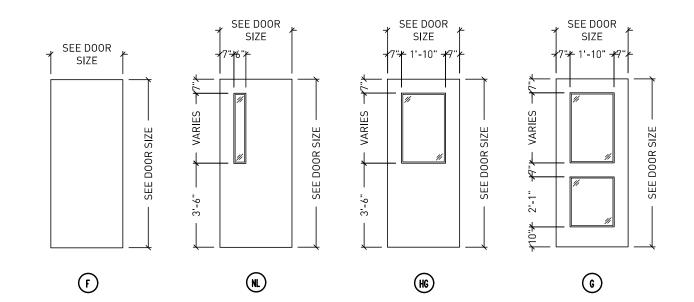



# STOREFRONT ELEVATIONS:

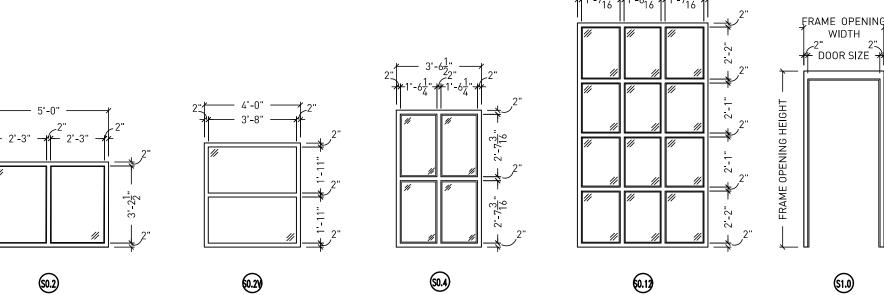

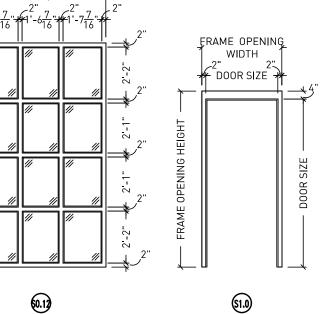


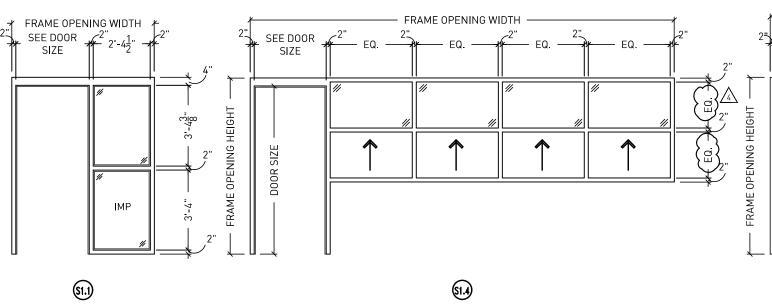

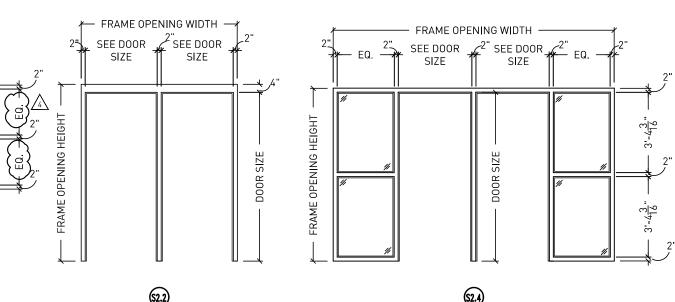


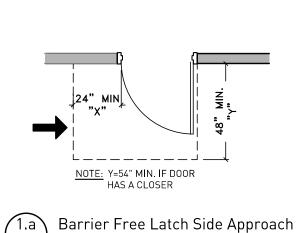



SHT Scale: 1/4"=1'-0"

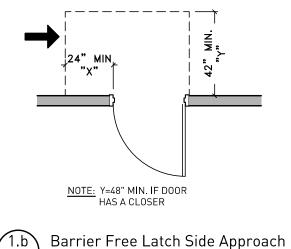


SHT Scale: 1/4"=1'-0"

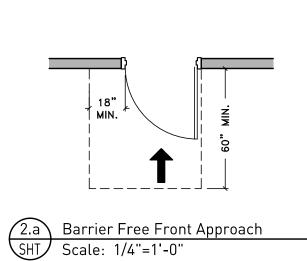

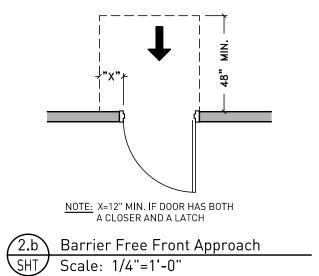

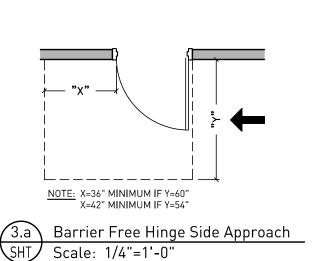

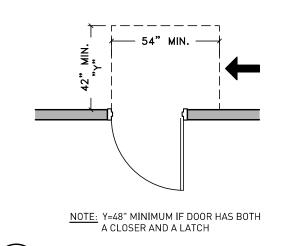

SHT | Scale: 1/4"=1'-0"

3.b Barrier Free Hinge Side Approach

LOCK FUNCTION NOTES:

SIMILAR TO SCHLAGE L9050 WITH VISUAL SECURITY INDICATOR AND ADA THUMBTURN. INDICATOR TO SAY "LOCKED/UNLOCKED, OR VON DUPRIN EXIT DEVICE WITH SECURITY INDICATOR AND ADA THUMBTURN.

CLASSROOM 2: SIMILAR TO SCHLAGE L9070. EXIT DEVICE WITH LEVER TRIM SIMILAR TO SCHLAGE L9056. OFFICE:

PRIVACY: SIMILAR TO SCHLAGE L9444. SIMILAR TO SCHLAGE L463 DEADBOLT (DOOR CAN BE UNLOCKED FROM INSIDE,

BUT NOT LOCKED). SECURE: SIMILAR TO SCHLAGE L9060 STOREROOM/CLASSROOM. STOREROOM FUNCTION ON SIMILAR TO SCHLAGE L9060 STOREROOM/CLASSROOM. STOREROOM FUNCTION ON ? RECEPTION SIDE. CLASSSROOM FUNCTION ON CORRIDOR/OFFICE SIDE.

STOREROOM: SIMILAR TO SCHLAGE L9080. GENERAL HARDWARE NOTES:

GHN1. LOCK FUNCTIONS INDICATED ARE APPROXIMATE. FINAL LOCK FUNCTION, ETC. TO BE DETERMINED AT SPECIAL MEETING WITH OWNER AND HARDWARE SUPPLIER SPECIFICALLY

INTENDED FOR THAT PURPOSE -REFER TO SPECIFICATIONS. GHN2. REFER TO SPECIFICATIONS FOR HARDWARE SET DESCRIPTIONS. GHN3. REFER TO SPECIFICATIONS FOR FINISH DESIGNATIONS.

GHN4. RE-KEY EXISTING HARDWARE TO ALIGN WITH NEW KEYING SYSTEM.

HARDWARE NOTES

PROVIDE MAGNETIC HOLD - OPEN AT FIRE DOOR. THUMBTURN FOR VISUAL INDICATOR ORIENTATION TO BE VERTICAL (UP/DOWN) FOR UNLOCKED, HORIZONTAL (LEFT/RIGHT) FOR LOCKED.

4 H4. ADA PUSH BUTTON OPERATOR. CARD READER.

REMOTE RELEASE. ∙ H6. HM REMOVABLE MULLION.

H3. PROVIDE 180 DEGREE OPEN.

GENERAL DOOR FRAME NOTES: GDFN1. PROVIDE PERIMETER SEALANT. (INTERIOR AND EXTERIOR SIDES)

DOOR FRAME NOTES

DF1. PROVIDE DOUBLE EGRESS FRAME.

DF2. PROVIDE 180 DEGREE OPEN.

DF2. PROVIDE SGG IN SIDELITES. INSTALLED PER MANUFACTUERER'S REQUIREMENTS.

**GENERAL DOOR NOTES:** DO NOT SCALE DRAWING. DRAWING SCALE IS SHOWN FOR GENERAL REFERENCE ONLY.

GD2. COORDINATE DIMENSIONS WITH MANUFACTURER.

REFER TO SPECIFICATIONS FOR ADDITIONAL INFORMATION.

ALL CLASSROOM DOORS TO CORRIDOR ARE TO BE FIRE RATED UNLESS NOTED OTHERWISE. REFER TO DOOR SCHEDULE FOR RATING.

DOOR NOTES:

PROVIDE SGG IN DOOR, INSTALLED PER MANUFACTURER'S REQUIREMENTS.

LEGEND:

FIBERGLASS REINFORCED POLYMER

GLASS

HM HOLLOW METAL IMP INSULATED METAL PANEL

PREFIN PREFINISHED

PT PAINT

SGG SCHOOL GUARD GLASS

TEMP TEMPERED WD WOOD

GENERAL STOREFRONT NOTES:

QUANTITIES AND DIMENSIONS ARE NOT GUARANTEED. CONTRACTOR IS RESPONSIBLE

FOR FIELD MEASUREMENT AND VERIFICATION OF SIZE, CONDITION AND QUANTITIES BEFORE ORDERING. INCLUDE FIELD MEASUREMENTS ON SHOP DRAWINGS.

THIS DRAWING DEPICTS GENERAL CONDITIONS AND SIZES. IT IS TO BE EXPECTED THAT VARYING SIZES AND CONDITIONS MAY BE ENCOUNTERED ONCE THE OPENINGS ARE

FIELD MEASURED.

CONTRACTOR SHALL INCLUDE ALL NECESSARY ADJUSTMENTS TO STANDARD PRODUCTS, PANNING SIZES, TRIM PIECES, BLOCKING, ETC. AS REQUIRED FOR A COMPLETE AND WEATHER-TIGHT INSTALLATION -- AT NO ADDITIONAL COST TO THE

TEMPERED GLASS ON EXTERIOR ON EXTERIOR LITE, AND ELSEWHERE AS REQUIRED BY

GS5. SCREENS REQUIRED AT ALL OPERABLE WINDOWS.

GS6. EXTERIOR PANNING COLOR TO MATCH WINDOW COLOR.

DURING CONSTRUCTION. 

CONTRACTOR TO WEATHERPROOF AND SECURE ANY OPENINGS MADE TO THE EXTERIOR



Addendum #4: 17 August 2023 Bidding and Permits: 31 July 2023


Door Schedule



Crestwood School District Cherry Hill Baptist Church Administration Relocation and Addition

Project No. 3221

A2.61

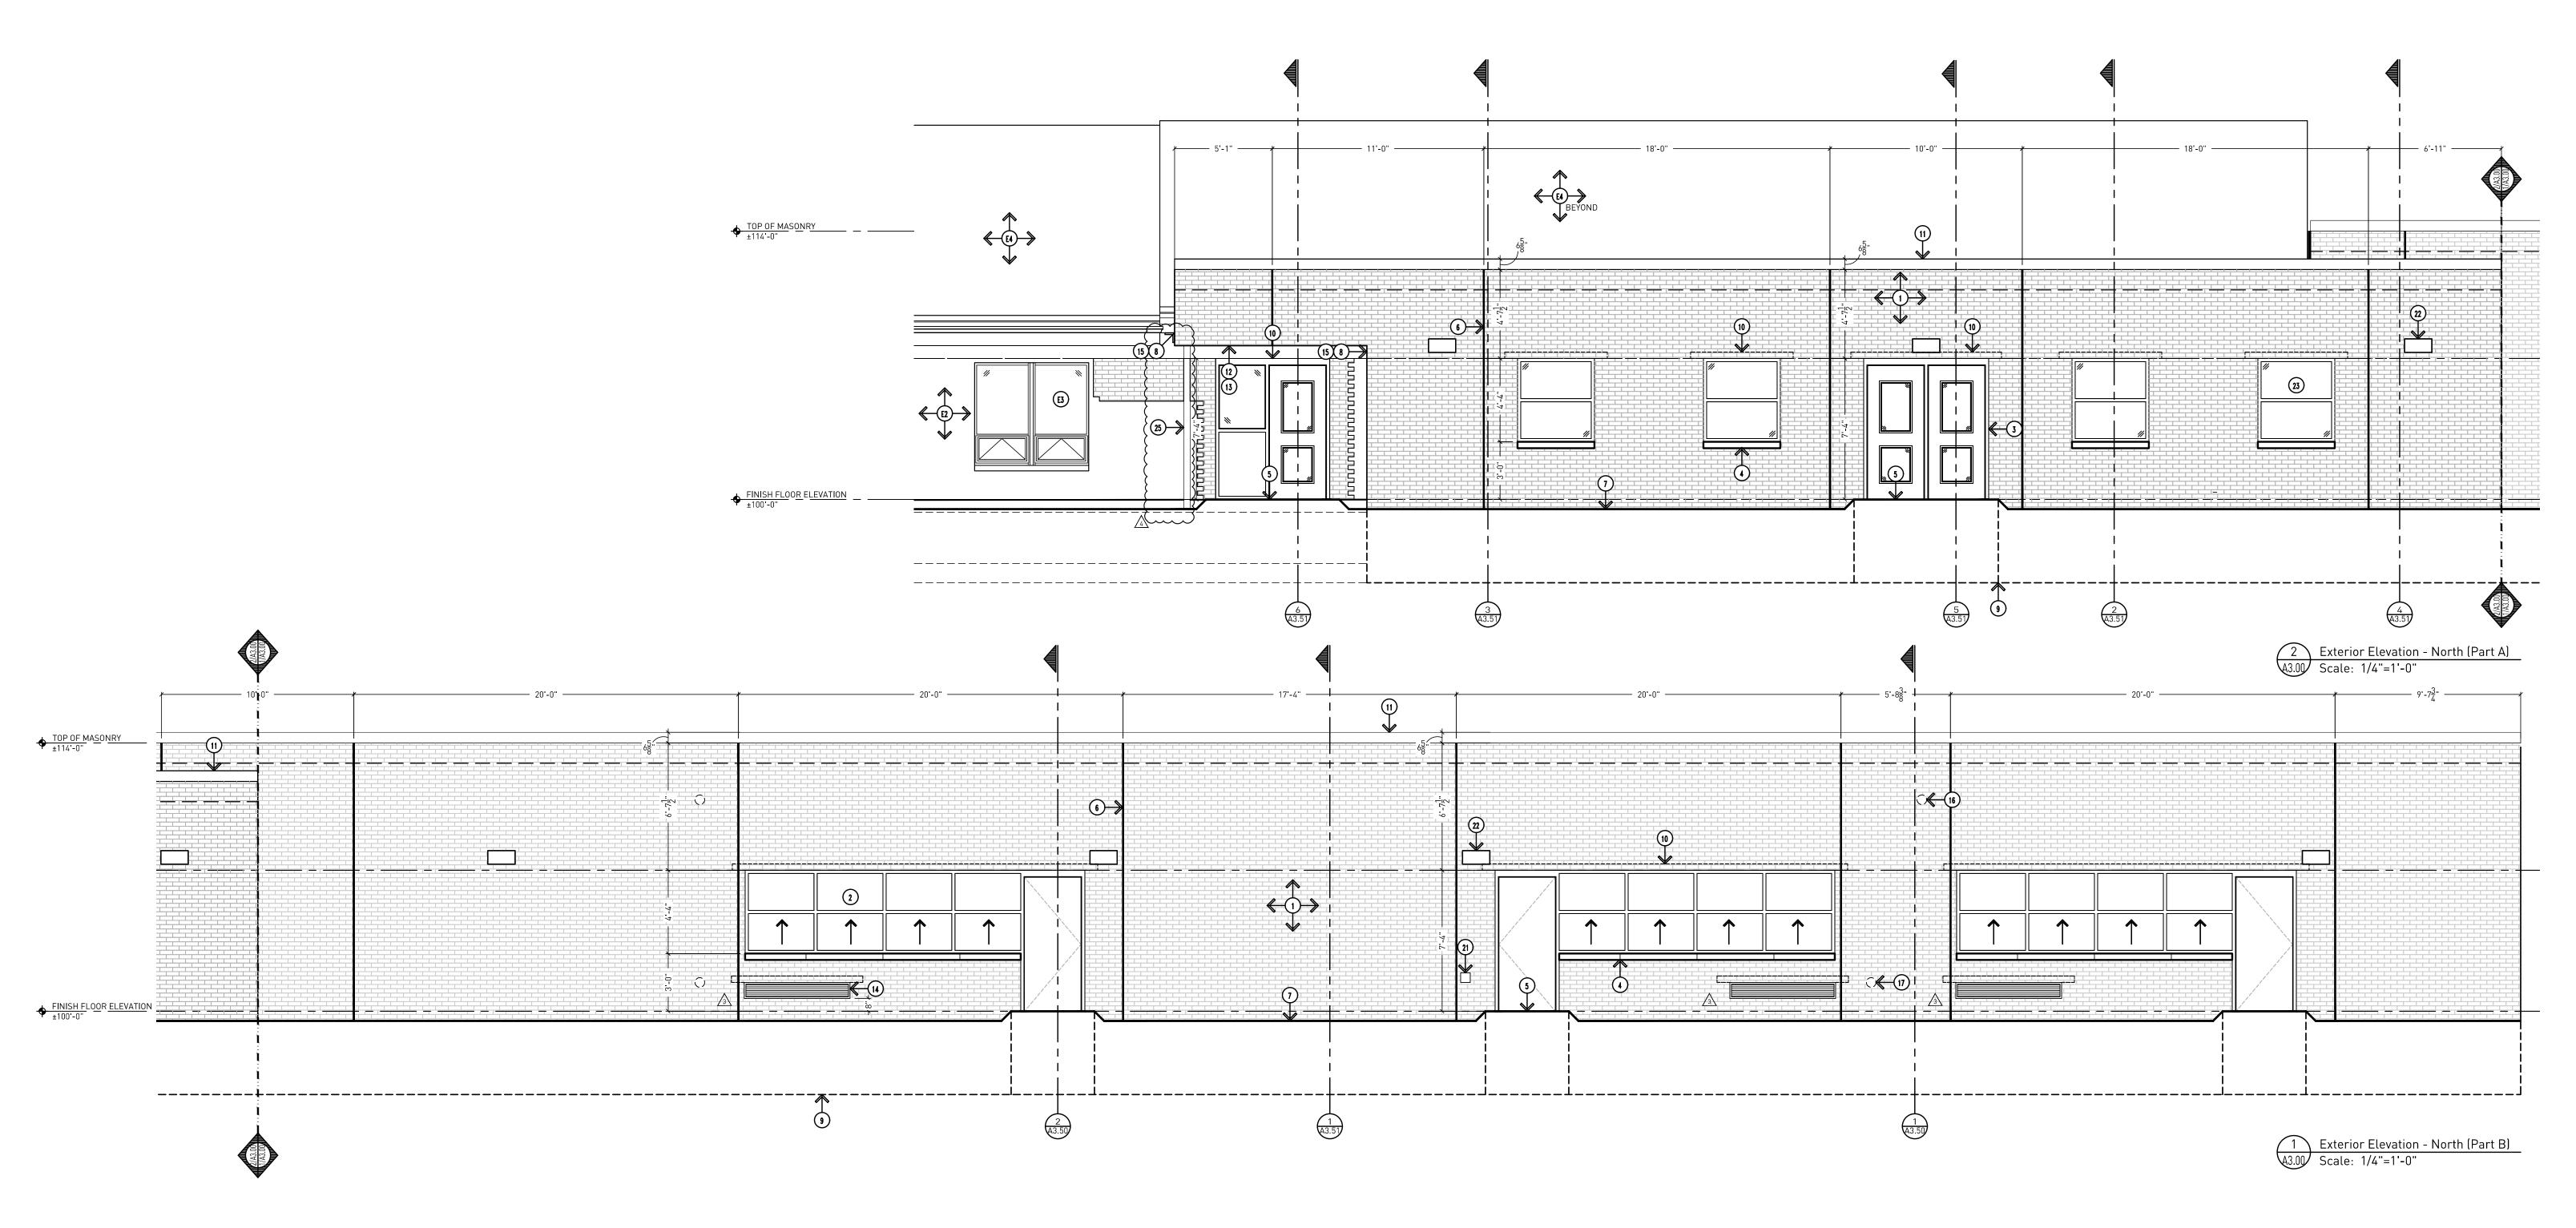

# DRAWING NOTES CONTINUED:

- 15. BUILDING JOINT COVER REFER TO DETAILS.
- 16. ROOF OVERFLOW PIPING THROUGH WALL WITH "COW TONGUE".
- 17. RAIN CONDUCTOR PIPING THROUGH WALL WITH "COW TONGUE" AND CONCRETE SPLASH
- 18. CLEAR ANODIZED INSULATED METAL PANEL WITH SMOOTH FINISH. REFER TO SPECIFICATIONS FOR FURTHER INFORMATION.
- 19. FIXED INSULATED GLASS UNIT IN EXISTING FRAME: TYPE IG-1 REFER TO SPECIFICATIONS
- FOR FURTHER INFORMATION.
- 20. FIXED INSULATED GLASS UNITS: TYPE IG-1 IN CLEAR ALUMINUM STOREFRONT FRAMING -REFER TO SPECIFICATIONS FOR FURTHER INFORMATION.
- 21. EXTERIOR WALL HYDRANT WITH LOCKING COVER REFER TO MECHANICAL DRAWINGS FOR FURTHER INFORMATION.
- 22. WALL MOUNTED LED LIGHT FIXTURE REFER TO ELECTRICAL DRAWINGS FOR FURTHER INFORMATION.
- 23. FIXED INSULATED GLASS UNITS (TYPE IG-1) IN CLEAR ALUMINUM STOREFRONT FRAMING -REFER TO DOOR SCHEDULE AND SPECIFICATIONS.
- 24. FIXED INSULATED GLASS UNITS (TYPE IG-1), FRP DOOR AND INSULATED METAL PANEL IN CLEAR ALUMINUM STOREFRONT FRAMING - REFER TO DOOR SCHEDULE AND
- SPECIFICATIONS. PAINTED STRUCTURAL COLUMN AT CANOPY - REFER TO STRUCTURAL DRAWINGS FOR

# DRAWING NOTES:

- 4" BRICK VENEER TO MATCH EXISTING; COLOR, TEXTURE, PATTERN, AND COURSING. (INSTALL HEADER COURSE EVERY 6 ROWS OF BRICK - MATCH BOND COURSING EXACTLY). --COLOR TO BE BELDEN BRICK "EMPIRE GRAY".
- VERTICAL LIFT INSULATED GLASS UNITS: (TYPE IG-1AND FRP DOOR) IN CLEAR ALUMINUM
- STOREFRONT FRAMING REFER TO DOOR SCHEDULE AND SPECIFICATIONS. 3. DOOR, FRAME, HARDWARE, AND FINISH - REFER TO DOOR SCHEDULE AND SPECIFICATIONS
- FOR FURTHER INFORMATION. LIMESTONE SILL.
- FROST SLAB. BRICK EXPANSION JOINT - PROVIDE JOINTS PER MIN. RECOMMENDATIONS. MAX 20 FT O.C. TYP. CORNER JOINTS TO BE 20 FT APART MAX WITH ONE OF THE JOINTS AT LEAST 4" AND NOT MORE THAN 10 FT FROM THE CORNER.
- APPROXIMATE LINE OF GRADE.
- 8. CONTROL JOINT BETWEEN BUILDINGS.
- 9. LINE OF FOUNDATION REFER TO STRUCTURAL DRAWINGS.
- 10. BRICK LINTEL REFER TO STRUCTURAL DRAWINGS 11. PREFINISHED METAL PARAPET CAP FLASHING WITH CONTINUOUS CLEATS ON BOTH SIDES.
- 12. CEMENT PLASTER SOFFIT.
- 13. STEEL LINTEL PAINTED. REFER TO STRUCTURAL DRAWINGS AND WALL SECTIONS. 14. LOUVER, WITH MASONRY LINTEL OVER OPENING - REFER TO MECHANICAL FOR LOUVER SIZE.

# **GENERAL NOTES:**

- G13. ALL FLEXIBLE MEMBRANE FLASHING TO BE SECURED TO SUBSTRATE WITH STAINLESS STEEL TERMINATION BAR AND SEALANT INSTALLED PER MANUFACTURER'S RECOMMENDATIONS.
- G14. PROVIDE STAINLESS STEEL DRIP WITH HEMMED EDGE ABOVE ALL WINDOW AND DOOR OPENINGS. DRIP TO STOP AT WINDOW/DOOR OPENING (DO NOT EXTEND BEYOND).
- G15. PROVIDE END DAMS AT ALL FLASHING ABOVE WINDOWS, DOORS, AND BELOW SILLS.
- G16. AT AREAS ADJACENT TO NEW BUILDING, INSTALL GRADE 6" BELOW FINISH FLOOR AND SLOPE AWAY FROM BUILDING TO MEET CODE REQUIREMENTS. MATCH ALL EXISTING SIDEWALK AND
- G17. MATCH EXISTING COURSING EXACTLY C.F.V.
- G18. MATCH EXISTING MORTAR COLOR EXACTLY C.F.V.

# **EXISTING TO REMAIN:**

PARKING ELEVATIONS.

- E1. DOOR, FRAME, AND HARDWARE.
- E2. BRICK VENEER.
- E3. PREFINISHED ALUMINUM WINDOW.
- E4. ASPHALT SHINGLE ROOF.
- E5. ATTIC VENT. E6. DOWNSPOUT.
- E7. LINE OF EXISTING BUILDING.

# **GENERAL NOTES:**

- G1. DO NOT SCALE DRAWING. DRAWING SCALE IS SHOWN FOR GENERAL REFERENCE ONLY.
- G2. ALL NOTES MAY NOT APPLY TO THIS SHEET.
- G3. FIELD VERIFY ALL EXISTING CONDITIONS PRIOR TO COMMENCING ON THE WORK.
- PROTECT ALL ITEMS TO REMAIN FORM CONSTRUCTION OPERATIONS SO AS TO NOT CAUSE
- ALL AREAS DISTURBED OR DAMAGED BY CONSTRUCTION OPERATIONS SHALL BE PATCHED, REPAIRED, AND FINISHED BACK TO EXISTING CONDITION.
- PROVIDE CONTINUOUS VAPOR AND AIR BARRIER PRIOR TO INSTALLATION OF RIGID AND/OR SPRAY INSULATION. BARRIER SYSTEM SHALL BE CONTINUOUS AROUND THE BUILDING
- ENVELOPE AND INCLUDES ALL PROPER TECHNIQUES FOR PENETRATIONS, ETC.
- PROVIDE BRICK EXPANSION JOINTS WITH SEALANT AND BACKER ROD PER MASONRY INSTITUTE RECOMMENDATIONS.
- PROVIDE SEALANT AND FOAM BACKER ROD TO SUIT CONDITIONS AROUND ALL WINDOW AND DOOR OPENINGS/PERIMETER.
- G9. REFER TO STRUCTURAL DRAWINGS FOR ANY STEPPED FOOTING LOCATION, ETC.
- G10. CONTRACTOR TO COORDINATE ALL DIMENSIONS WITH APPLICABLE MANUFACTURERS. G11. PROVIDE WEEP VENTS AT 32" O.C. AT BOTTOM AND TOP OF WALLS COMPLETE WITH 3/8"x 1 1/2" PLASTIC WEEP VENT, PROVIDE MEMBRANE FLASHING AT ALL BASE OF WALL DRAINAGE LOCATIONS, MIN 6" ABOVE FINISH GRADE.
- G12. PROVIDE ADJUSTABLE BRICK ANCHORS AT 16" O.C. VERTICALLY AND HORIZONTALLY.



Addendum #4: 17 August 2023 Addendum #3: 16 August 2023 Bidding and Permits: 31 July 2023


Exterior Elevations





Crestwood School District Cherry Hill Baptist Church


Administration Relocation and Addition

Project No. 3221

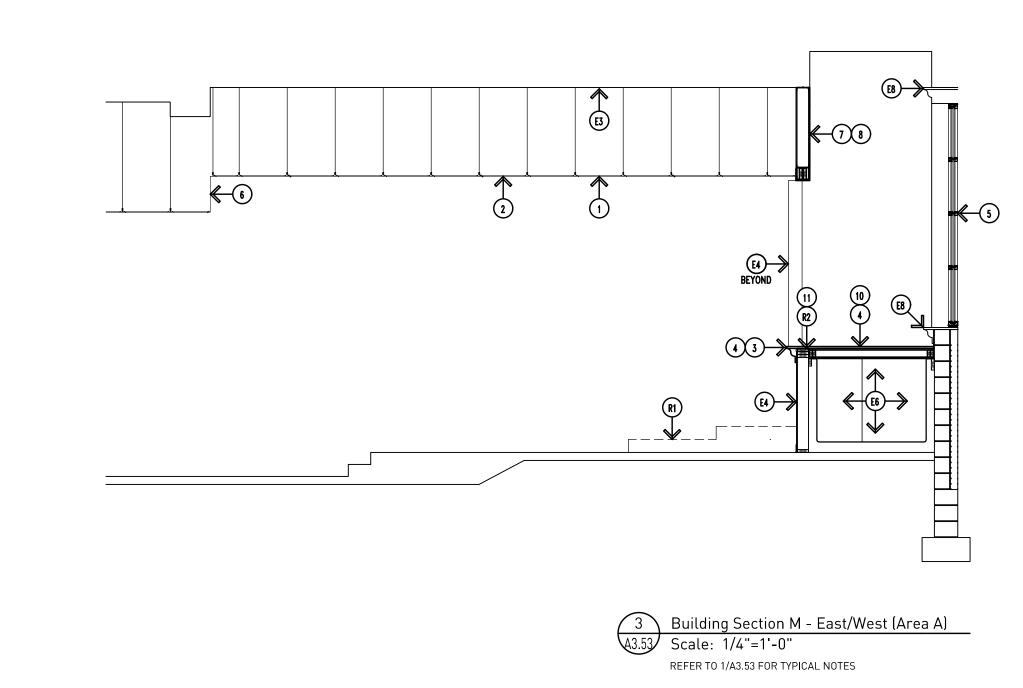

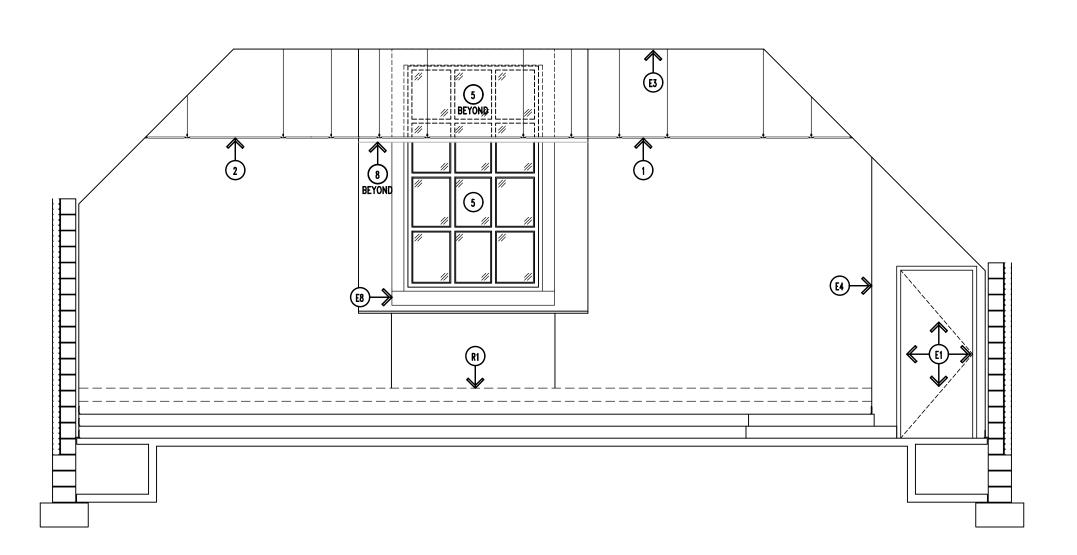

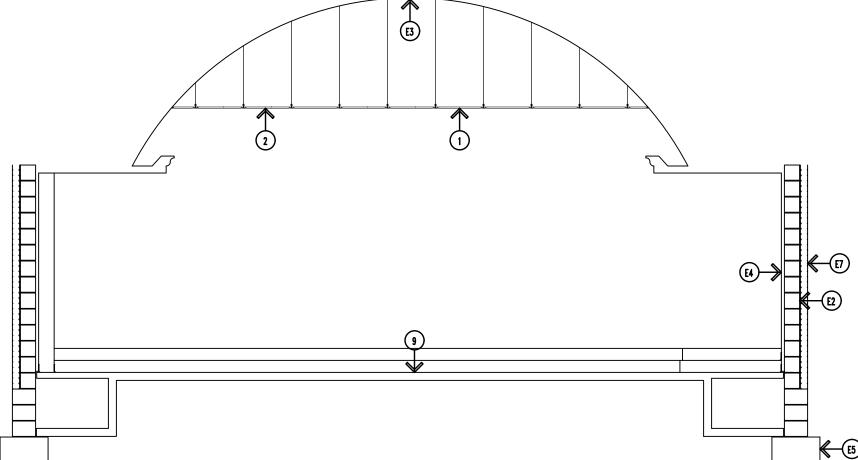

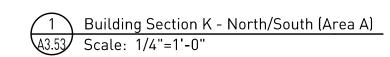

Building Section L - North/South (Area A)

A3.53 Scale: 1/4"=1'-0"

REFER TO 1/A3.53 FOR TYPICAL NOTES

# **GENERAL NOTES:**

- G1. DO NOT SCALE DRAWING. DRAWING SCALE IS SHOWN FOR GENERAL REFERENCE ONLY.
- G2. CONTRACTOR TO FIELD VERIFY ALL CONDITIONS, DIMENSIONS, ACCESS, ETC. PRIOR TO STARTING WORK.

# EXISTING TO REMAIN:

- E1. DOOR, FRAME, AND HARDWARE.
- E2. CMU BLOCK EXACT CONDITIONS UNKNOWN.
- E3. CEILING AND ROOF STRUCTURE EXACT CONDITIONS UNKNOWN.
- E4. GYPSUM BOARD WALL PATCH AND REPAIR AS NECESSARY. E5. STRUCTURAL FOOTING - EXACT CONDITIONS UNKNOWN.
- E6. BAPTISMAL FONT EXACT CONDITIONS UNKNOWN.
- E7. BRICK VENEER EXACT CONDITIONS UNKNOWN.
- E8. CROWN MOLDING- EXACT CONDITIONS UNKNOWN.


# REMOVAL NOTES:


- R1. EXISTING RISERS COMPLETE EXACT CONDITIONS UNKNOWN (C.F.V.). PATCH AND REPAIR AS NECESSARY IN PREPARATION FOR NEW FLOORING.
- R2. EXISTING WOOD TRIM COMPLETE EXACT CONDITIONS UNKNOWN (C.F.V.).

# DRAWING NOTES:

ACOUSTICAL CEILING TILE IN PREFINISHED METAL GRID SYSTEM ATTACHED TO EXISTING

- 2. LED LIGHT FIXTURE REFER TO ELECTRICAL DRAWINGS FOR FURTHER INFORMATION.
- 3. CROWN MOLDING TO MATCH EXISTING WINDOW TRIM PROFILE EXACTLY (C.F.V.).
- 4. CUSTOM WOOD STAIN TO MATCH EXISTING WINDOW TRIM MOLDING EXACTLY (C.F.V.).
- 5. STOREFRONT FRAMING AND GLAZING -- REFER TO DOOR SCHEDULE AND SPECIFICATIONS.
- 6. CUSTOM BREAK METAL TRIM (SIMILAR TO AXIOM TRIM) APPROXIMATELY 1'-6" HIGH. 7. 1/2" GYPSUM TAPED AND FINISHED THREE (3) COATS- PROVIDE LEVEL 4 FINISH AT ALL WALLS AS DEFINED BY THE GYPSUM ASSOCIATION.
- 8. 6" CONTINUOUS METAL STUD FRAMING @ 16" 0.C. WITH BOX HEADER.
- 9. FLOORING AND WALL BASE REFER TO FINISH SCHEDULE FOR FURTHER INFORMATION.
- 10. 2x4 FRAMING @ 12" O.C. TO SUPPORT NEW PLATFORM (TO BE FRAMED OVERTOP EXISTING BAPTISMAL FONT) WITH 3/4" FINISH GRADE PLYWOOD - STAINED TO MATCH EXISTING WINDOW TRIM MOLDING EXACTLY (C.F.V.). (PLATFORM IS INTENDED FOR DISPLAY PURPOSES
- 11. 2x BLOCKING CUT TO SUIT CONDITIONS.

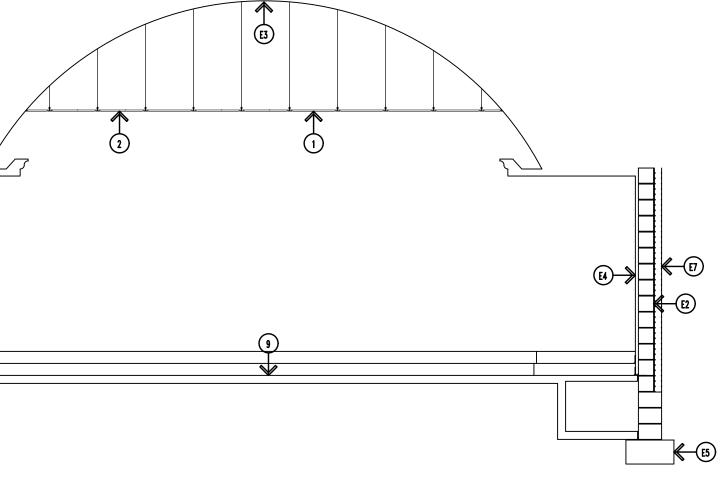

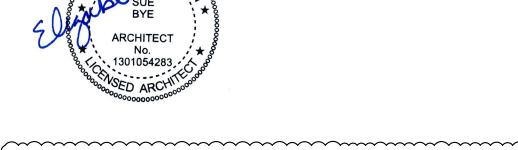


Project No. 3221


Addendum #4: 17 August 2023 Building Sections - Alternate #1 EHRESMAN

ARCHITECTS Crestwood School District Cherry Hill Baptist Church Administration Relocation and Addition


803 W. Big Beaver Road, Suite 350, Troy, MI 48084 | 248.244.9710


A3.53

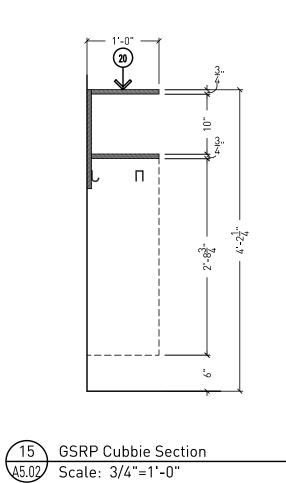


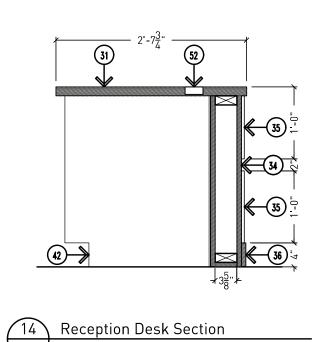



A5.02 Scale: 3/4"=1'-0"

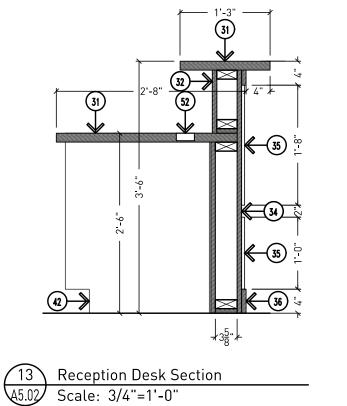


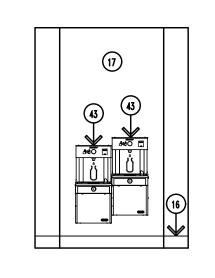


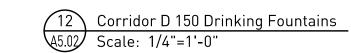

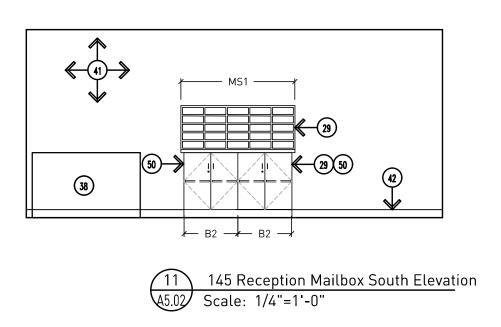


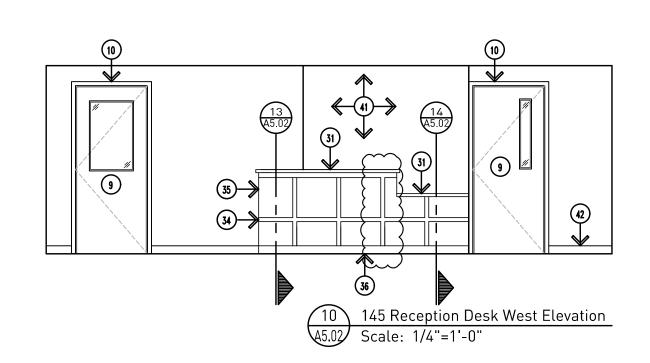


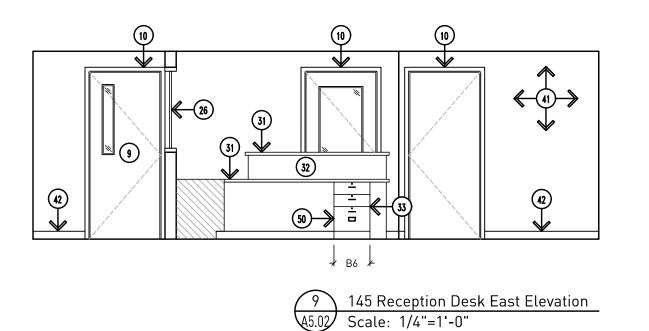

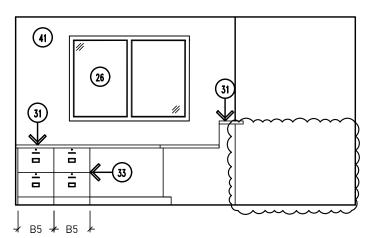



8 145 Reception Desk North Elevation A5.02 Scale: 1/4"=1'-0"

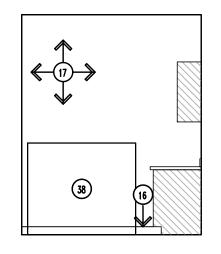


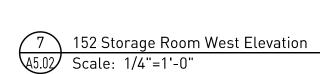



NOTE: ALL GSRP ROOMS SIMILAR

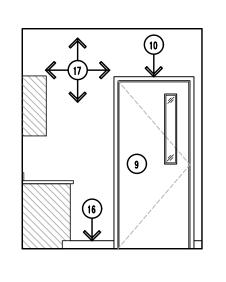


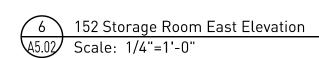


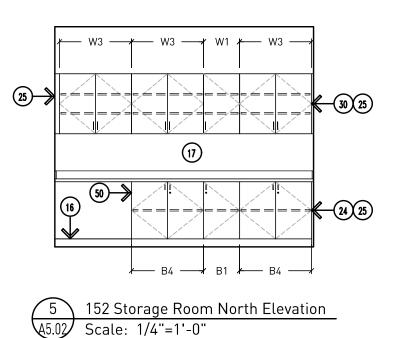


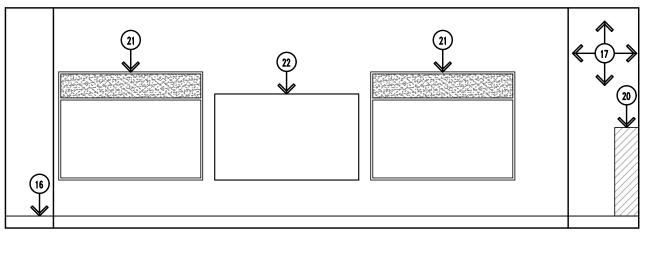

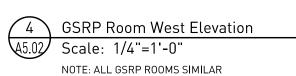

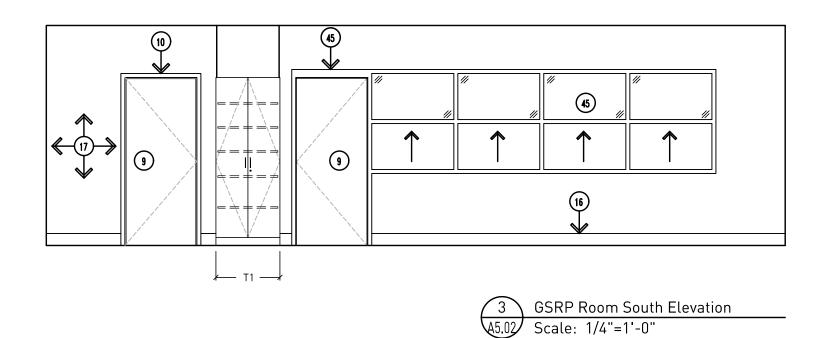

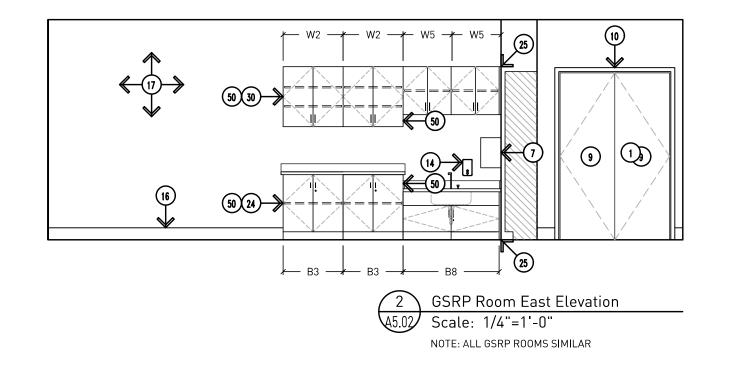

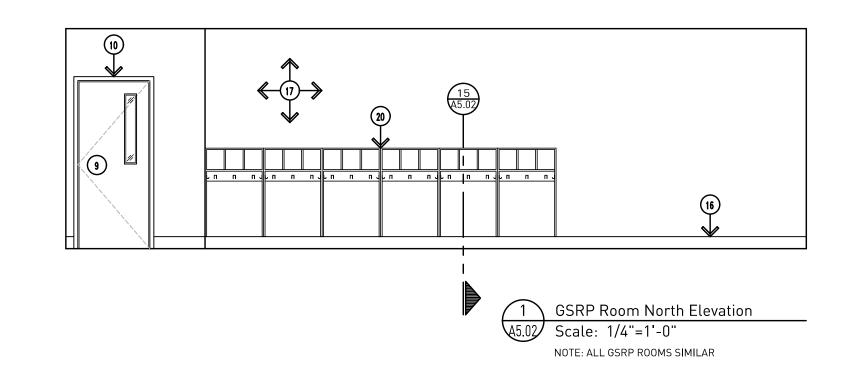

## **GENERAL NOTES:**

- G1. DO NOT SCALE DRAWING. DRAWING SCALE IS SHOWN FOR GENERAL REFERENCE ONLY.
- G2. ALL OUTSIDE CORNERS OF TILED WALLS TO HAVE TRIM PIECE SIMILAR TO SCHLUTER 'RONDEC' SIZED APPROPRIATE FOR TILE THICKNESS (SATIN ANODIZED ALUMINUM FINISH). EXPOSED TOP EDGE TO BE FINISHED WITH COORDINATING TOP CAP.

# DRAWING NOTES:

- FLOOR MOUNTED, OVERHEAD BRACED PLASTIC TOILET COMPARTMENT WITH DOOR, HINGES, SLIDE LATCH, DOOR PULL, COAT HOOK, ETC. REFER TO SPECIFICATIONS.
- WALL MOUNTED, PLASTIC URINAL SCREEN WITH CONTINUOUS WALL BRACKET. REFER TO SPECIFICATIONS.
- FLOOR MOUNTED WATERCLOSET PER ADA REQUIREMENTS WITH AUTOMATIC FLUSH VALVE.
- WALL MOUNTED URINAL WITH RIM AT 17" A.F.F. MAXIMUM AND AUTOMATIC FLUSH VALVE, PROVIDE CONCEALED CARRIER WITH TUBE STEEL SUPPORT LEGS.
- WALL MOUNTED WASH FOUNTAIN. REFER TO MECHANICAL SPECIFICATIONS.
- 6. WALL MOUNTED MIRROR. REFER TO SPECIFICATIONS.
- 7. WALL MOUNTED PAPER TOWEL DISPENSER. REFER TO SPECIFICATIONS.
- 8. TOILET PAPER DISPENSER MOUNTED PER ADA REQUIREMENTS. REFER TO SPECIFICATIONS.
- DOOR REFER TO DOOR SCHEDULE.
- 10. DOOR FRAME REFER TO DOOR SCHEDULE.
- 11. 42" STAINLESS STEEL GRAB BAR MOUNTED PER ADA REQUIREMENTS. REFER TO A00 & SPECIFICATIONS.
- 12. 36" STAINLESS STEEL GRAB BAR MOUNTED PER ADA REQUIREMENTS. REFER TO A00 &
- SPECIFICATIONS. 13. 18" STAINLESS STEEL GRAB BAR MOUNTED PER ADA REQUIREMENTS. REFER TO A00 &
- SPECIFICATIONS. 14. WALL MOUNTED SOAP DISPENSER. REFER TO SPECIFICATIONS.
- 15. SANITARY NAPKIN DISPOSAL MOUNTED PER ADA REQUIREMENTS. REFER TO SPECIFICATIONS.
- 16. CERAMIC / PORCELAIN TILE WALL BASE REFER TO FINISH SCHEDULE AND SPECIFICATIONS.
- 17. PAINTED CMU WALL REFER TO FINISH SCHEDULE.
- 18. FLOOR MOUNTED CHILD SIZE WATERCLOSET PER CHILD ADA REQUIREMENTS WITH
- AUTOMATIC FLUSH VALVE. WALL-MOUNTED LAVATORY MOUNTED PER ADA REQUIREMENTS WITH BATTERY OPERATED

FAUCET. PROVIDE CONCEALED WALL CARRIER WITH FLOOR SUPPORTS.

- 20. CUSTOM PLASTIC LAMINATE COAT CUBBIES WITH HOOKS. REFER TO SPECIFICATIONS FOR
- FURTHER INFORMATION.
- 21. WHITE BOARD/ TACKBOARD (TB-3) COMBINATION. REFER TO SPECIFICATIONS FOR FURTHER INFORMATION.
- APPROXIMATE LOCATION OF INTERACTIVE FLAT PANEL. COORDINATE BETWEEN TECHNOLOGY AND ELECTRICAL CONTRACTOR PRIOR TO ROUGH-IN. FURNISHED AND INSTALLED BY TECHNOLOGY VENDOR.
- 23. COUNTERTOP W/SIDE AND BACKSPLASH TO SUIT CONDITIONS. REFER TO FINISH / MATERIALS
- SCHEDULE. 24. BASE CABINET, REFER TO CABINET SCHEDULE.
- 25. FILLER PANEL AS REQUIRED.
- 26. LAMINATED SAFETY GLAZING IN ALUMINUM STOREFRONT.
- EXISTING WINDOW.
- 28. RECEPTION DESK. REFER TO CABINET SCHEDULE.
- 29. MAIL SLOTS. REFER TO CABINET SCHEDULE.
- 30. UPPER WALL CABINETS. REFER TO CABINET SCHEDULE.
- 31. PLASTIC LAMINATE RECEPTION DESK COUNTERTOP. REFER TO MATERIALS SCHEDULE.
- 32. TACKABLE SURFACE MATERIAL (TB-3). REFER TO MATERIALS SCHEDULE.
- 33. PLASTIC LAMINATE FILE DRAWER. REFER TO MATERIALS SCHEDULE.
- 34. PLASTIC LAMINATE REVEAL. REFER TO MATERIALS SCHEDULE.
- 35. PLASTIC LAMINATE RECEPTION DESK. REFER TO MATERIALS SCHEDULE. 36. PLASTIC LAMINATE BASE. REFER TO MATERIALS SCHEDULE.

# 37. NOT USED.

#### EXISTING OFFICE EQUIPMENT.

- 39. WALL-MOUNTED LAVATORY MOUNTED PER CHILD ADA REQUIREMENTS WITH BATTERY OPERATED FAUCET. PROVIDE CONCEALED WALL CARRIER WITH FLOOR SUPPORTS.
- 40. CERAMIC / PORCELAIN WALL TILE. REFER TO FINISH / MATERIALS SCHEDULE.
- 41. PAINTED GYPSUM WALL. REFER TO FINISH / MATERIALS SCHEDULE.
- 42. 4" COVED RUBBER BASE. REFER TO MATERIALS SCHEDULE.
- 43. ELECTRIC WATER COOLER WITH BOTTLE FILLER.
- 44. WALL MOUNTED ADJUSTABLE HEIGHT CHANGING STATION, REFER TO SPECIFICATIONS.
- 45. STOREFRONT FRAMING SYSTEM WITH GLASS. REFER TO DOOR SCHEDULE.
- 46. WASTE RECEPTACLE. REFER TO SPECIFICATIONS.
- 47. WINDOW SHADES. REFER TO MATERIALS SCHEDULE.
- 48. TOP OF MIRROR TO ALIGN WITH TOP OF TILE: BOTTOM OF MIRROR NOT TO EXCEED 40" A.F.F. PER BARRIER FREE REQUIREMENTS.
- 49. WALL MOUNTED DIAPER CHANGING STATION. REFER TO SPECIFICATIONS.
- 50. FINISHED END PANEL AS REQUIRED.
- 51. TACKBOARD (TB-3) WITH ALUMINUM FRAME. REFER TO SPECIFICATIONS.
- 53. LINE OF FURRED OUT WALL BEHIND WASH FOUNTAIN.

54. HOSE BIBB ENCLOSURE, REFER TO SPECIFICATIONS.

52. 3" GROMMET. REFER TO SPECIFICATIONS.



Addendum #4: 17 August 2023 Bidding and Permits: 31 July 2023


# Interior Elevations





Crestwood School District Cherry Hill Baptist Church Administration Relocation and Addition


Project No. 3221


A5.02

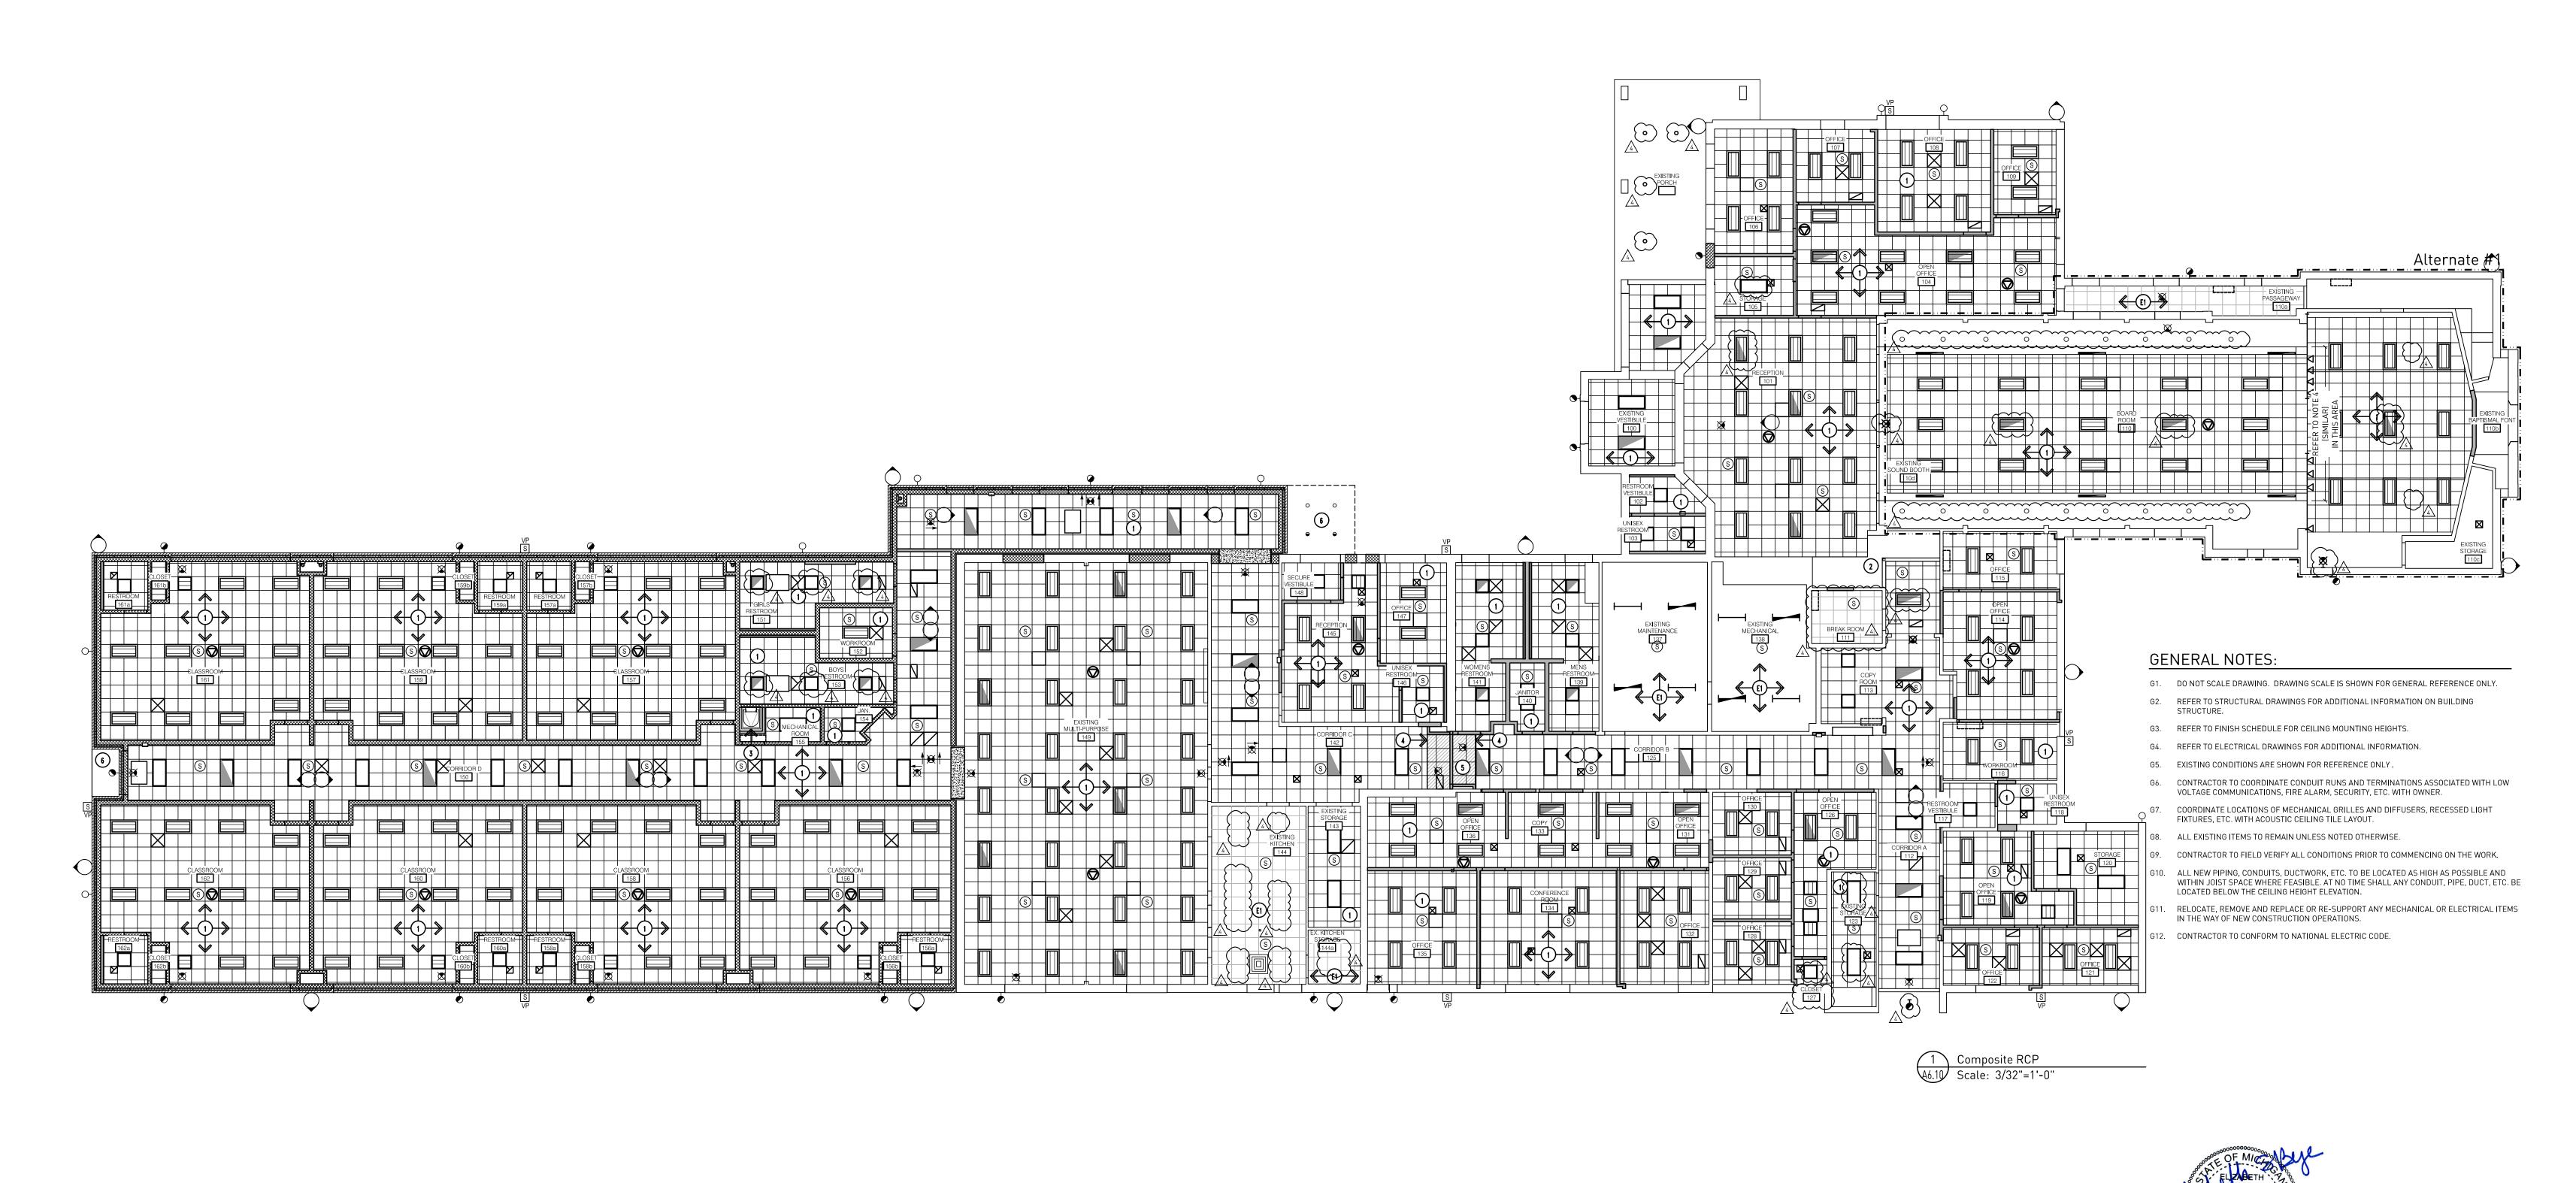

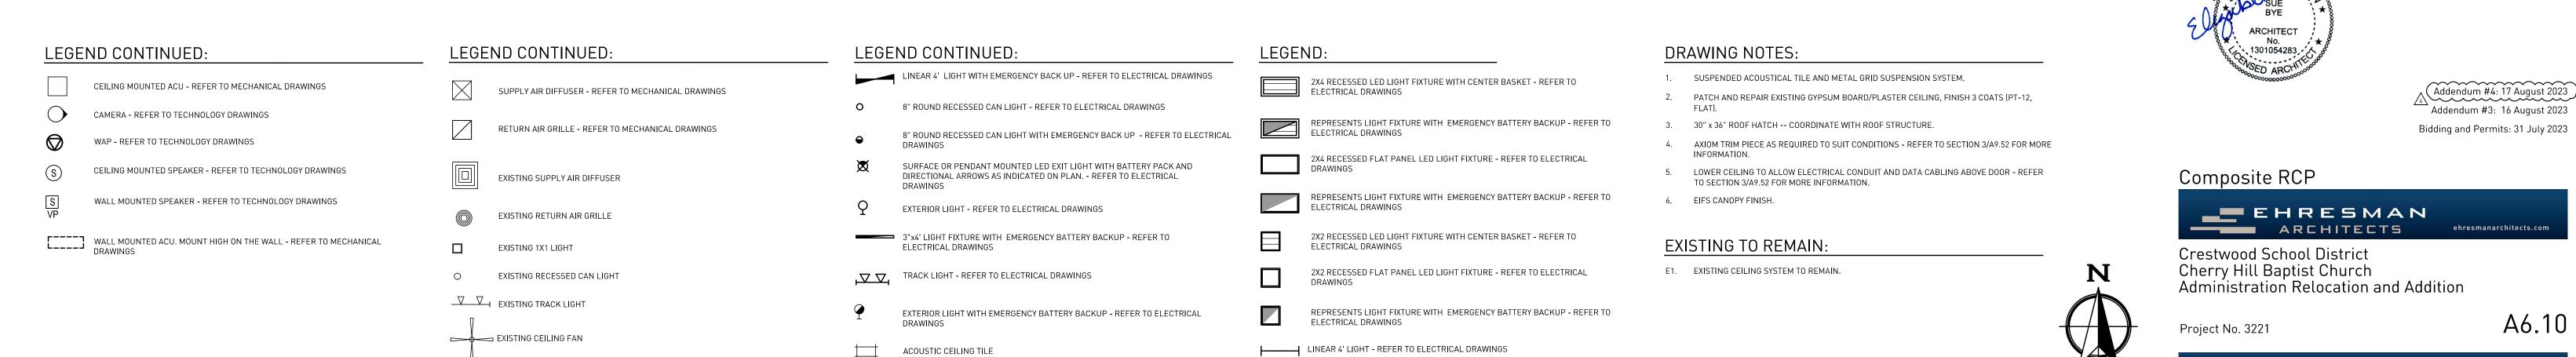

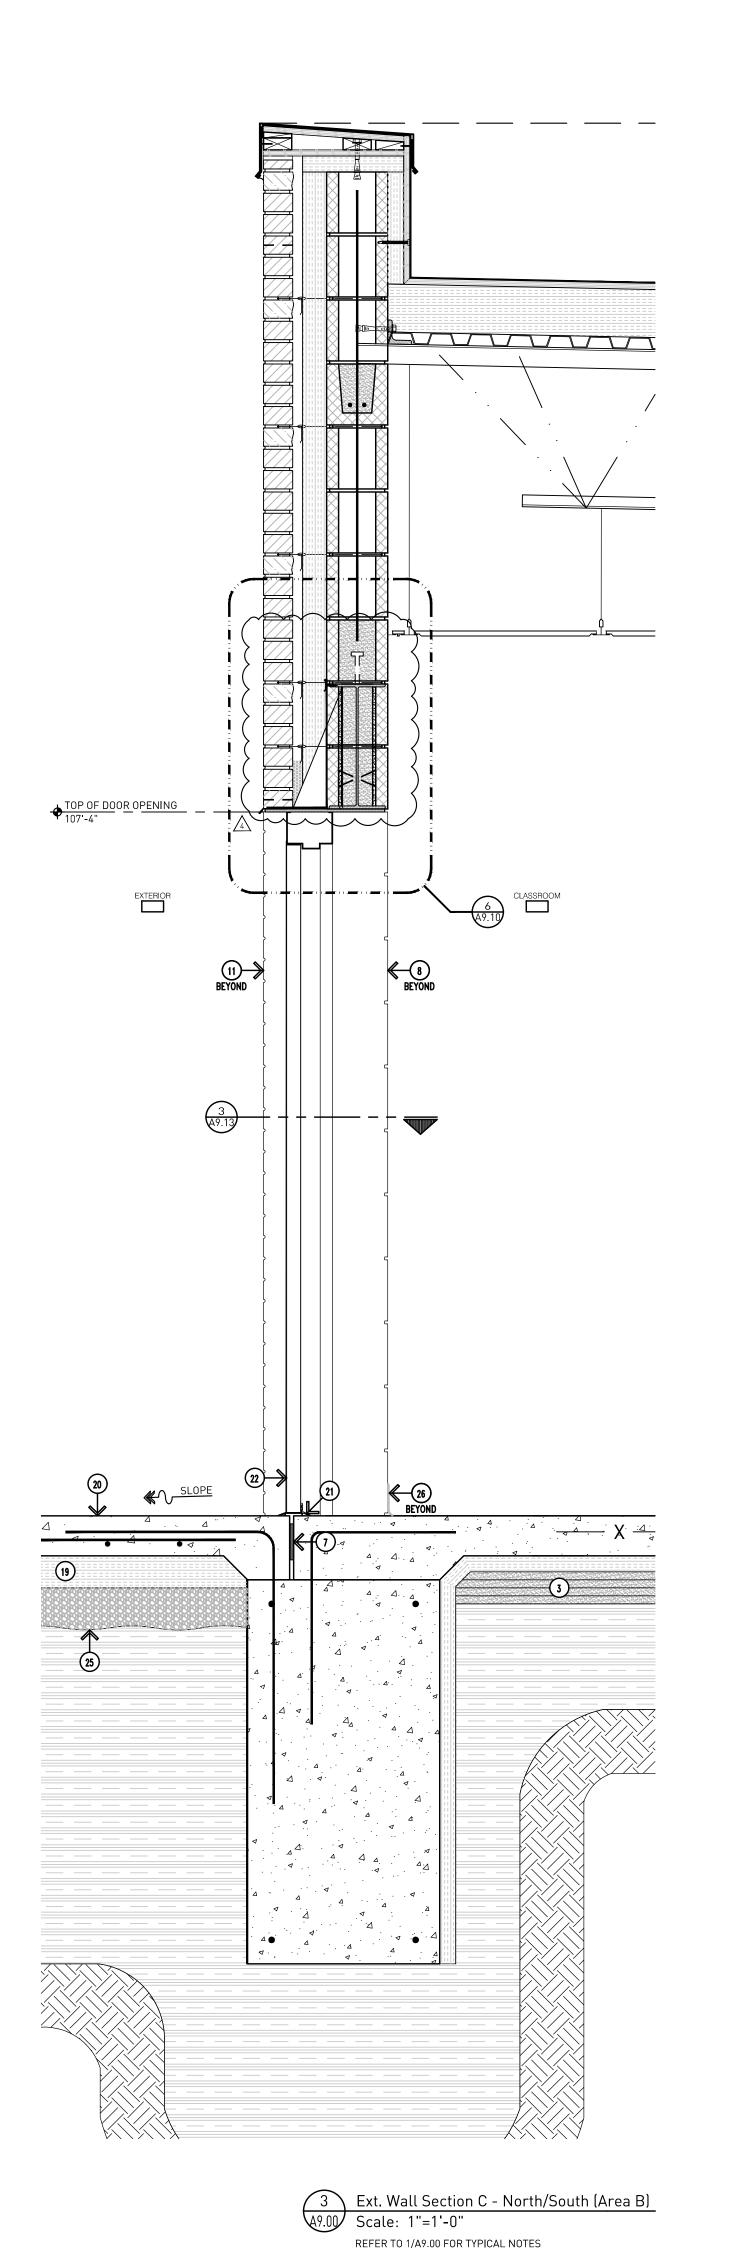

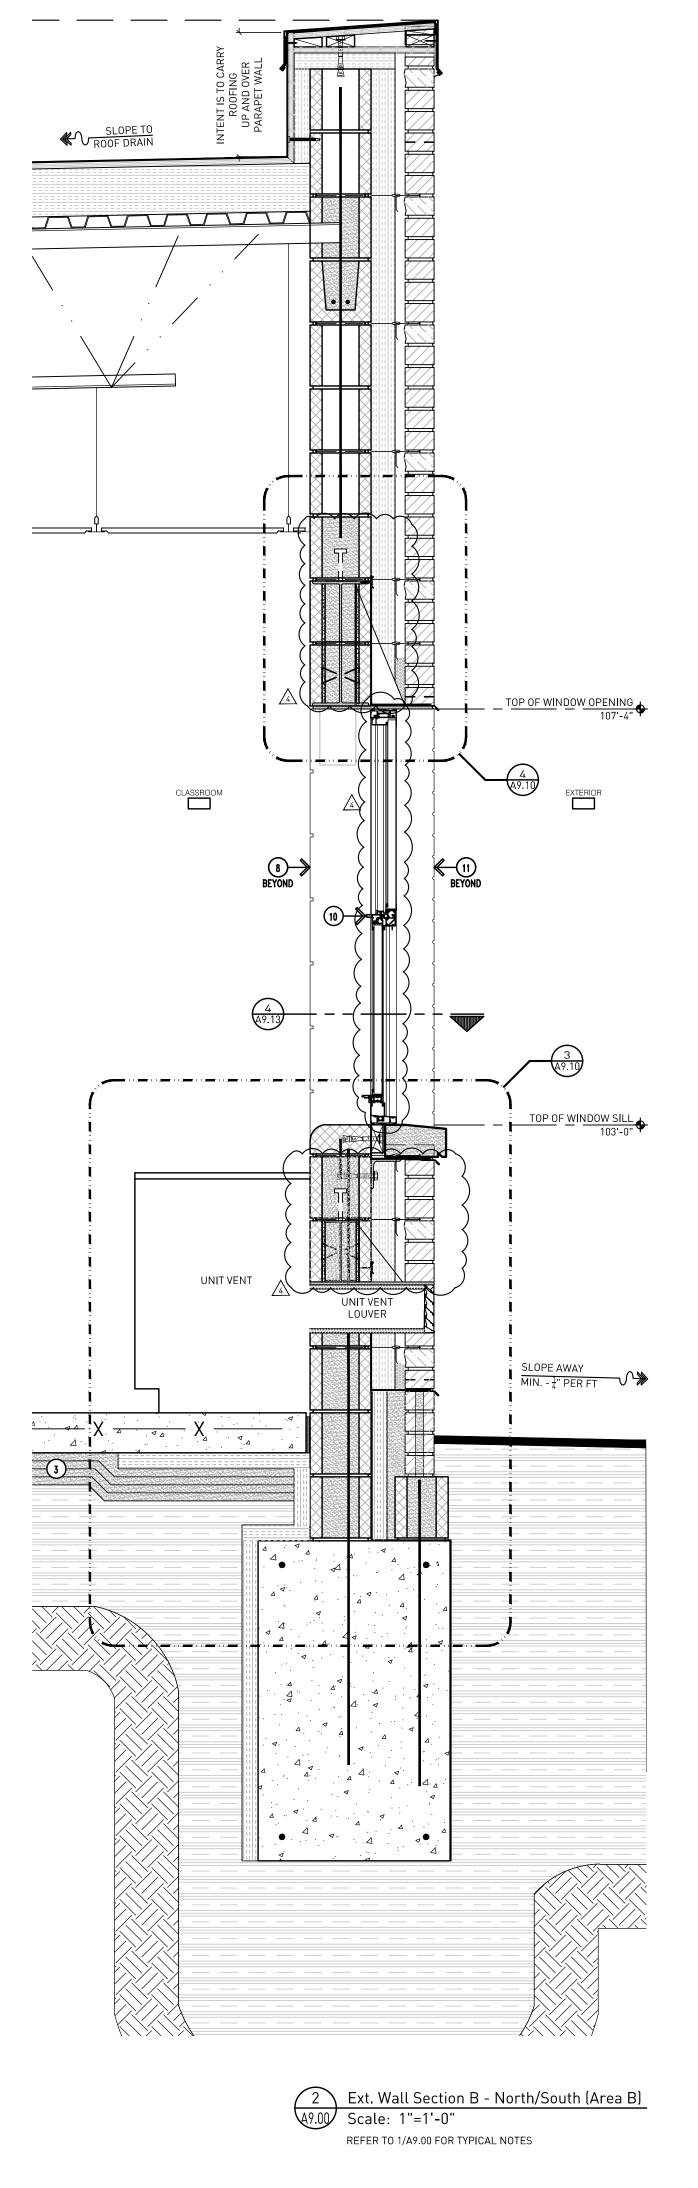

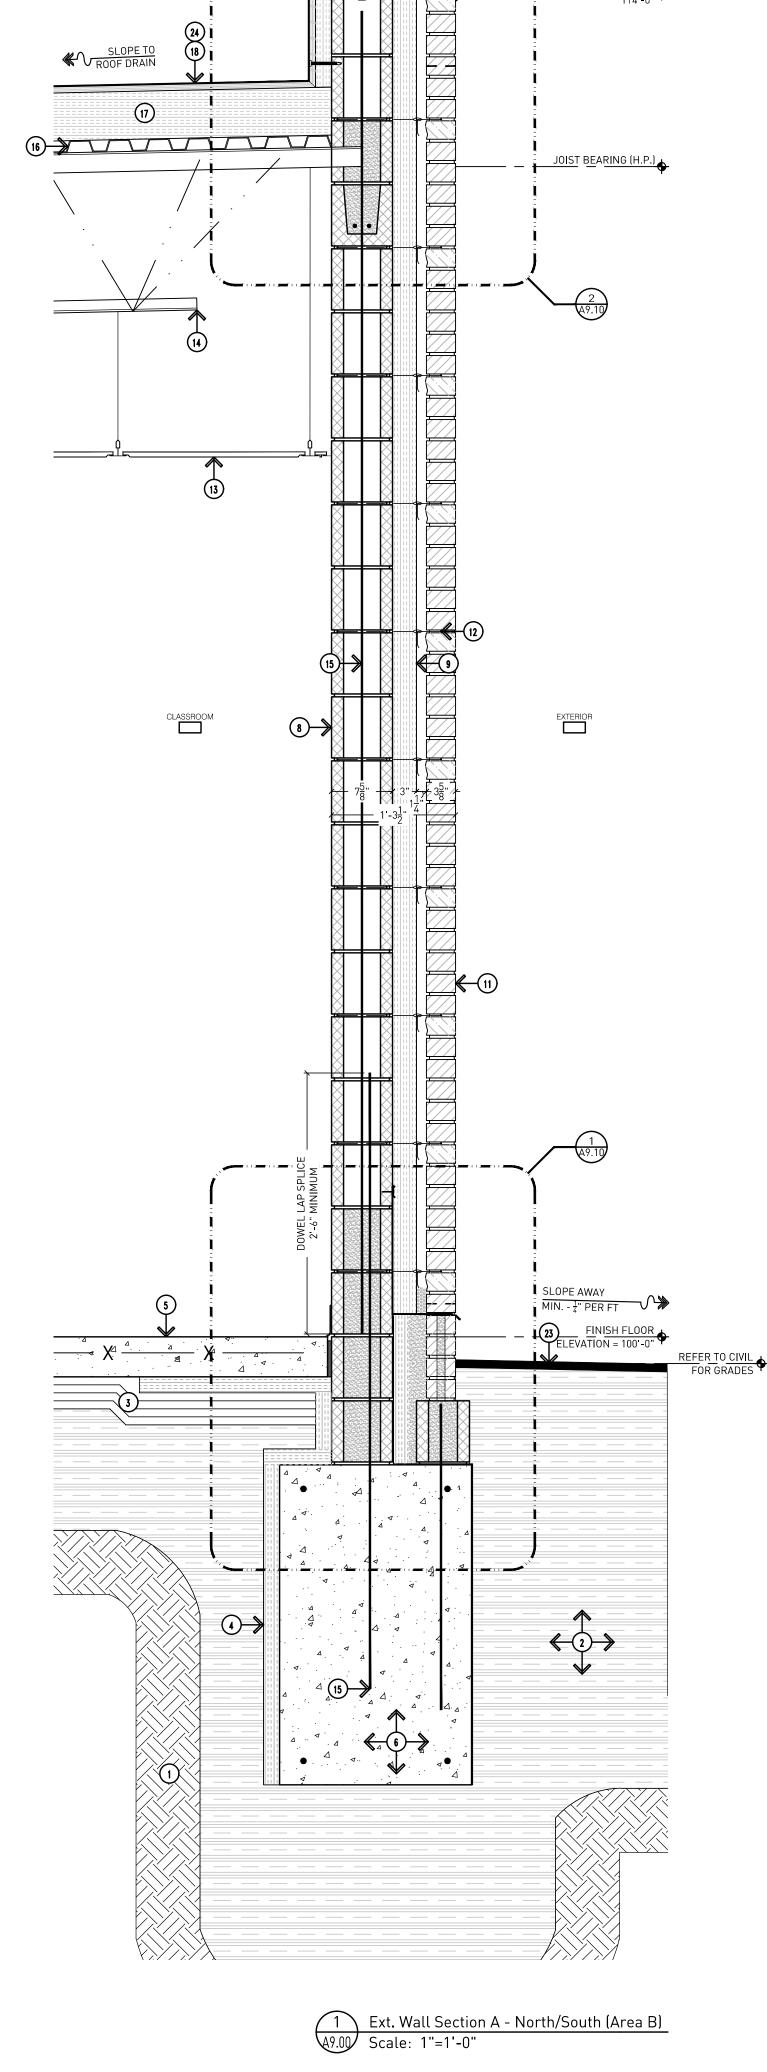

- G1. DO NOT SCALE DRAWING. DRAWING SCALE IS SHOWN FOR GENERAL REFERENCE ONLY.
- G2. PROVIDE MASONRY ANCHORS @ 16" O.C. VERTICALLY AND HORIZONTALLY.
- G3. PROVIDE NON-COM WOOD BLOCKING BEHIND ALL MISCELLANEOUS TRIM LOCATIONS AND ALL OTHER ATTACHMENT LOCATIONS WHETHER PARTICULARLY SHOWN ON THE DOCUMENTS
- G4. ALL PREFINISHED METAL COPING TO BE COMPLETE WITH CONCEALED CLIP ANCHORS ON BOTH SIDES (NO VISIBLE FASTENERS).
- G5. CARRY ROOFING UP AND OVER PARAPET CAP -- TYPICAL.
- G6. PROVIDE CONTINUOUS SPRAY-APPLIED VAPOR BARRIER COVERING FACE OF WALL AND UP AND OVER PARAPET WALL. TERMINATE WITH ROOFING PER MANUFACTURER'S REQUIREMENTS. BARRIER SYSTEM SHALL BE CONTINUOUS AROUND THE ENTIRE BUILDING ENVELOPE AND INCLUDE ALL PROPER TECHNIQUES FOR PENETRATIONS, ETC.
- G7. ALL FLEXIBLE MEMBRANE FLASHING TO BE SECURED TO SUBSTRATE WITH TERMINATION BAR AND SEALANT -- INSTALLED PER MANUFACTURER'S RECOMMENDATIONS.
- G8. FILL BRICK CORES AND COLLAR JOINTS SOLID BELOW GRADE AND BELOW ALL FLASHINGS.
- G9. PROVIDE STAINLESS STEEL DRIP WITH HEMMED EDGE ABOVE ALL EXTERIOR WINDOW AND DOOR OPENINGS.
- G10. PROVIDE MASONRY WEEP VENTS @ 32" O.C. HORIZONTALLY AT TOP AND BOTTOM OF WALL COMPLETE WITH 3/8" x 1-1/2" PLASTIC WEEP VENT AND FLEXIBLE MEMBRANE FLASHING MIN.
- G11. MASONRY CONTROL JOINTS SHOULD BE SPACED 25'-0" APART MAX. AND SHOULD NOT BE SPACED FURTHER THAN 1.5x THE WALL HEIGHT - REFER TO THE MASONRY INSTITUTE FOR FURTHER INFORMATION.

### DRAWING NOTES:

- 1. PROPERLY COMPACTED EXISTING SUBGRADE.
- COMPACTED ENGINEERED FILL AS REQUIRED AFTER REMOVAL OF EXISTING LAWN / UNSUITABLE SOILS AS REQUIRED FOR PROPER SLAB ELEVATION.
- 3. COMPACTED SAND CUSHION BASE (MINIMUM 4").
- 2" RIGID INSULATION BOARD MINIMUM 24" INSIDE BUILDING, AND VERTICALLY BEHIND
- CONCRETE FLOOR SLAB OVER 15 MIL VAPOR BARRIER -- PROPERLY LAP AND SEAL JOINTS PER MANUFACTURER'S REQUIREMENTS - REFER TO STRUCTURAL DRAWINGS.
- 6. CONCRETE FOUNDATION -- REFER TO STRUCTURAL DRAWINGS.
- 7.  $\frac{1}{2}$ " PREMOLDED EXPANSION JOINT WITH SEALANT.
- 8. CMU MASONRY BLOCK (PAINT ALL SURFACES EXPOSED TO VIEW).
- 3" SPRAY FOAM BUILDING INSULATION SYSTEM WITH INTEGRAL CONTINUOUS VAPOR
- 10. STOREFRONT FRAMING AND GLAZING -- REFER TO DOOR SCHEDULE AND DETAILS.
- 11. 4" BRICK VENEER WITH ADJUSTABLE BRICK TIES @ 16" O.C. VERTICALLY AND HORIZONTALLY
- (PROVIDE LENGTH AS REQUIRED DUE TO WALL CAVITY SIZE). 12. HORIZONTAL JOINT REINFORCING @ 16" O.C. VERTICALLY.
- ACOUSTICAL CEILING TILE IN PREFINISHED METAL GRID SYSTEM ATTACHED TO BUILDING
- STRUCTURE ABOVE.
- 14. STRUCTURAL STEEL ROOF FRAMING -- REFER TO STRUCTURAL DRAWINGS.
- 15. REINFORCING -- REFER TO STRUCTURAL DRAWINGS.
- 16.  $1\frac{1}{2}$ " GALVANIZED METAL ROOF DECK.
- 17. RIGID ROOF INSULATION BOARD (MINIMUM 6" THICKNESS -- TWO LAYERS AND COVERBOARD).
- 18. FULLY ADHERED SINGLE-PLY EPDM ROOFING -- CARRY UP AND OVER FACE OF PARAPET
- 19. INSULATION FORM REFER TO STRUCTURAL DRAWINGS.
- 20. 5" CONCRETE FROST SLAB -- SLOPE AWAY FROM BUILDING MINIMUM  $\frac{1}{4}$ " PER FOOT.
- 21. ALUMINUM THRESHOLD.
- 22. DOOR REFER TO DOOR SCHEDULE.
- 23. LINE OF GRADE.
- 24. ROOFING COVERBOARD.
- 25. DRAINAGE MATERIAL (AGGREGATE) REFER TO STRUCTURAL DRAWINGS.
- 26. WALL BASE--REFER TO FINISH SCHEDULE.



Addendum #4: 17 August 2023
Bidding and Permits: 31 July 2023

**Exterior Wall Sections** 



Crestwood School District Cherry Hill Baptist Church
Administration Relocation and Addition

Project No. 3221


A9.00


## DRAWING NOTES (CONT.):


- 44. LINE OF GRADE.
- 45. WINDOW SHADE. 46. MINIMUM 4" CONCRETE PATCH ABOVE FOUNDATION AT LOCATION OF NEW WALL OPENING.
- 47. INSULATION FORM REFER TO STRUCTURAL DRAWINGS.
- 48. DRAINAGE MATERIAL (AGGREGATE) REFER TO STRUCTURAL DRAWINGS.
- 49. ALUMINUM THRESHOLD.
- 50. WALL BASE--REFER TO FINISH SCHEDULE.


### DRAWING NOTES (CONT.)

- 38. GROUT CMU CORES SOLID BELOW FLASHING AT WHERE BELOW GRADE.
- 39. FILL BRICK/CMU CORES AND COLLAR JOINTS SOLID BELOW FLASHING AND WHERE BELOW
- 40. DOOR FRAME REFER TO DOOR SCHEDULE.
- 41. DOOR REFER TO DOOR SCHEDULE.
- 42. JAMB ANCHOR TO SUIT CONDITIONS.
- 43. WATERPROOFING.

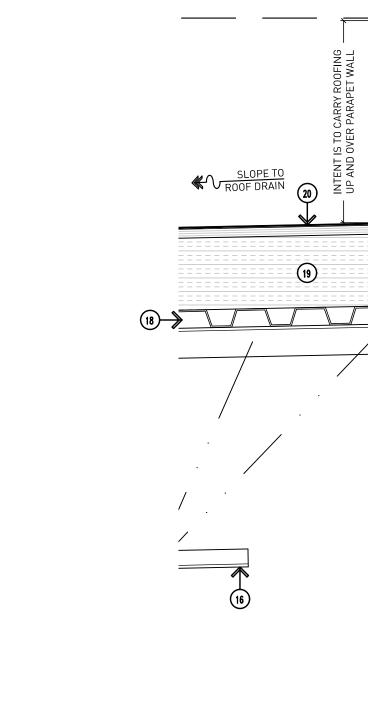

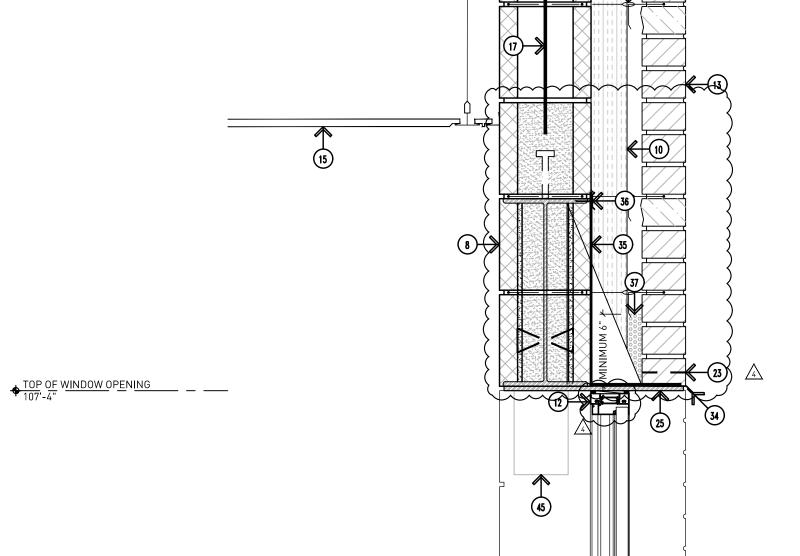

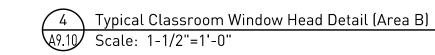

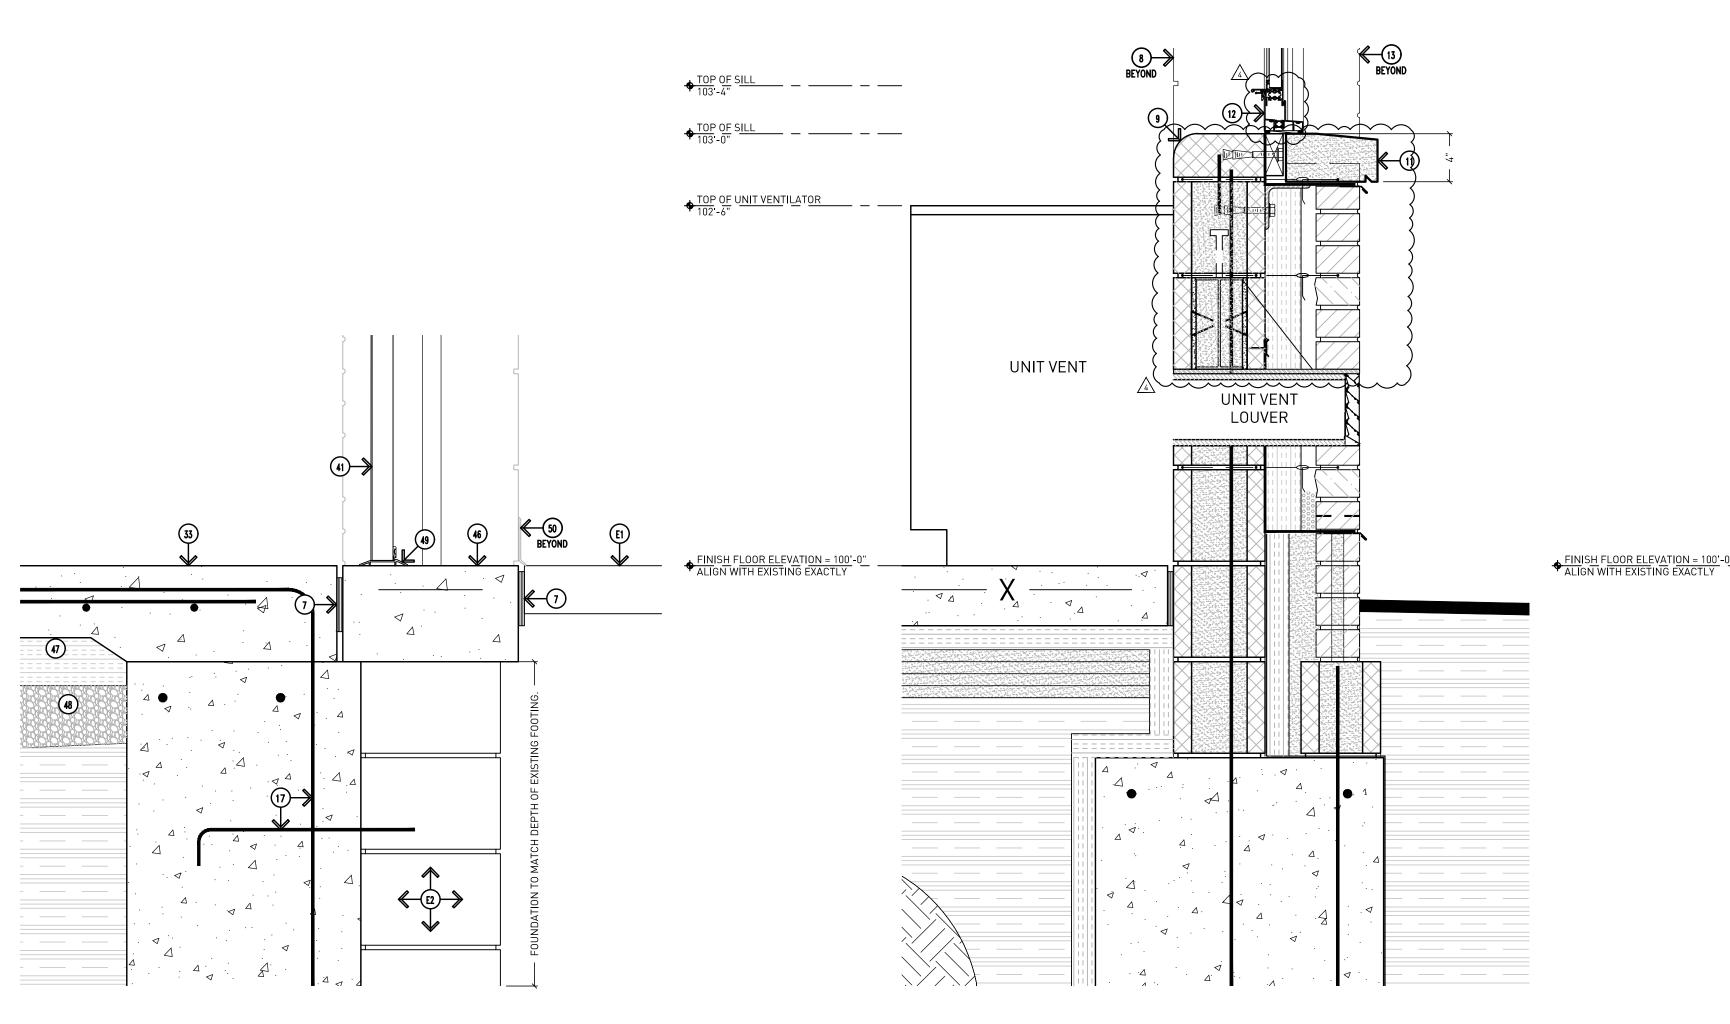



Typical Egress Door Head Detail (Area B)


5 Frost Slab/Floor Infill (Area A)

REFER TO 1/A9.10 FOR TYPICAL NOTES

A9.10 Scale: 1-1/2"=1'-0"

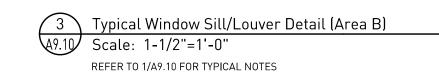

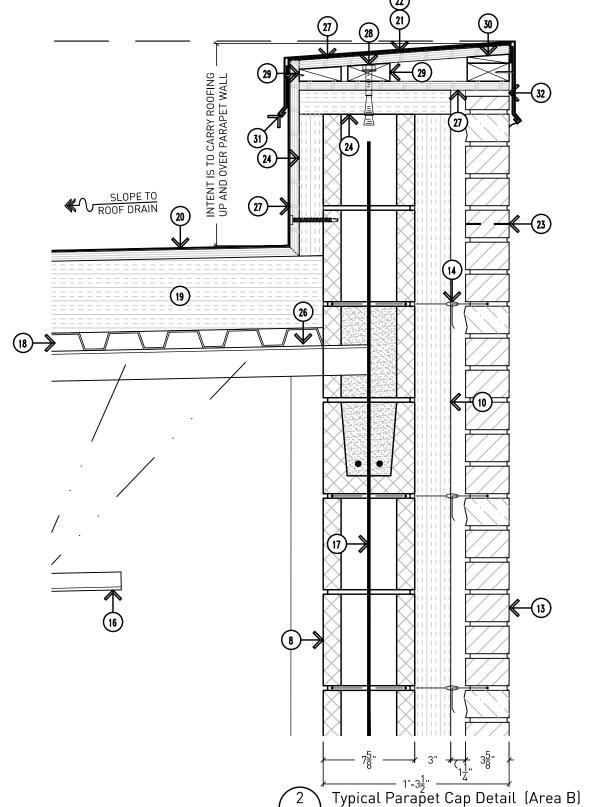

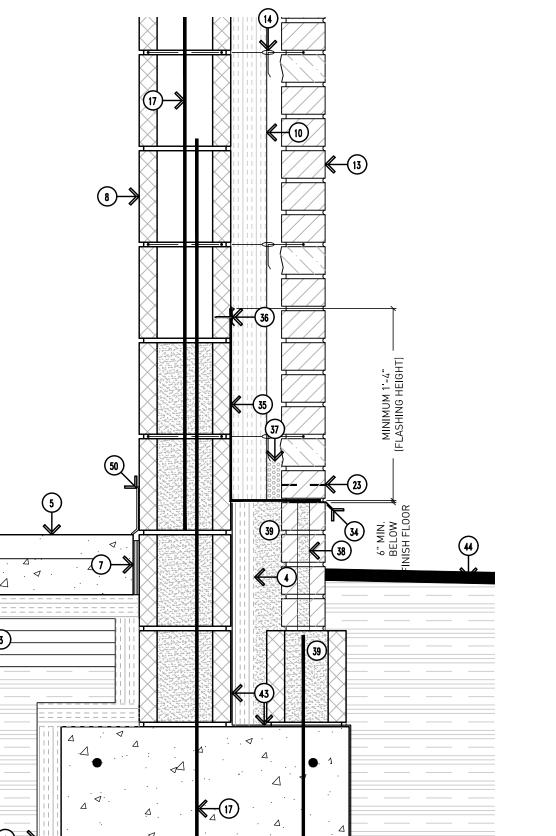

Typical Base of Wall (Area B)

A9.10 Scale: 1-1/2"=1'-0"

#### **GENERAL NOTES:**

- G1. DO NOT SCALE DRAWING. DRAWING SCALE IS SHOWN FOR GENERAL REFERENCE ONLY.
- G2. NOT ALL NOTES ARE APPLICABLE TO THIS SHEET.
- G3. PROVIDE MASONRY ANCHORS @ 16" O.C. VERTICALLY AND HORIZONTALLY.
- G4. PROVIDE NON-COM WOOD BLOCKING BEHIND ALL MISCELLANEOUS TRIM LOCATIONS AND ALL OTHER ATTACHMENT LOCATIONS WHETHER PARTICULARLY SHOWN ON THE DOCUMENTS
- G5. ALL PREFINISHED METAL COPING TO BE COMPLETE WITH CONCEALED CLIP ANCHORS ON BOTH SIDES (NO VISIBLE FASTENERS).
- G6. CARRY ROOFING UP AND OVER PARAPET CAP -- TYPICAL.
- PROVIDE CONTINUOUS SPRAY-APPLIED VAPOR BARRIER COVERING FACE OF WALL AND UP AND OVER PARAPET WALL. TERMINATE WITH ROOFING PER MANUFACTURER'S REQUIREMENTS. BARRIER SYSTEM SHALL BE CONTINUOUS AROUND THE ENTIRE BUILDING ENVELOPE AND INCLUDE ALL PROPER TECHNIQUES FOR PENETRATIONS, ETC.
- G8. ALL FLEXIBLE MEMBRANE FLASHING TO BE SECURED TO SUBSTRATE WITH TERMINATION BAR AND SEALANT -- INSTALLED PER MANUFACTURER'S RECOMMENDATIONS.
- G9. FILL BRICK CORES AND COLLAR JOINTS SOLID BELOW GRADE AND BELOW ALL FLASHINGS.
- G10. PROVIDE STAINLESS STEEL DRIP WITH HEMMED EDGE ABOVE ALL EXTERIOR WINDOW AND
- G11. PROVIDE MASONRY WEEP VENTS @ 32" O.C. HORIZONTALLY AT TOP AND BOTTOM OF WALL COMPLETE WITH 3/8" x 1-1/2" PLASTIC WEEP VENT AND FLEXIBLE MEMBRANE FLASHING MIN.
- G12. MASONRY CONTROL JOINTS SHOULD BE SPACED 25'-0" APART MAX. AND SHOULD NOT BE SPACED FURTHER THAN 1.5x THE WALL HEIGHT - REFER TO THE MASONRY INSTITUTE FOR FURTHER INFORMATION.

### **EXISTING TO REMAIN NOTES:**

- E1. CONCRETE FLOOR SLAB EXACT CONDITIONS UNKNOWN.
- E2. STRUCTURAL FOOTING EXACT CONDITIONS UNKNOWN. CONTRACTOR TO FIELD VERIFY

## DRAWING NOTES:

- 1. PROPERLY COMPACTED EXISTING SUBGRADE.
- COMPACTED ENGINEERED FILL AS REQUIRED AFTER REMOVAL OF EXISTING LAWN / UNSUITABLE SOILS AS REQUIRED FOR PROPER SLAB ELEVATION.
- 3. COMPACTED SAND CUSHION BASE (MINIMUM 4").
- 2" RIGID INSULATION BOARD MINIMUM 24" INSIDE BUILDING, AND VERTICALLY BEHIND
- CONCRETE FLOOR SLAB OVER 15 MIL VAPOR BARRIER -- PROPERLY LAP AND SEAL JOINTS PER MANUFACTURER'S REQUIREMENTS - REFER TO STRUCTURAL DRAWINGS.
- 6. CONCRETE FOUNDATION -- REFER TO STRUCTURAL DRAWINGS.
- 7.  $\frac{1}{2}$ " PREMOLDED EXPANSION JOINT WITH SEALANT.
- 8. CMU MASONRY BLOCK (PAINT ALL SURFACES EXPOSED TO VIEW).
- BULLNOSE CMU MASONRY BLOCK.
- 3" SPRAY FOAM BUILDING INSULATION SYSTEM WITH INTEGRAL CONTINUOUS VAPOR BARRIER AND ACCESSORIES AS REQUIRED TO PROVIDE BARRIER FROM FOUNDATION TO ROOFING.
- 11. LIMESTONE WINDOW SILL AND PROFILE TO MATCH EXISTING.
- 12. STOREFRONT FRAMING AND GLAZING -- REFER TO WINDOW SCHEDULE AND DETAILS.
- 13. 4" BRICK VENEER WITH ADJUSTABLE BRICK TIES @ 16" O.C. VERTICALLY AND HORIZONTALLY
- (PROVIDE LENGTH AS REQUIRED DUE TO WALL CAVITY SIZE). 14. HORIZONTAL JOINT REINFORCING @ 16" O.C. VERTICALLY.
- ACOUSTICAL CEILING TILE IN PREFINISHED METAL GRID SYSTEM ATTACHED TO BUILDING
- 16. STRUCTURAL STEEL ROOF FRAMING -- REFER TO STRUCTURAL DRAWINGS.
- 17. REINFORCING -- REFER TO STRUCTURAL DRAWINGS.
- 18.  $1\frac{1}{2}$ " GALVANIZED METAL ROOF DECK.

STRUCTURE ABOVE.

- 19. RIGID ROOF INSULATION BOARD (MINIMUM 6" THICKNESS -- TWO LAYERS AND COVERBOARD).
- 20. FULLY ADHERED SINGLE-PLY EPDM ROOFING -- CARRY UP AND OVER FACE OF PARAPET
- 21. PARAPET WALL BLOCKING -- REFER TO DETAIL 9/A9.14 FOR FURTHER INFORMATION.
- 22. PREFINISHED METAL PARAPET CAP FLASHING WITH CONCEALED CLIP ANCHORS BOTH SIDES (NO EXPOSED FASTENERS).
- 23.  $\frac{3}{8}$ " x 1  $\frac{1}{2}$ " PLASTIC WEEP VENT WITH INSECT SCREEN.
- 24. 2" RIGID BUILDING INSULATION OVER CONTINUOUS VAPOR BARRIER.
- 25. STEEL LINTEL WITH PLATE, PAINT -- REFER TO STRUCTURAL DRAWINGS.
- 26. STEEL ANGLE DECK SUPPORT -- REFER TO STRUCTURAL DRAWINGS.
- 27.  $\frac{3}{4}$ " PRESERVATIVE TREATED PLYWOOD SHEATHING.
- 28. PRESERVATIVE TREATED WOOD NAILER WITH EXPANSION ANCHORS
- 29. 2"x4" PRESERVATIVE TREATED WOOD NAILER.
- 30. 1"x4" PRESERVATIVE TREATED WOOD NAILER--CUT TO FIT PROFILE (CONTRACTOR OPTION TO UTILIZE CARLISLE SECREDGE 200 COPING INSTEAD).
- 31. SEALANT (WITH FOAM BACKER ROD AS NECESSARY TO SUIT CONDITIONS).
- 32. COMPRESSIBLE FILLER
- 33. 5" CONCRETE FROST SLAB SLOPE AWAY FROM BUILDING MINIMUM  $\frac{1}{2}$ " PER FOOT.
- 34. STAINLESS STEEL METAL DRIP WITH HEMMED EDGE.
- 35. FULLY ADHERED FLEXIBLE MEMBRANE FLASHING WITH END DAMS.
- 36. TERMINATION BAR WITH TOP SEALANT--INSTALL PER MANUFACTURER'S REQUIREMENTS.
- 37. PEA STONE DRAINAGE MATERIAL (MINIMUM 6" HEIGHT).



Addendum #4: 17 August 2023 Bidding and Permits: 31 July 2023

# Exterior Details



Crestwood School District Cherry Hill Baptist Church Administration Relocation and Addition

Project No. 3221


A9.10


### DRAWING NOTES (CONT.):


- 46. 1"x4" PRESERVATIVE TREATED WOOD NAILER--CUT TO FIT PROFILE (CONTRACTOR OPTION TO UTILIZE CARLISLE SECREDGE 200 COPING INSTEAD).
- 47. SEALANT (WITH FOAM BACKER ROD AS NECESSARY TO SUIT CONDITIONS).
- 48. COMPRESSIBLE FILLER
- 49.  $\frac{5}{8}$ " GYPSUM BOARD TAPED AND FINISHED THREE (3) COATS ON  $3\frac{5}{8}$ " METAL FRAMING @ 16" O.C. ATTACHED TO SUPPORT STRUCTURE ABOVE.


# DRAWING NOTES (CONT.)


- 34. DOOR REFER TO DOOR SCHEDULE. 35. FULLY ADHERED SINGLE-PLY EPDM ROOFING -- CARRY UP AND OVER FACE OF PARAPET
- 36.  $\frac{2}{3}$ " CEMENT PLASTER SOFFIT ON GALVANIZED METAL LATH -- PAINT (COLOR AS SELECTED
- FROM MANUFACTURER'S STANDARD COLOR RANGE).
- $\frac{3}{4}$ " CROSS FURRING SPACED PER MANUFACTURER'S RECOMMENDATIONS. 38. 2" CRC MAIN RUNNER ATTACHED TO BUILDING STRUCTURE WITH GALVANIZED TIE WIRE
- (SPACED PER MANUFACTURER'S RECOMMENDATIONS). 39. RECESSED LIGHT FIXTURE -- REFER TO ELECTRICAL DRAWINGS.
- 40. 2"x4" PRESERVATIVE TREATED WOOD NAILER.
- 41. PARAPET WALL BLOCKING -- REFER TO DETAIL 9/A9.14 FOR FURTHER INFORMATION.
- 42. PREFINISHED METAL PARAPET CAP FLASHING WITH CONCEALED CLIP ANCHORS BOTH SIDES (NO EXPOSED FASTENERS).
- 43. 2" RIGID BUILDING INSULATION.
- 44.  $\frac{3}{4}$ " PRESERVATIVE TREATED PLYWOOD SHEATHING.
- 45. PRESERVATIVE TREATED WOOD NAILER WITH EXPANSION ANCHORS

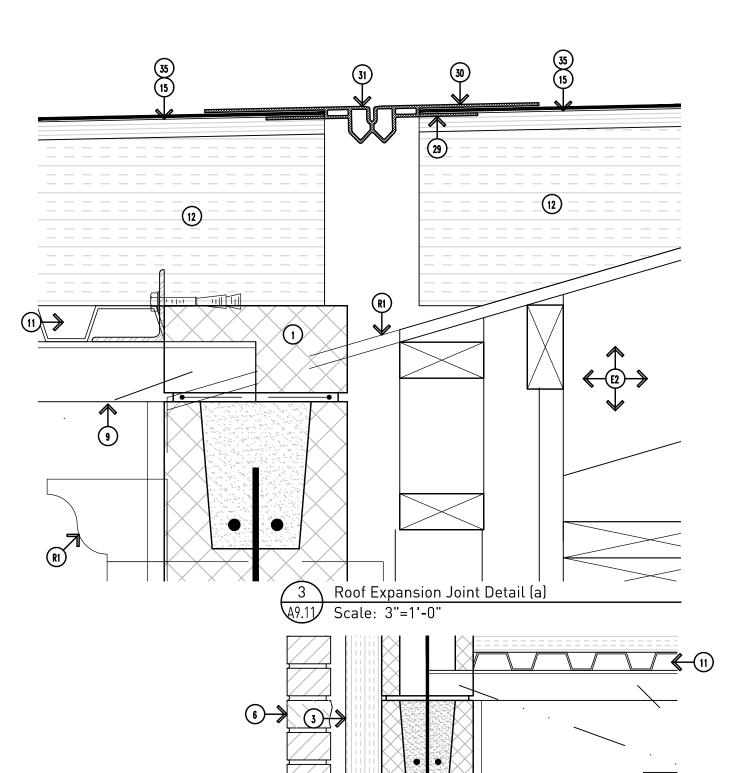

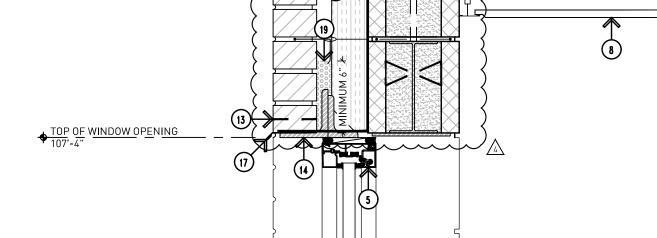

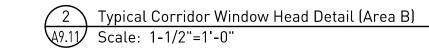

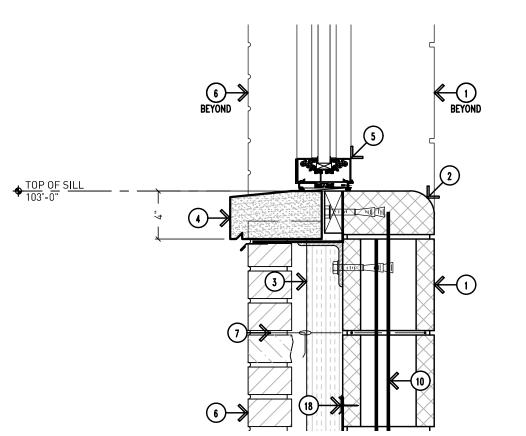

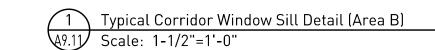



- G1. DO NOT SCALE DRAWING. DRAWING SCALE IS SHOWN FOR GENERAL REFERENCE ONLY.
- G2. NOT ALL NOTES ARE APPLICABLE TO THIS SHEET.
- G3. PROVIDE MASONRY ANCHORS @ 16" O.C. VERTICALLY AND HORIZONTALLY.
- G4. PROVIDE NON-COM WOOD BLOCKING BEHIND ALL MISCELLANEOUS TRIM LOCATIONS AND ALL OTHER ATTACHMENT LOCATIONS WHETHER PARTICULARLY SHOWN ON THE DOCUMENTS
- G5. ALL PREFINISHED METAL COPING TO BE COMPLETE WITH CONCEALED CLIP ANCHORS ON BOTH SIDES (NO VISIBLE FASTENERS).
- G6. CARRY ROOFING UP AND OVER PARAPET CAP -- TYPICAL.
- PROVIDE CONTINUOUS SPRAY-APPLIED VAPOR BARRIER COVERING FACE OF WALL AND UP AND OVER PARAPET WALL. TERMINATE WITH ROOFING PER MANUFACTURER'S REQUIREMENTS. BARRIER SYSTEM SHALL BE CONTINUOUS AROUND THE ENTIRE BUILDING ENVELOPE AND INCLUDE ALL PROPER TECHNIQUES FOR PENETRATIONS, ETC.
- G8. ALL FLEXIBLE MEMBRANE FLASHING TO BE SECURED TO SUBSTRATE WITH TERMINATION BAR AND SEALANT -- INSTALLED PER MANUFACTURER'S RECOMMENDATIONS.
- G9. FILL BRICK CORES AND COLLAR JOINTS SOLID BELOW GRADE AND BELOW ALL FLASHINGS.
- G10. PROVIDE STAINLESS STEEL DRIP WITH HEMMED EDGE ABOVE ALL EXTERIOR WINDOW AND
- G11. PROVIDE MASONRY WEEP VENTS @ 32" O.C. HORIZONTALLY AT TOP AND BOTTOM OF WALL
- COMPLETE WITH 3/8" x 1-1/2" PLASTIC WEEP VENT AND FLEXIBLE MEMBRANE FLASHING MIN.
- G12. MASONRY CONTROL JOINTS SHOULD BE SPACED 25'-0" APART MAX. AND SHOULD NOT BE SPACED FURTHER THAN 1.5x THE WALL HEIGHT - REFER TO THE MASONRY INSTITUTE FOR FURTHER INFORMATION.

#### **REMOVAL NOTES:**

R1. EXISTING ROOF, SOFFIT, GUTTER, DOWNSPOUT, ETC. AS REQUIRED. - E.C.U.

# **EXISTING TO REMAIN NOTES:**

- E1. CMU BLOCK EXACT CONDITIONS UNKNOWN.
- E2. ROOF, ROOF STRUCTURE, AND ROOF DECK EXACT CONDITIONS UNKNOWN.
- E3. WALL INSULATION EXACT CONDITIONS UNKNOWN.
- E4. ROOF INSULATION EXACT CONDITIONS UNKNOWN. REMOVE WHERE NECESSARY FOR CONSTRUCTION OF NEW WALL.
- E5. BRICK VENEER EXACT CONDITIONS UNKNOWN.

# DRAWING NOTES:

- 1. CMU MASONRY BLOCK (PAINT ALL SURFACES EXPOSED TO VIEW).
- 2. BULLNOSE CMU MASONRY BLOCK.
- 3" SPRAY FOAM BUILDING INSULATION SYSTEM WITH INTEGRAL CONTINUOUS VAPOR BARRIER AND ACCESSORIES AS REQUIRED TO PROVIDE BARRIER FROM FOUNDATION TO ROOFING.
- 4. LIMESTONE WINDOW SILL AND PROFILE TO MATCH EXISTING.
- STOREFRONT FRAMING AND GLAZING -- REFER TO WINDOW SCHEDULE AND DETAILS.
- 4" BRICK VENEER WITH ADJUSTABLE BRICK TIES @ 16" O.C. VERTICALLY AND HORIZONTALLY (PROVIDE LENGTH AS REQUIRED DUE TO WALL CAVITY SIZE).
- 7. HORIZONTAL JOINT REINFORCING @ 16" O.C. VERTICALLY.
- ACOUSTICAL CEILING TILE IN PREFINISHED METAL GRID SYSTEM ATTACHED TO BUILDING
- 9. STRUCTURAL STEEL ROOF FRAMING -- REFER TO STRUCTURAL DRAWINGS.
- 10. REINFORCING -- REFER TO STRUCTURAL DRAWINGS.
- 11.  $1\frac{1}{2}$ " GALVANIZED METAL ROOF DECK.
- 13.  $\frac{3}{8}$ " x 1  $\frac{1}{2}$ " PLASTIC WEEP VENT WITH INSECT SCREEN.
- 14. STEEL LINTEL WITH PLATE, PAINT -- REFER TO STRUCTURAL DRAWINGS.
- 15.  $\frac{3}{4}$ " PRESERVATIVE TREATED PLYWOOD SHEATHING.
- 16. § "GYPSUM BOARD TAPED AND FINISHED THREE (3) COATS ON 6" METAL FRAMING @ 12" O.C. 17. STAINLESS STEEL METAL DRIP WITH HEMMED EDGE.

12. RIGID ROOF INSULATION BOARD (MINIMUM 6" THICKNESS -- TWO LAYERS AND COVERBOARD).

- 18. TERMINATION BAR WITH TOP SEALANT--INSTALL PER MANUFACTURER'S REQUIREMENTS.
- 19. PEA STONE DRAINAGE MATERIAL (MINIMUM 6" HEIGHT).
- 20. PREFINISHED TWO-PIECE COUNTER FLASHING.
- 21. PARAPET TO WALL JOINT COVER BELLOWS TYPE, SIZE TO SUIT APPLICATION, INSULATED, 2 HOUR FIRE RATING.
- 22. SHINGLES, SHAKES, SLATE, ETC. BY OTHERS.
- 23. UNDERLAYMENT MAT OF WATER SHEDDING SYSTEM TO BE ABOVE CARLISLE MEMBRANE IN
- SHINGLE-FASHION, OVERLAP MIN. 6" (15cm).
- 24. CARLISLE FASTENER & SEAM PLATE, MAX. 12" (30cm) O.C.
- 25. 6" (15cm) WIDE PRESSURE- SENSITIVE RUSS AND EPDM PRIMER.
- 26. APPROVED SUBSTRATE.
- 27. ROOF MEMBRANE EXTENDED UNDER THE SHINGLE COURSES.
- 28. SURE-SEAL BONDING ADHESIVE.
- LOWER ROOF JOINT FLAP. 30. TOP ROOF JOINT FLAP.
- 31. ROOF JOINT RJ-0200 (BY SIKA EMSEAL).
- 32. FULLY ADHERED FLEXIBLE MEMBRANE FLASHING WITH END DAMS.
- 33. DOOR FRAME REFER TO DOOR SCHEDULE.



Addendum #4: 17 August 2023 Bidding and Permits: 31 July 2023

# **Exterior Details**





**Crestwood School District** Cherry Hill Baptist Church Administration Relocation and Addition


Project No. 3221

A9.11


803 W. Big Beaver Road, Suite 350, Troy, MI 48084 | 248.244.9710

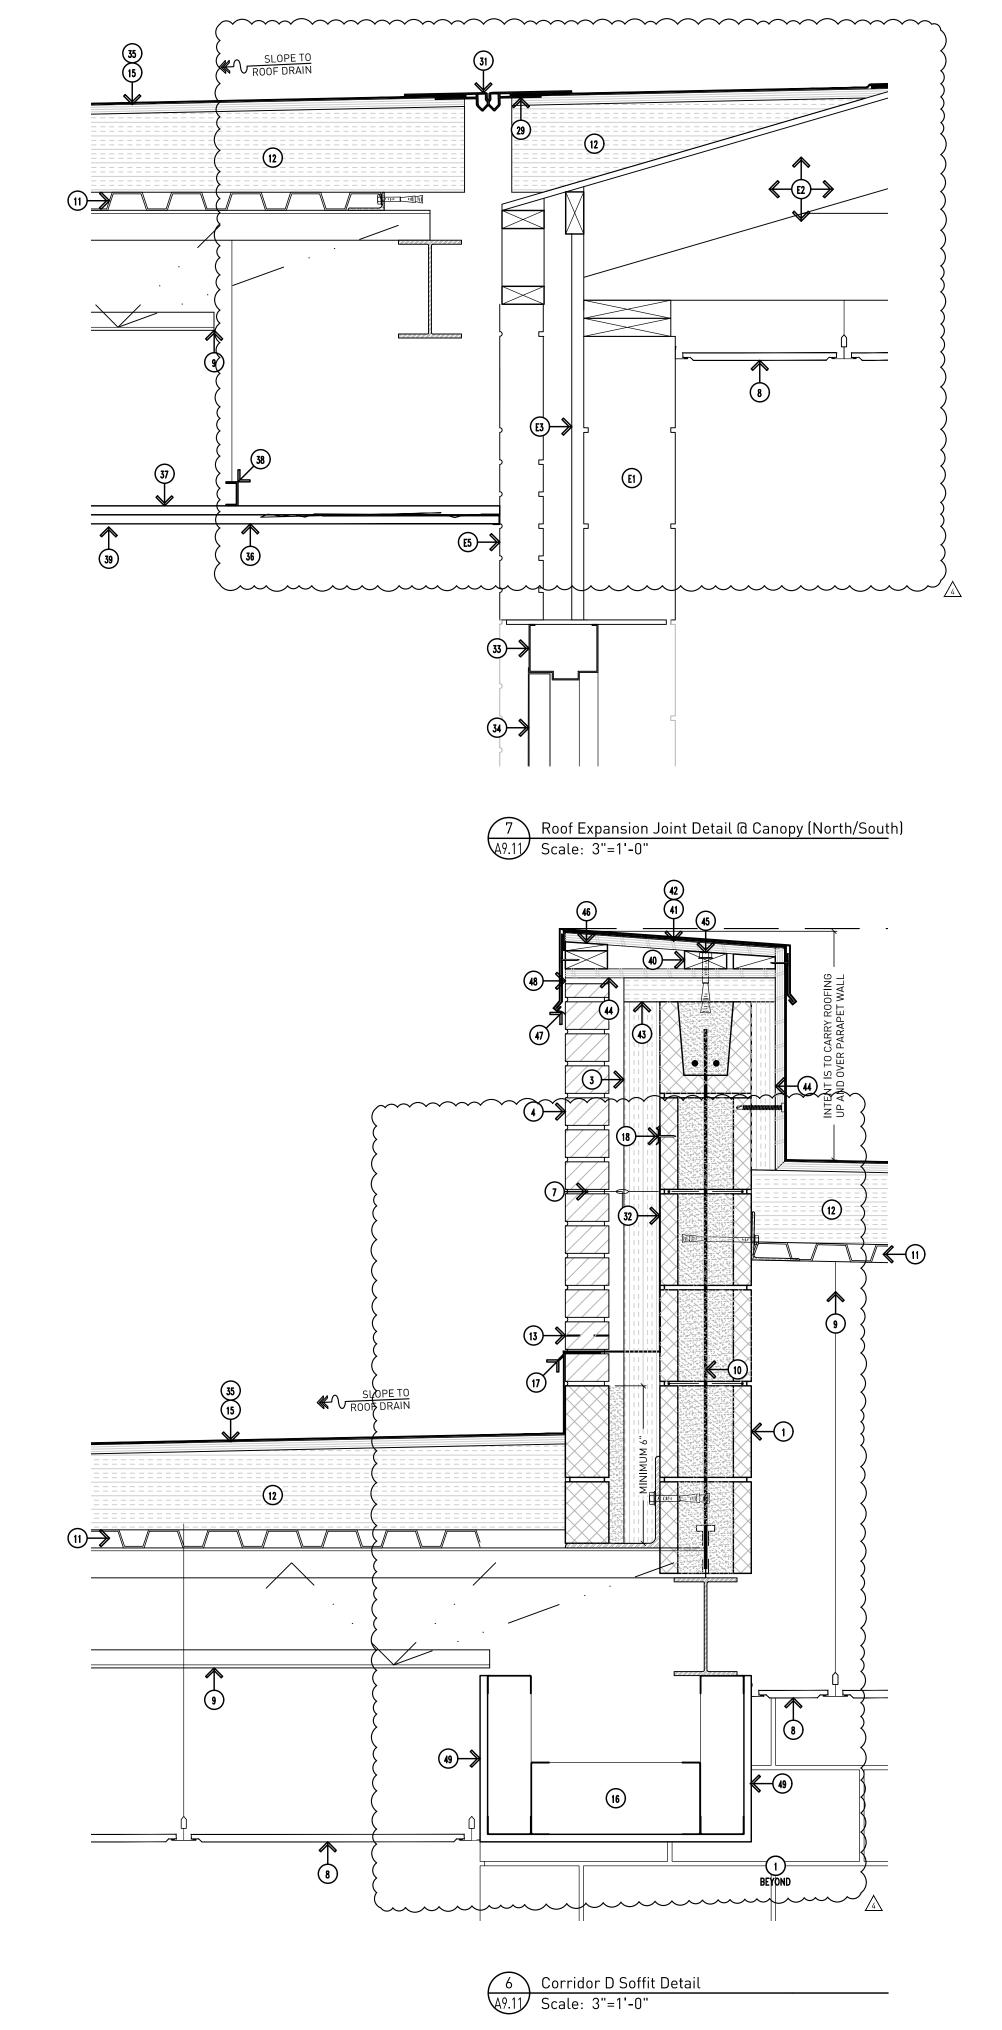


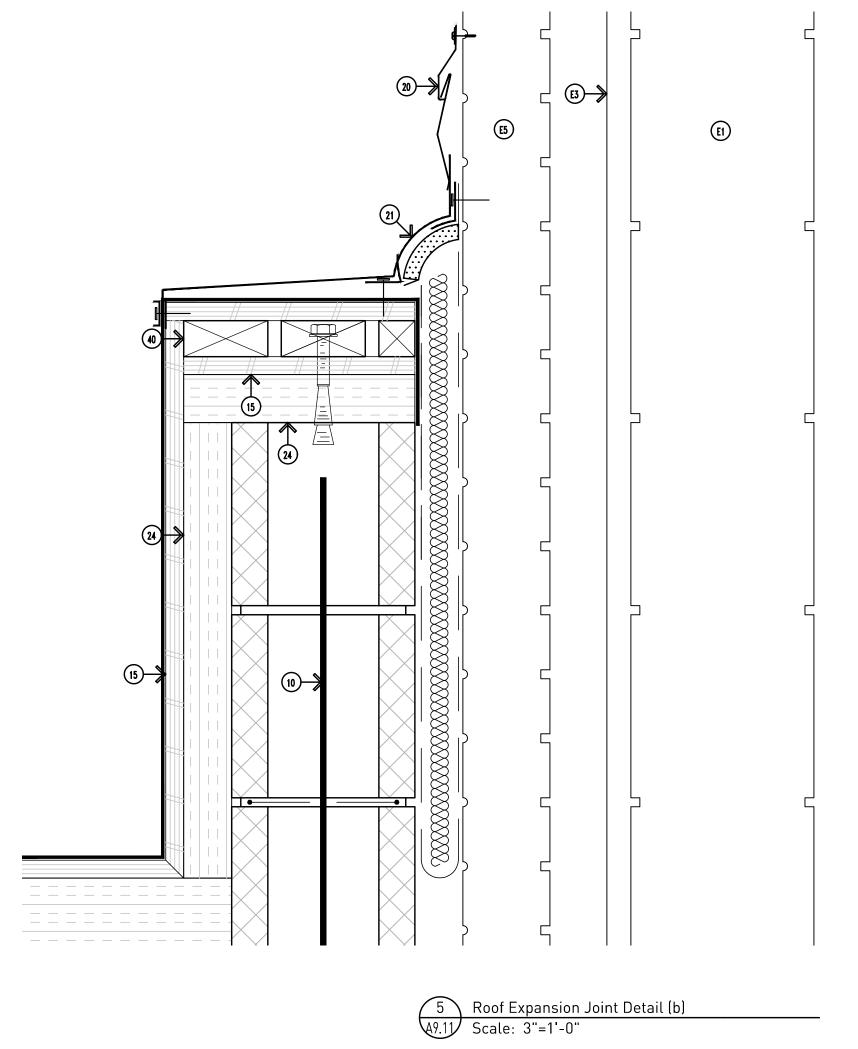

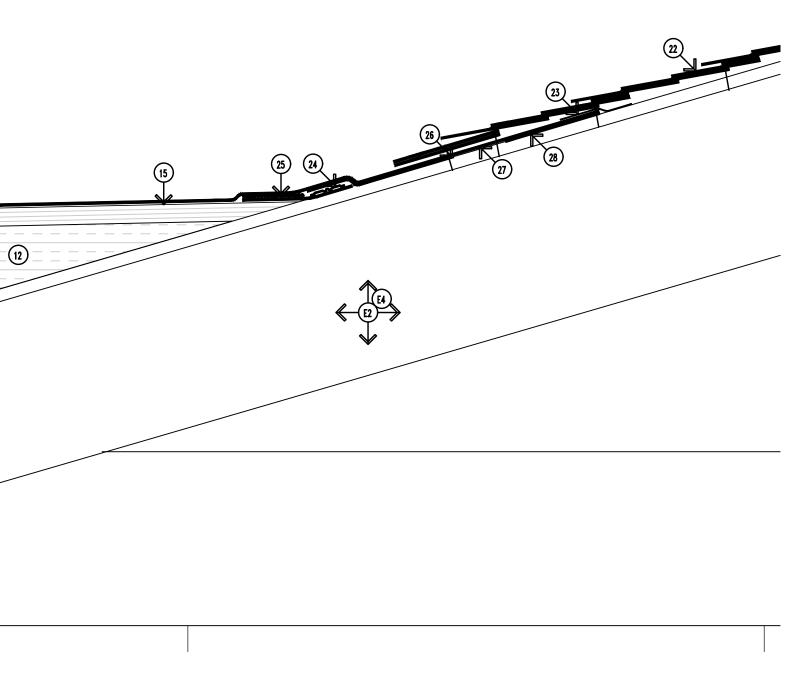

4 EPDM to Asphalt Shingle Expansion Joint Detail A9.11 Scale: 3"=1'-0"

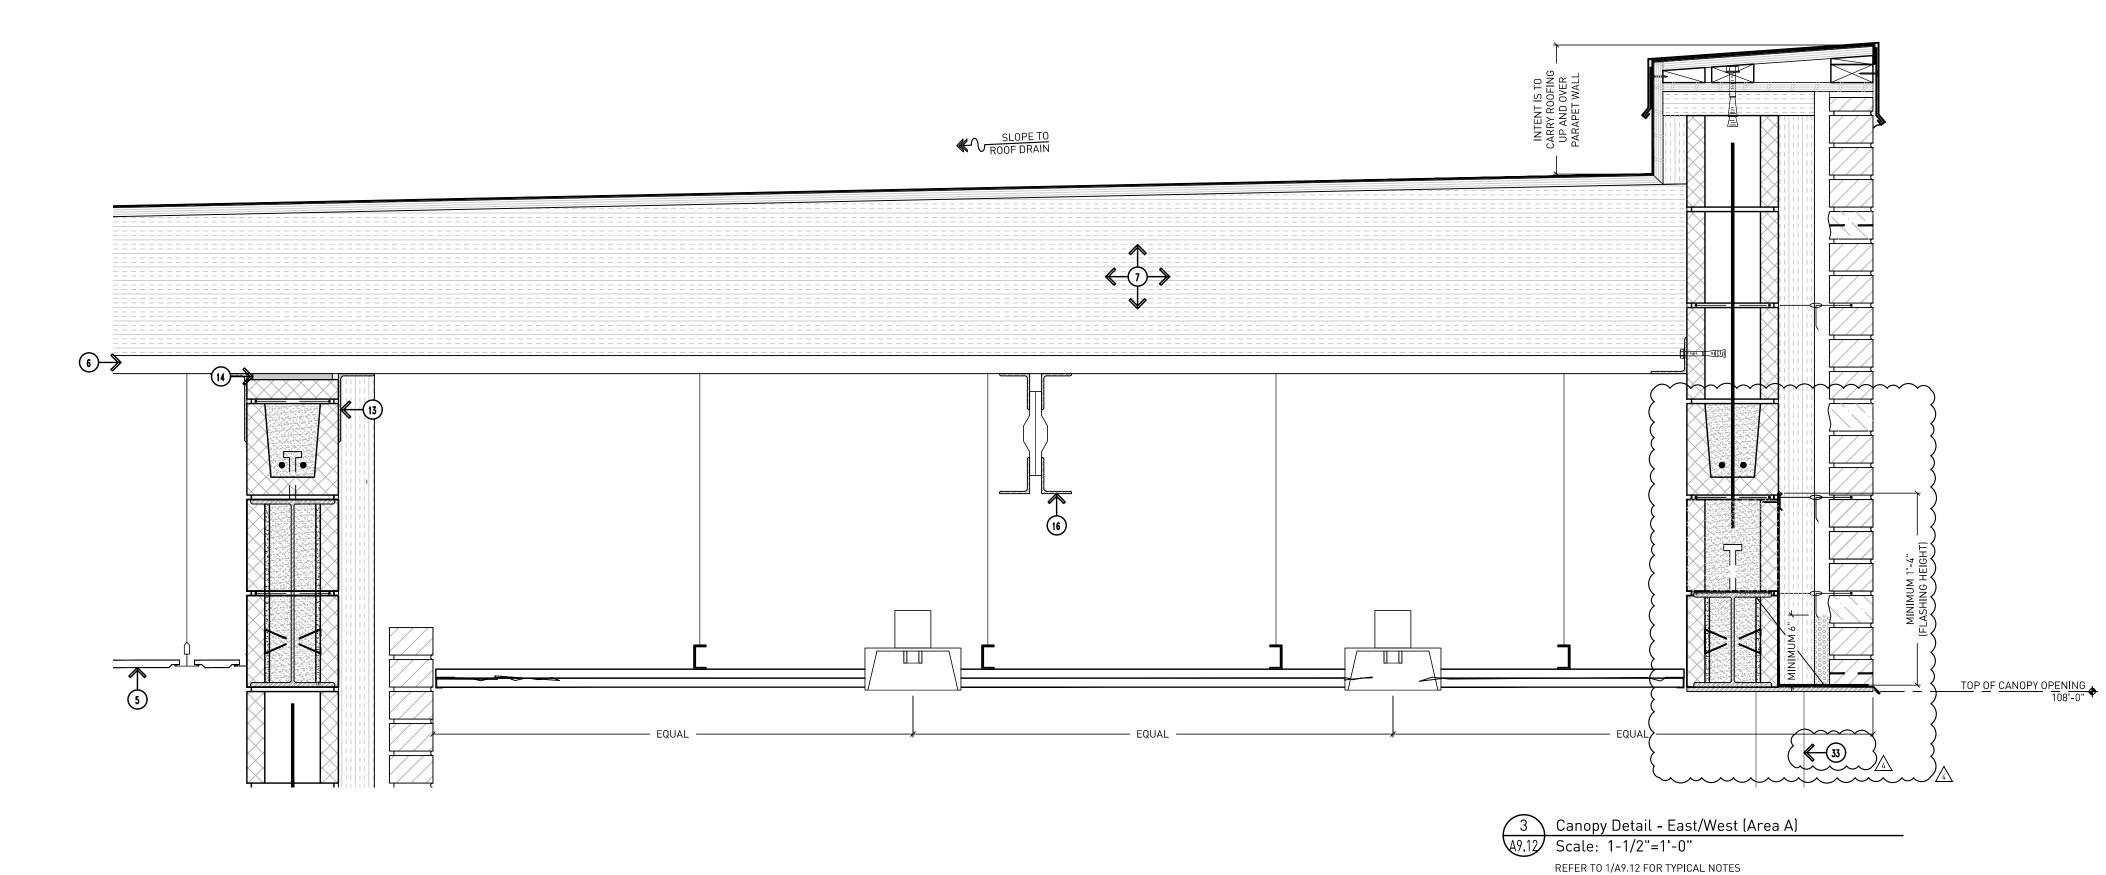

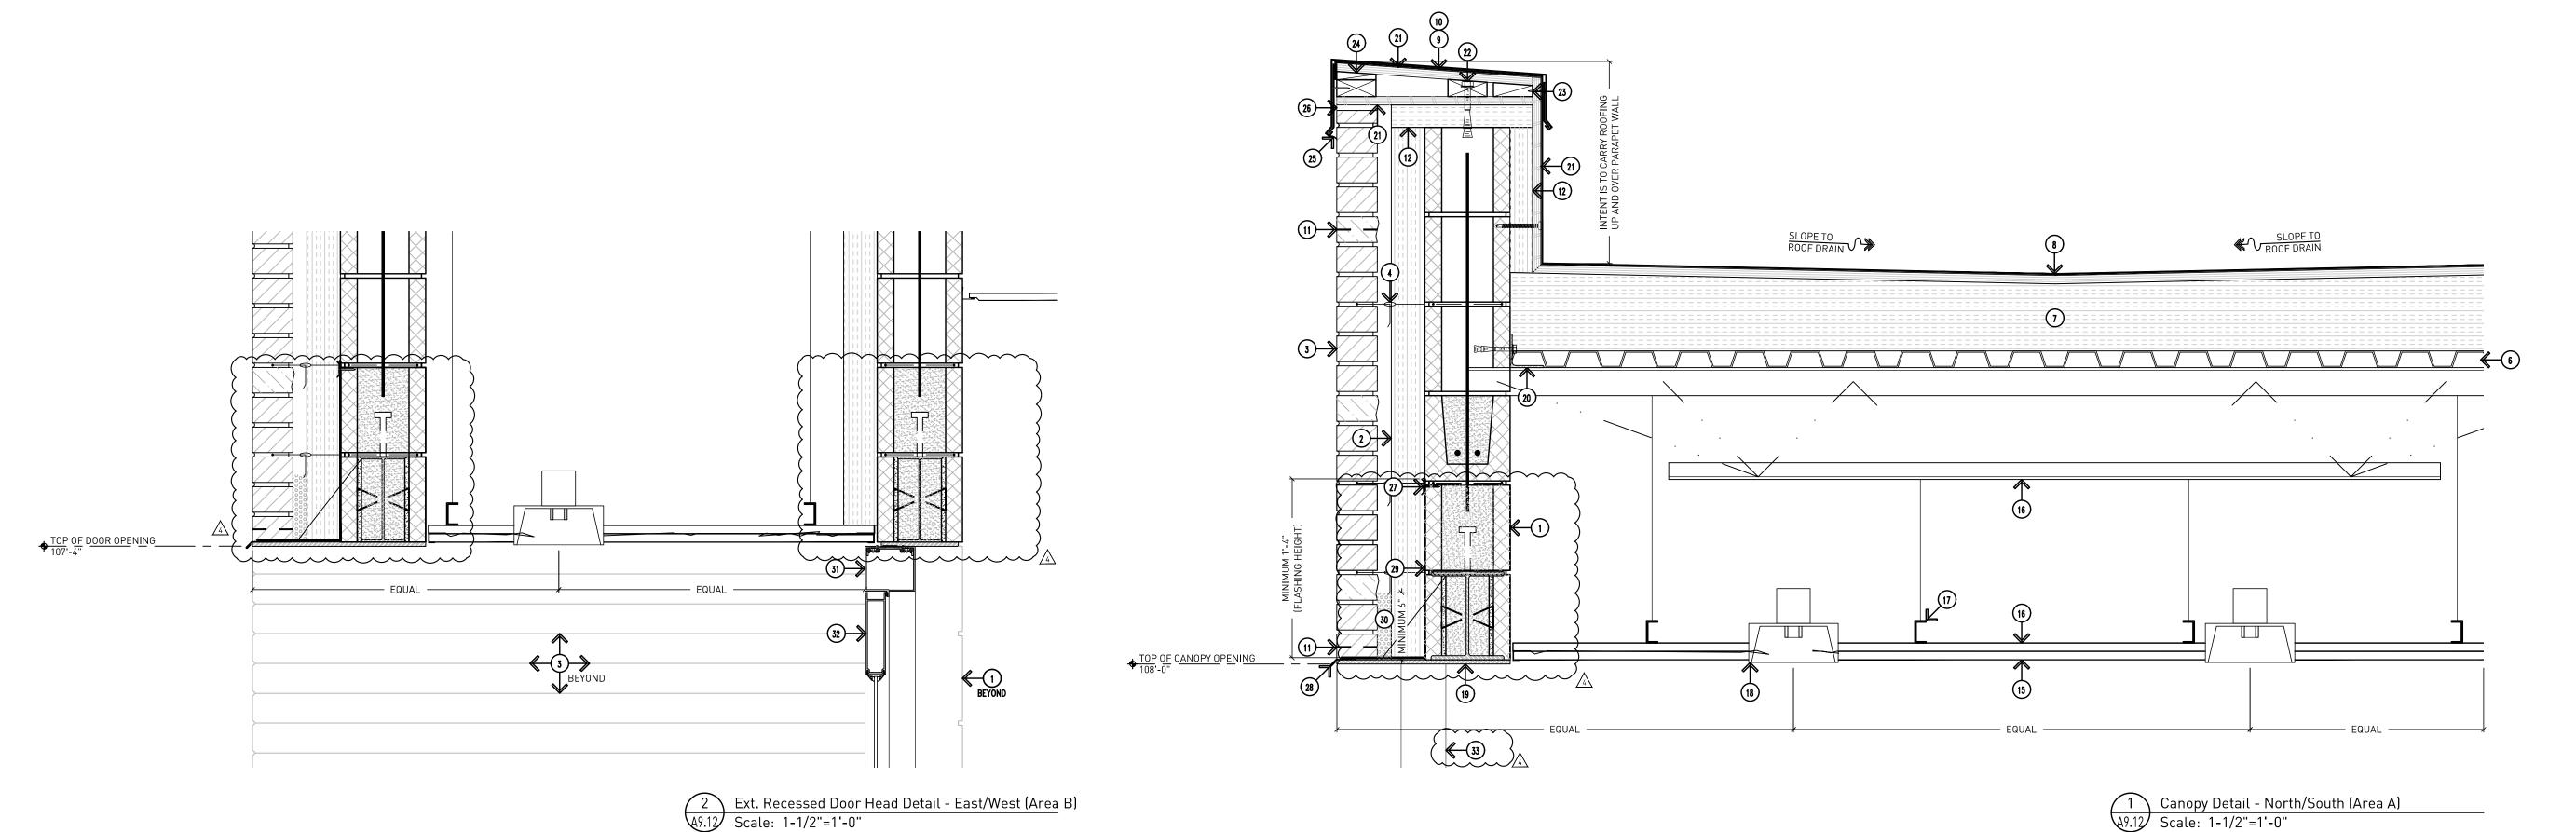

REFER TO 1/A9.12 FOR TYPICAL NOTES

**GENERAL NOTES:** 

- G1. DO NOT SCALE DRAWING. DRAWING SCALE IS SHOWN FOR GENERAL REFERENCE ONLY.
- G2. NOT ALL NOTES ARE APPLICABLE TO THIS SHEET.
- G3. PROVIDE MASONRY ANCHORS @ 16" O.C. VERTICALLY AND HORIZONTALLY.
- G4. PROVIDE NON-COM WOOD BLOCKING BEHIND ALL MISCELLANEOUS TRIM LOCATIONS AND ALL OTHER ATTACHMENT LOCATIONS WHETHER PARTICULARLY SHOWN ON THE DOCUMENTS
- G5. ALL PREFINISHED METAL COPING TO BE COMPLETE WITH CONCEALED CLIP ANCHORS ON BOTH SIDES (NO VISIBLE FASTENERS).
- G6. CARRY ROOFING UP AND OVER PARAPET CAP -- TYPICAL.
- G7. PROVIDE CONTINUOUS SPRAY-APPLIED VAPOR BARRIER COVERING FACE OF WALL AND UP AND OVER PARAPET WALL. TERMINATE WITH ROOFING PER MANUFACTURER'S REQUIREMENTS. BARRIER SYSTEM SHALL BE CONTINUOUS AROUND THE ENTIRE BUILDING ENVELOPE AND INCLUDE ALL PROPER TECHNIQUES FOR PENETRATIONS, ETC.
- G8. ALL FLEXIBLE MEMBRANE FLASHING TO BE SECURED TO SUBSTRATE WITH TERMINATION BAR AND SEALANT -- INSTALLED PER MANUFACTURER'S RECOMMENDATIONS.
- G9. FILL BRICK CORES AND COLLAR JOINTS SOLID BELOW GRADE AND BELOW ALL FLASHINGS.
- G10. PROVIDE STAINLESS STEEL DRIP WITH HEMMED EDGE ABOVE ALL EXTERIOR WINDOW AND
- G11. PROVIDE MASONRY WEEP VENTS @ 32" O.C. HORIZONTALLY AT TOP AND BOTTOM OF WALL COMPLETE WITH 3/8" x 1-1/2" PLASTIC WEEP VENT AND FLEXIBLE MEMBRANE FLASHING MIN.
- G12. MASONRY CONTROL JOINTS SHOULD BE SPACED 25'-0" APART MAX. AND SHOULD NOT BE SPACED FURTHER THAN 1.5x THE WALL HEIGHT - REFER TO THE MASONRY INSTITUTE FOR FURTHER INFORMATION.

## DRAWING NOTES:

- 1. CMU MASONRY BLOCK (PAINT ALL SURFACES EXPOSED TO VIEW).
- 2. 3" SPRAY FOAM BUILDING INSULATION SYSTEM WITH INTEGRAL CONTINUOUS VAPOR BARRIER AND ACCESSORIES AS REQUIRED TO PROVIDE BARRIER FROM FOUNDATION TO ROOFING.
- 4" BRICK VENEER WITH ADJUSTABLE BRICK TIES @ 16" O.C. VERTICALLY AND HORIZONTALLY (PROVIDE LENGTH AS REQUIRED DUE TO WALL CAVITY SIZE).
- 4. HORIZONTAL JOINT REINFORCING @ 16" O.C. VERTICALLY.
- ACOUSTICAL CEILING TILE IN PREFINISHED METAL GRID SYSTEM ATTACHED TO BUILDING
- STRUCTURE ABOVE.
- 6.  $1\frac{1}{2}$ " GALVANIZED METAL ROOF DECK.
- 7. RIGID ROOF INSULATION BOARD (MINIMUM 6" THICKNESS -- TWO LAYERS AND COVERBOARD).
- FULLY ADHERED SINGLE-PLY EPDM ROOFING -- CARRY UP AND OVER FACE OF PARAPET
- 9. PARAPET WALL BLOCKING -- REFER TO DETAIL 9/A9.14 FOR FURTHER INFORMATION.
- 10. PREFINISHED METAL PARAPET CAP FLASHING WITH CONCEALED CLIP ANCHORS BOTH SIDES (NO EXPOSED FASTENERS).
- 11.  $\frac{3}{8}$ " x 1  $\frac{1}{2}$ " PLASTIC WEEP VENT WITH INSECT SCREEN.
- 12. 2" RIGID BUILDING INSULATION.
- 13. STEEL ANGLE WALL BRACE -- REFER TO STRUCTURAL FOR FURTHER INFORMATION.
- 14. FILL VOID WITH COMPRESSIBLE FILLER MATERIAL FOR ALLOW FOR MINIMUM 1" ROOF
- 15.  $\frac{3}{4}$ " CEMENT PLASTER SOFFIT ON GALVANIZED METAL LATH -- PAINT (COLOR AS SELECTED FROM MANUFACTURER'S STANDARD COLOR RANGE).
- 16.  $\frac{3}{4}$ " CROSS FURRING SPACED PER MANUFACTURER'S RECOMMENDATIONS.
- 2" CRC MAIN RUNNER ATTACHED TO BUILDING STRUCTURE WITH GALVANIZED TIE WIRE
- (SPACED PER MANUFACTURER'S RECOMMENDATIONS).
- 18. RECESSED LIGHT FIXTURE -- REFER TO ELECTRICAL DRAWINGS.
- 19. STEEL LINTEL WITH PLATE, PAINT -- REFER TO STRUCTURAL DRAWINGS.
- 20. STEEL ANGLE DECK SUPPORT -- REFER TO STRUCTURAL DRAWINGS.
- 21.  $\frac{3}{4}$ " PRESERVATIVE TREATED PLYWOOD SHEATHING.
- 22. PRESERVATIVE TREATED WOOD NAILER WITH EXPANSION ANCHORS 23. 2"x4" PRESERVATIVE TREATED WOOD NAILER.
- 24. 1"x4" PRESERVATIVE TREATED WOOD NAILER--CUT TO FIT PROFILE (CONTRACTOR OPTION TO
- UTILIZE CARLISLE SECREDGE 200 COPING INSTEAD). 25. SEALANT (WITH FOAM BACKER ROD AS NECESSARY TO SUIT CONDITIONS).
- 26. COMPRESSIBLE FILLER
- 27. TERMINATION BAR WITH TOP SEALANT--INSTALL PER MANUFACTURER'S REQUIREMENTS.
- 28. STAINLESS STEEL METAL DRIP WITH HEMMED EDGE.
- 29. FULLY ADHERED FLEXIBLE MEMBRANE FLASHING WITH END DAMS.
- 30. PEA STONE DRAINAGE MATERIAL (MINIMUM 6" HEIGHT).
- 31. DOOR FRAME REFER TO DOOR SCHEDULE.
- 32. DOOR REFER TO DOOR SCHEDULE.
- 33. PAINTED STRUCTURAL COLUMN AT CANOPY REFER TO STRUCTURAL DRAWINGS FOR
- FURTHER INFORMATION.



Addendum #4: 17 August 2023
Bidding and Permits: 31 July 2023


Exterior Details





Crestwood School District Cherry Hill Baptist Church
Administration Relocation and Addition


Project No. 3221


A9.12

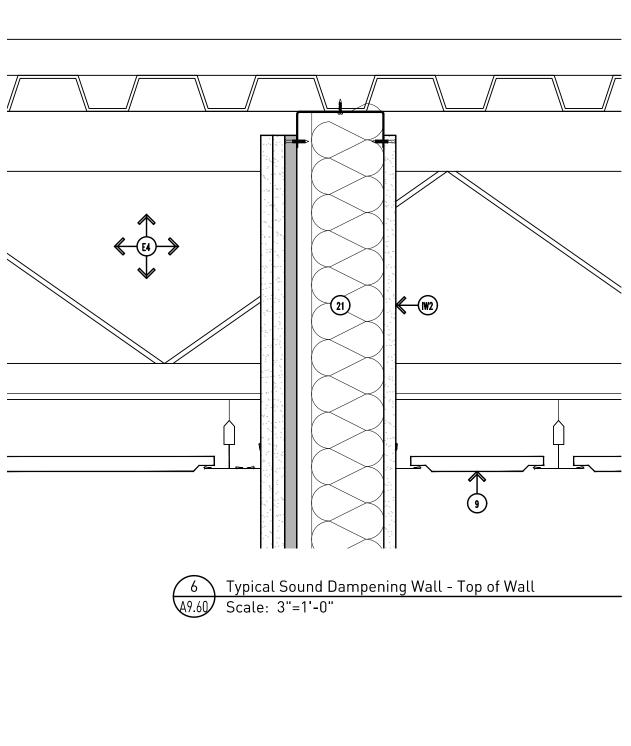


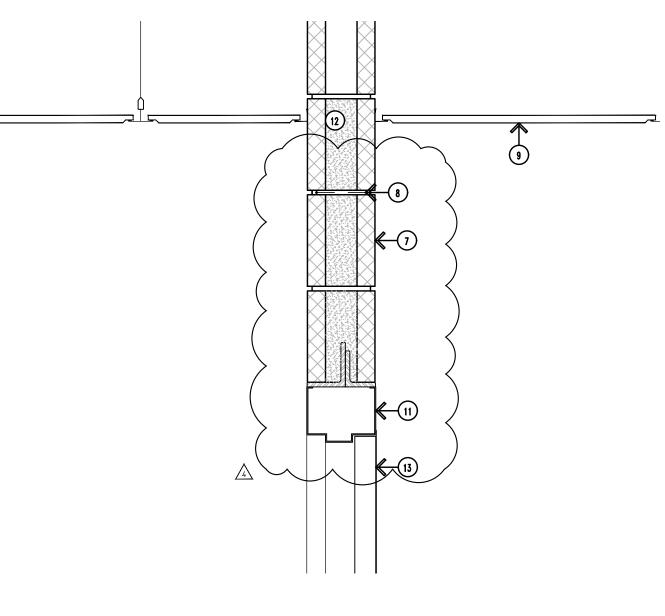

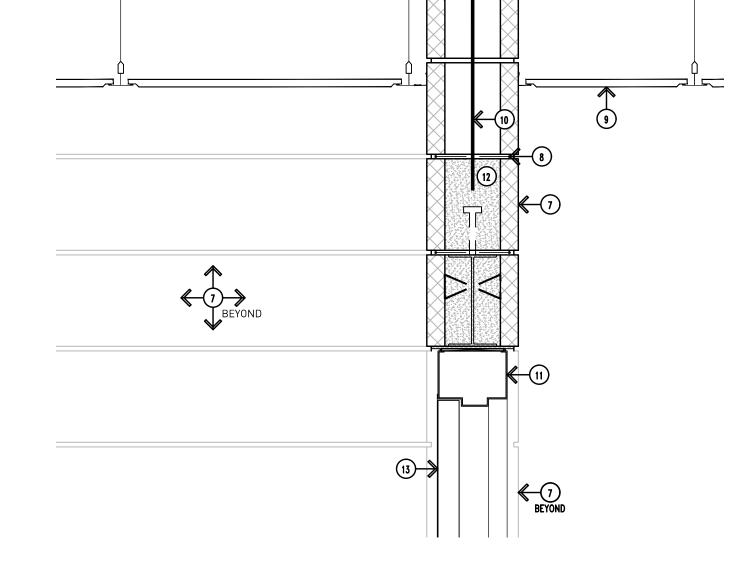

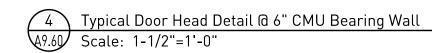


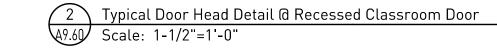


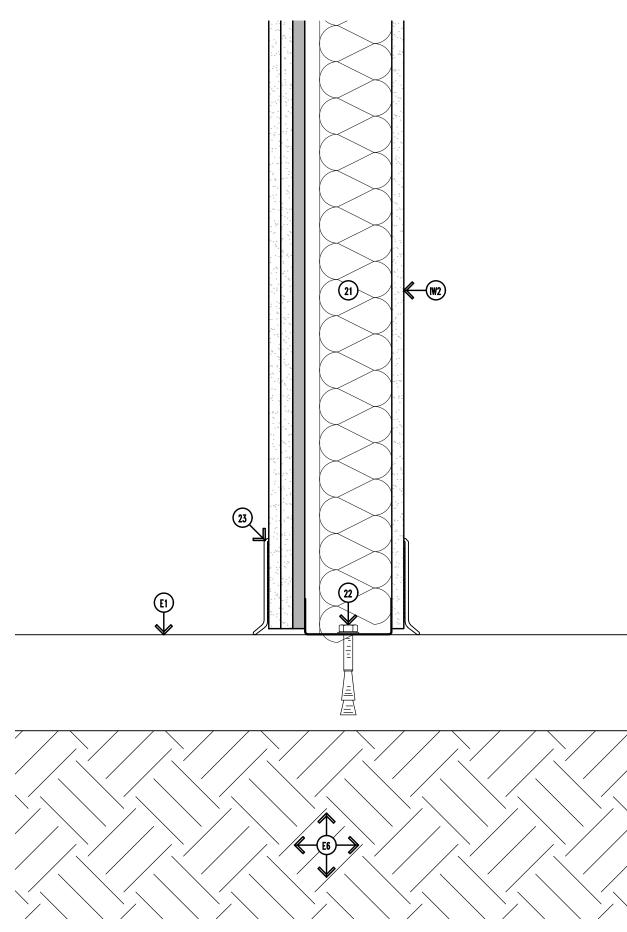


Typical Sound Dampening Wall - Base of Wall

A9.60 Scale: 3"=1'-0"

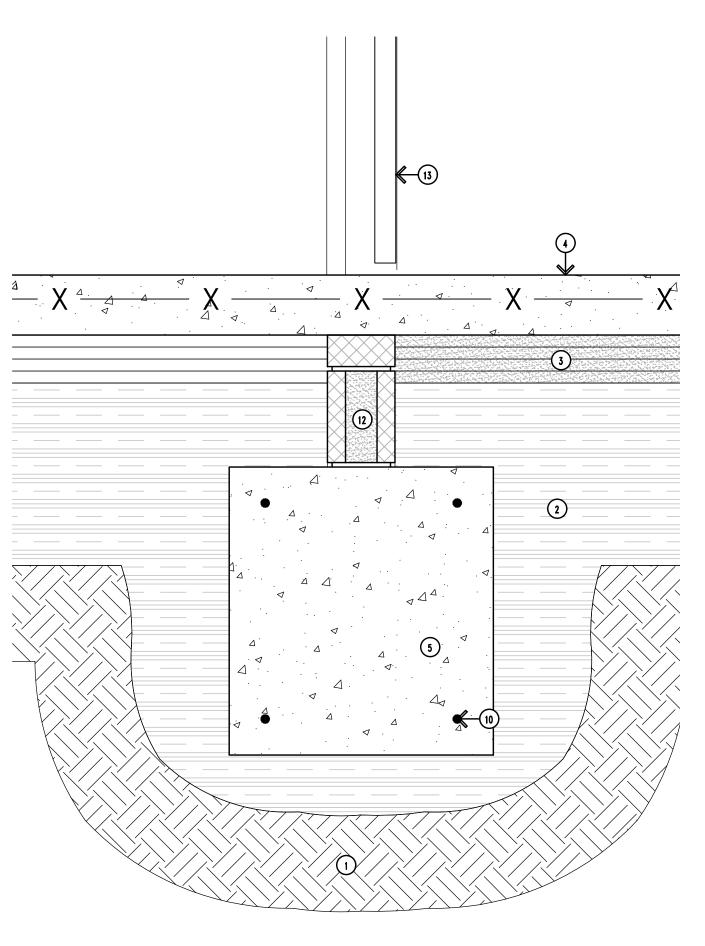

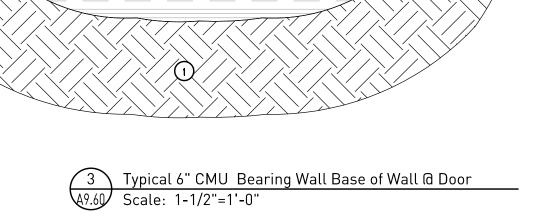

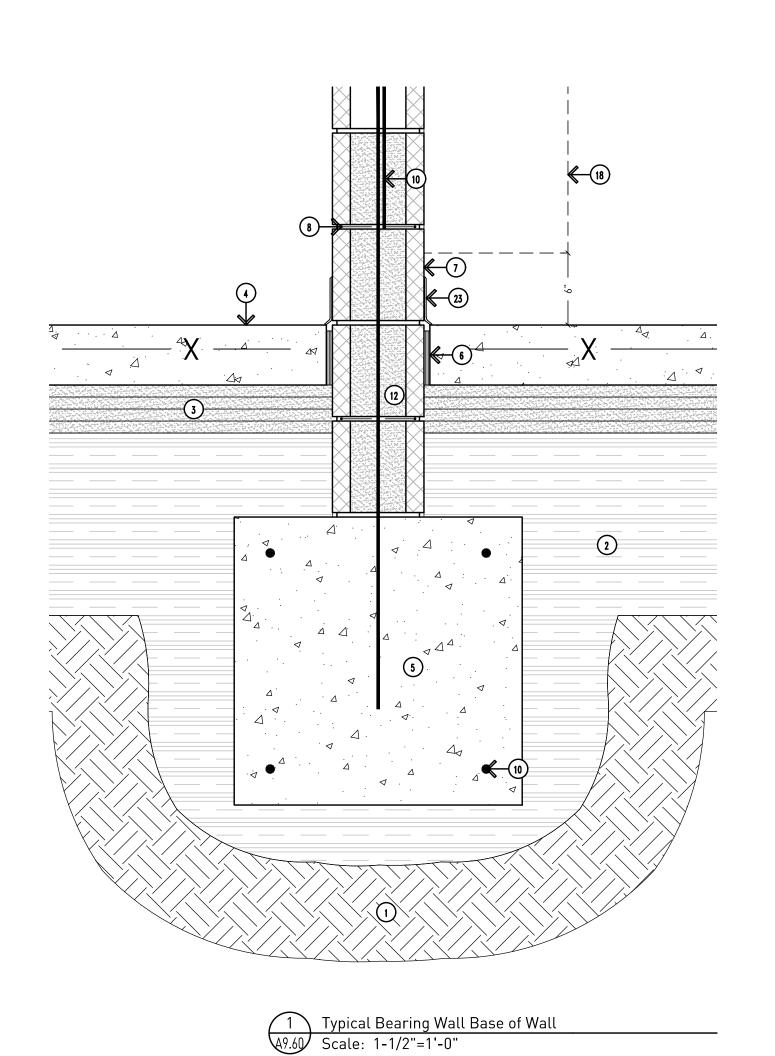

#### **GENERAL NOTES:**

- G1. DO NOT SCALE DRAWING. DRAWING SCALE IS SHOWN FOR GENERAL REFERENCE ONLY.
- G2. NOT ALL NOTES ARE APPLICABLE TO THIS SHEET.
- G3. CONTRACTOR TO FIELD VERIFY ALL EXISTING CONDITIONS WHERE NEW BUILDING IS TYING INTO THE EXISTING.

# **EXISTING TO REMAIN NOTES:**

- E1. CONCRETE FLOOR SLAB EXACT CONDITIONS UNKNOWN.
- E2. CMU BLOCK EXACT CONDITIONS UNKNOWN.
- E3. BRICK VENEER EXACT CONDITIONS UNKNOWN.
- E4. ROOF, ROOF STRUCTURE, AND ROOF DECK EXACT CONDITIONS UNKNOWN.
- E5. STRUCTURAL FOOTING EXACT CONDITIONS UNKNOWN.
- E6. UNDISTURBED SOIL EXACT CONDITIONS UNKNOWN.
- E7. LIMESTONE EXACT CONDITIONS UNKNOWN.

# DRAWING NOTES:

1. PROPERLY COMPACTED EXISTING SUBGRADE.

- COMPACTED ENGINEERED FILL AS REQUIRED AFTER REMOVAL OF EXISTING LAWN /
- UNSUITABLE SOILS AS REQUIRED FOR PROPER SLAB ELEVATION. 3. COMPACTED SAND CUSHION BASE (MINIMUM 4").
- CONCRETE FLOOR SLAB OVER 15 MIL VAPOR BARRIER -- PROPERLY LAP AND SEAL JOINTS PER MANUFACTURER'S REQUIREMENTS.
- 5. CONCRETE FOUNDATION -- REFER TO STRUCTURAL DRAWINGS.
- 6.  $\frac{1}{2}$ " PREMOLDED EXPANSION JOINT WITH SEALANT.
- 7. CMU MASONRY BLOCK (PAINT ALL SURFACES EXPOSED TO VIEW).
- 8. HORIZONTAL JOINT REINFORCING @ 16" O.C. VERTICALLY.
- ACOUSTICAL CEILING TILE IN PREFINISHED METAL GRID SYSTEM ATTACHED TO BUILDING STRUCTURE ABOVE.
- 10. REINFORCING -- REFER TO STRUCTURAL DRAWINGS.
- 11. DOOR FRAME -- REFER TO DOOR SCHEDULE.
- 12. GROUT CMU SOLID.
- 13. DOOR -- REFER TO DOOR SCHEDULE
- 14. SEALANT (WITH FOAM BACKER ROD AS NECESSARY TO SUIT CONDITIONS.)
- 15. GROUT CMU CORES SOLID BELOW FLASHING AT WHERE BELOW GRADE.
- 16. JAMB ANCHOR TO SUIT CONDITIONS.
- 17. GROUT FILLED DOOR FRAME.
- 18. CUBBIES -- REFER TO SPECIFICATIONS FOR FURTHER INFORMATION.
- 19. OUTLINE OF PORTABLE FIRE EXTINGUISHER.
- 20. RECESSED FIRE EXTINGUISHER CABINET WITH 5/16" FLAT TRIM.
- 21. CONTINUOUS METAL STUD FRAMING--REFER TO INTERIOR WALL TAG DESIGNATIONS FOR
- 22. 3/8" x 4" EXPANSION ANCHORS @ 48" O.C. OR EQUAL STRENGTH POWERED FASTENERS, MINIMUM 2" EMBEDMENT INTO CONCRETE FLOOR SLAB.
- 23. WALL BASE--REFER TO FINISH SCHEDULE.
- 24. 3/8" EPOXY DOWEL INTO EXISTING CONCRETE FLOOR SLAB @ 36" O.C. STAGGERED.
- 25. PLUMBING PIPING. REFER TO MECHANICAL DRAWINGS FOR SIZE AND MATERIAL.

# **INTERIOR WALL TAGS:**

- IW1. TYPICAL METAL STUD WALL CONSTRUCTION UNLESS NOTED OTHERWISE.
- 5/8" GYPSUM BOARD TAPED AND FINISHED THREE (3) COATS TO U/S OF ROOF DECK. 3-5/8" METAL STUD FRAMING AT 16" O.C TO U/S OF ROOF DECK. PROVIDE SLIP TRACK TOP TRACK TO ALLOW FOR 1 1/2" ROOF DEFLECTION.
- MINIMUM 3" SOUND ATTENUATION BATTS TO U/S OF ROOF DECK. • 5/8" GYPSUM BOARD TAPED AND FINISHED THREE (3) COATS TO U/S OF ROOF DECK.
- IW2. METAL STUD SOUND ACOUSTIC WALL TEST NUMBER RAL-TL-84-136

   1/2" GYPSUM BOARD TAPED AND FINISHED THREE (3) COATS TO U/S OF ROOF DECK.
  - GYPSUM SCREWS ATTACHED TO STUDS.
  - 3-5/8" METAL STUD FRAMING AT 16" O.C TO U/S OF ROOF DECK. PROVIDE SLIP TRACK TOP TRACK TO ALLOW FOR 1 1/2" ROOF DEFLECTION.
  - MINIMUM 3" SOUND ATTENUATION BATTS TO U/S OF ROOF DECK. RC-1 CHANNEL INSTALLED ON ONE SIDE @ 24" O.C.

TILE WALL CONSTRUCTION.

- TWO (2) LAYERS 1/2" GYPSUM BOARD TAPED AND FINISHED THREE (3) COATS TO UNDERSIDE OF ROOF DECK. GYPSUM SCREWS ATTACHED TO RC-1 CHANNEL. ACOUSTIC SEALANT AT TOP AND BOTTOM OF WALLS AND AT ALL PENETRATIONS. FOR WALLS LOCATED AT RESTROOMS, REFER TO ADJACENT WALL CONSTRUCTION TYPE FOR
- IW9. METAL STUD FIRE BARRIER. 2 HOUR FIRE-RATED CONSTRUCTION. UL DES U419 OR U491. • 3/4" SHEETROCK ULTRACODE CORE GYPSUM PANEL TAPED AND FINISHED THREE (3)
- COATS TO U/S OF ROOF DECK OR ADJACENT CMU WALL.
- 3-1/2" 25 GA. METAL STUD FRAMING AT 24" O.C TO U/S OF ROOF DECK OR ADJACENT CMU WALL. PROVIDE SLIP TRACK TOP TRACK TO ALLOW FOR 1 1/2" ROOF DEFLECTION. MINIMUM 3" THERMAFIBER SAFB TO U/S OF ROOF DECK.
- 3/4" SHEETROCK ULTRACODE CORE GYPSUM PANEL TAPED AND FINISHED THREE (3) COATS TO U/S OF ROOF DECK OR ADJACENT CMU WALL.



Addendum #4: 17 August 2023

Bidding and Permits: 31 July 2023


# **Interior Details**



Crestwood School District Cherry Hill Baptist Church Administration Relocation and Addition

Project No. 3221

A9.60

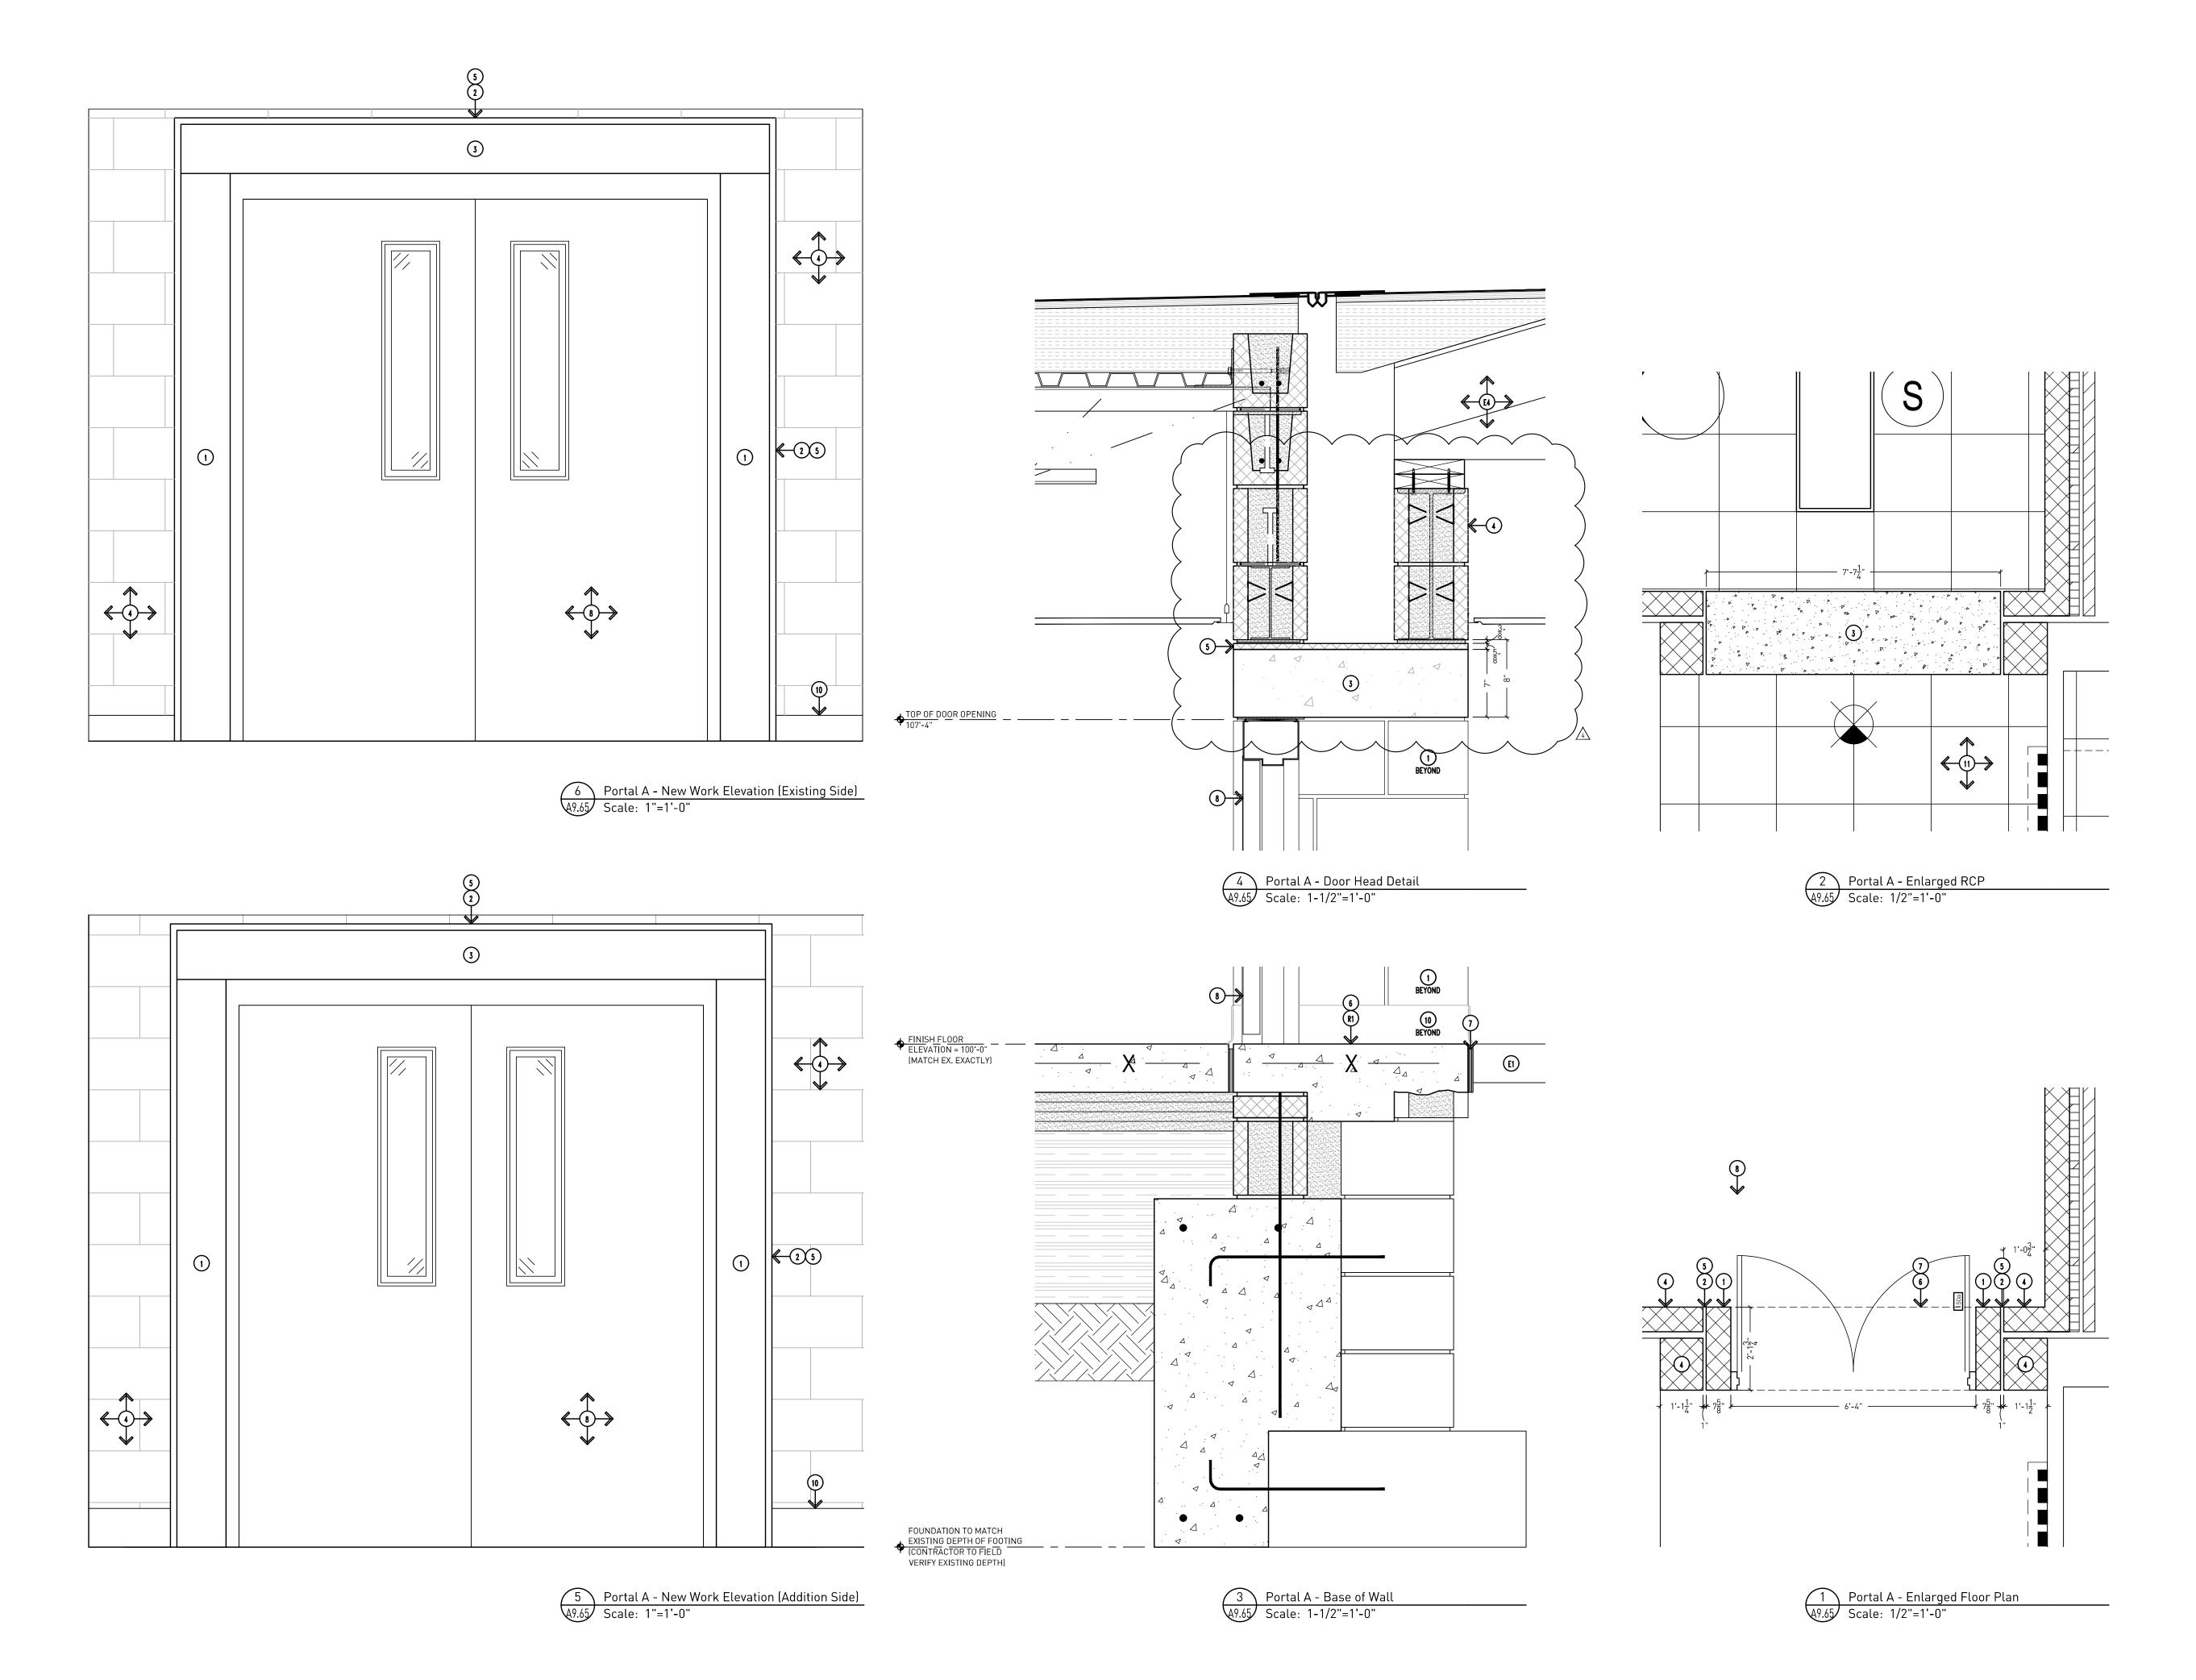

G1. DO NOT SCALE DRAWING. DRAWING SCALE IS SHOWN FOR GENERAL REFERENCE ONLY.

# EXISTING TO REMAIN NOTES:

- E1. CONCRETE FLOOR SLAB EXACT CONDITIONS UNKNOWN.
- E2. CMU BLOCK EXACT CONDITIONS UNKNOWN.
- E3. BRICK VENEER EXACT CONDITIONS UNKNOWN.
- E4. R00F, R00F STRUCTURE, AND R00F DECK EXACT CONDITIONS UNKNOWN.
- E5. WALL INSULATION EXACT CONDITIONS UNKNOWN.

### **REMOVAL NOTES:**

R1. EXISTING FLOOR MINIMUM 4" BELOW FINISH FLOOR AT LOCATION OF NEW WALL.

# DRAWING NOTES:

- 1. PORTAL WALL PIERS.
- 2. MINIMUM 1" GAP AT ALL SIDES OF THE PORTAL WALL. REFER TO SHEET A9.62 FOR FURTHER INFORMATION ON FIRESTOPPING.
- 3. C.I.P. PORTAL LID ABOVE. REFER TO STRUCTURAL DRAWINGS.
- 4. CMU MASONRY BLOCK (PAINT ALL SURFACES EXPOSED TO VIEW). TOOTH-IN AS NECESSARY.
- 5. FIRE STOP REFER TO SHEET A9.62 FOR FURTHER INFORMATION ON FIRESTOPPING.
- 6. MINIMUM 4" CONCRETE PATCH ABOVE FOUNDATION AT LOCATION OF NEW WALL.
- 7. TRANSITION STRIP.8. DOOR, FRAME, AND HARDWARE. REFER TO DOOR SCHEDULE AND SPECIFICATIONS.
- 9. STRUCTURAL SUPPORT FOR EXISTING BRICK REFER TO STRUCTURAL DRAWINGS.

  10. WALL BASE. REFER TO FINISH SCHEDULE.
- 11. ACOUSTICAL CEILING TILE IN PREFINISHED METAL GRID SYSTEM ATTACHED TO BUILDING STRUCTURE ABOVE.



Addendum #4: 17 August 2023
Bidding and Permits: 31 July 2023


# Portal A Details



Crestwood School District Cherry Hill Baptist Church Administration Relocation and Addition

Project No. 3221

A9.65

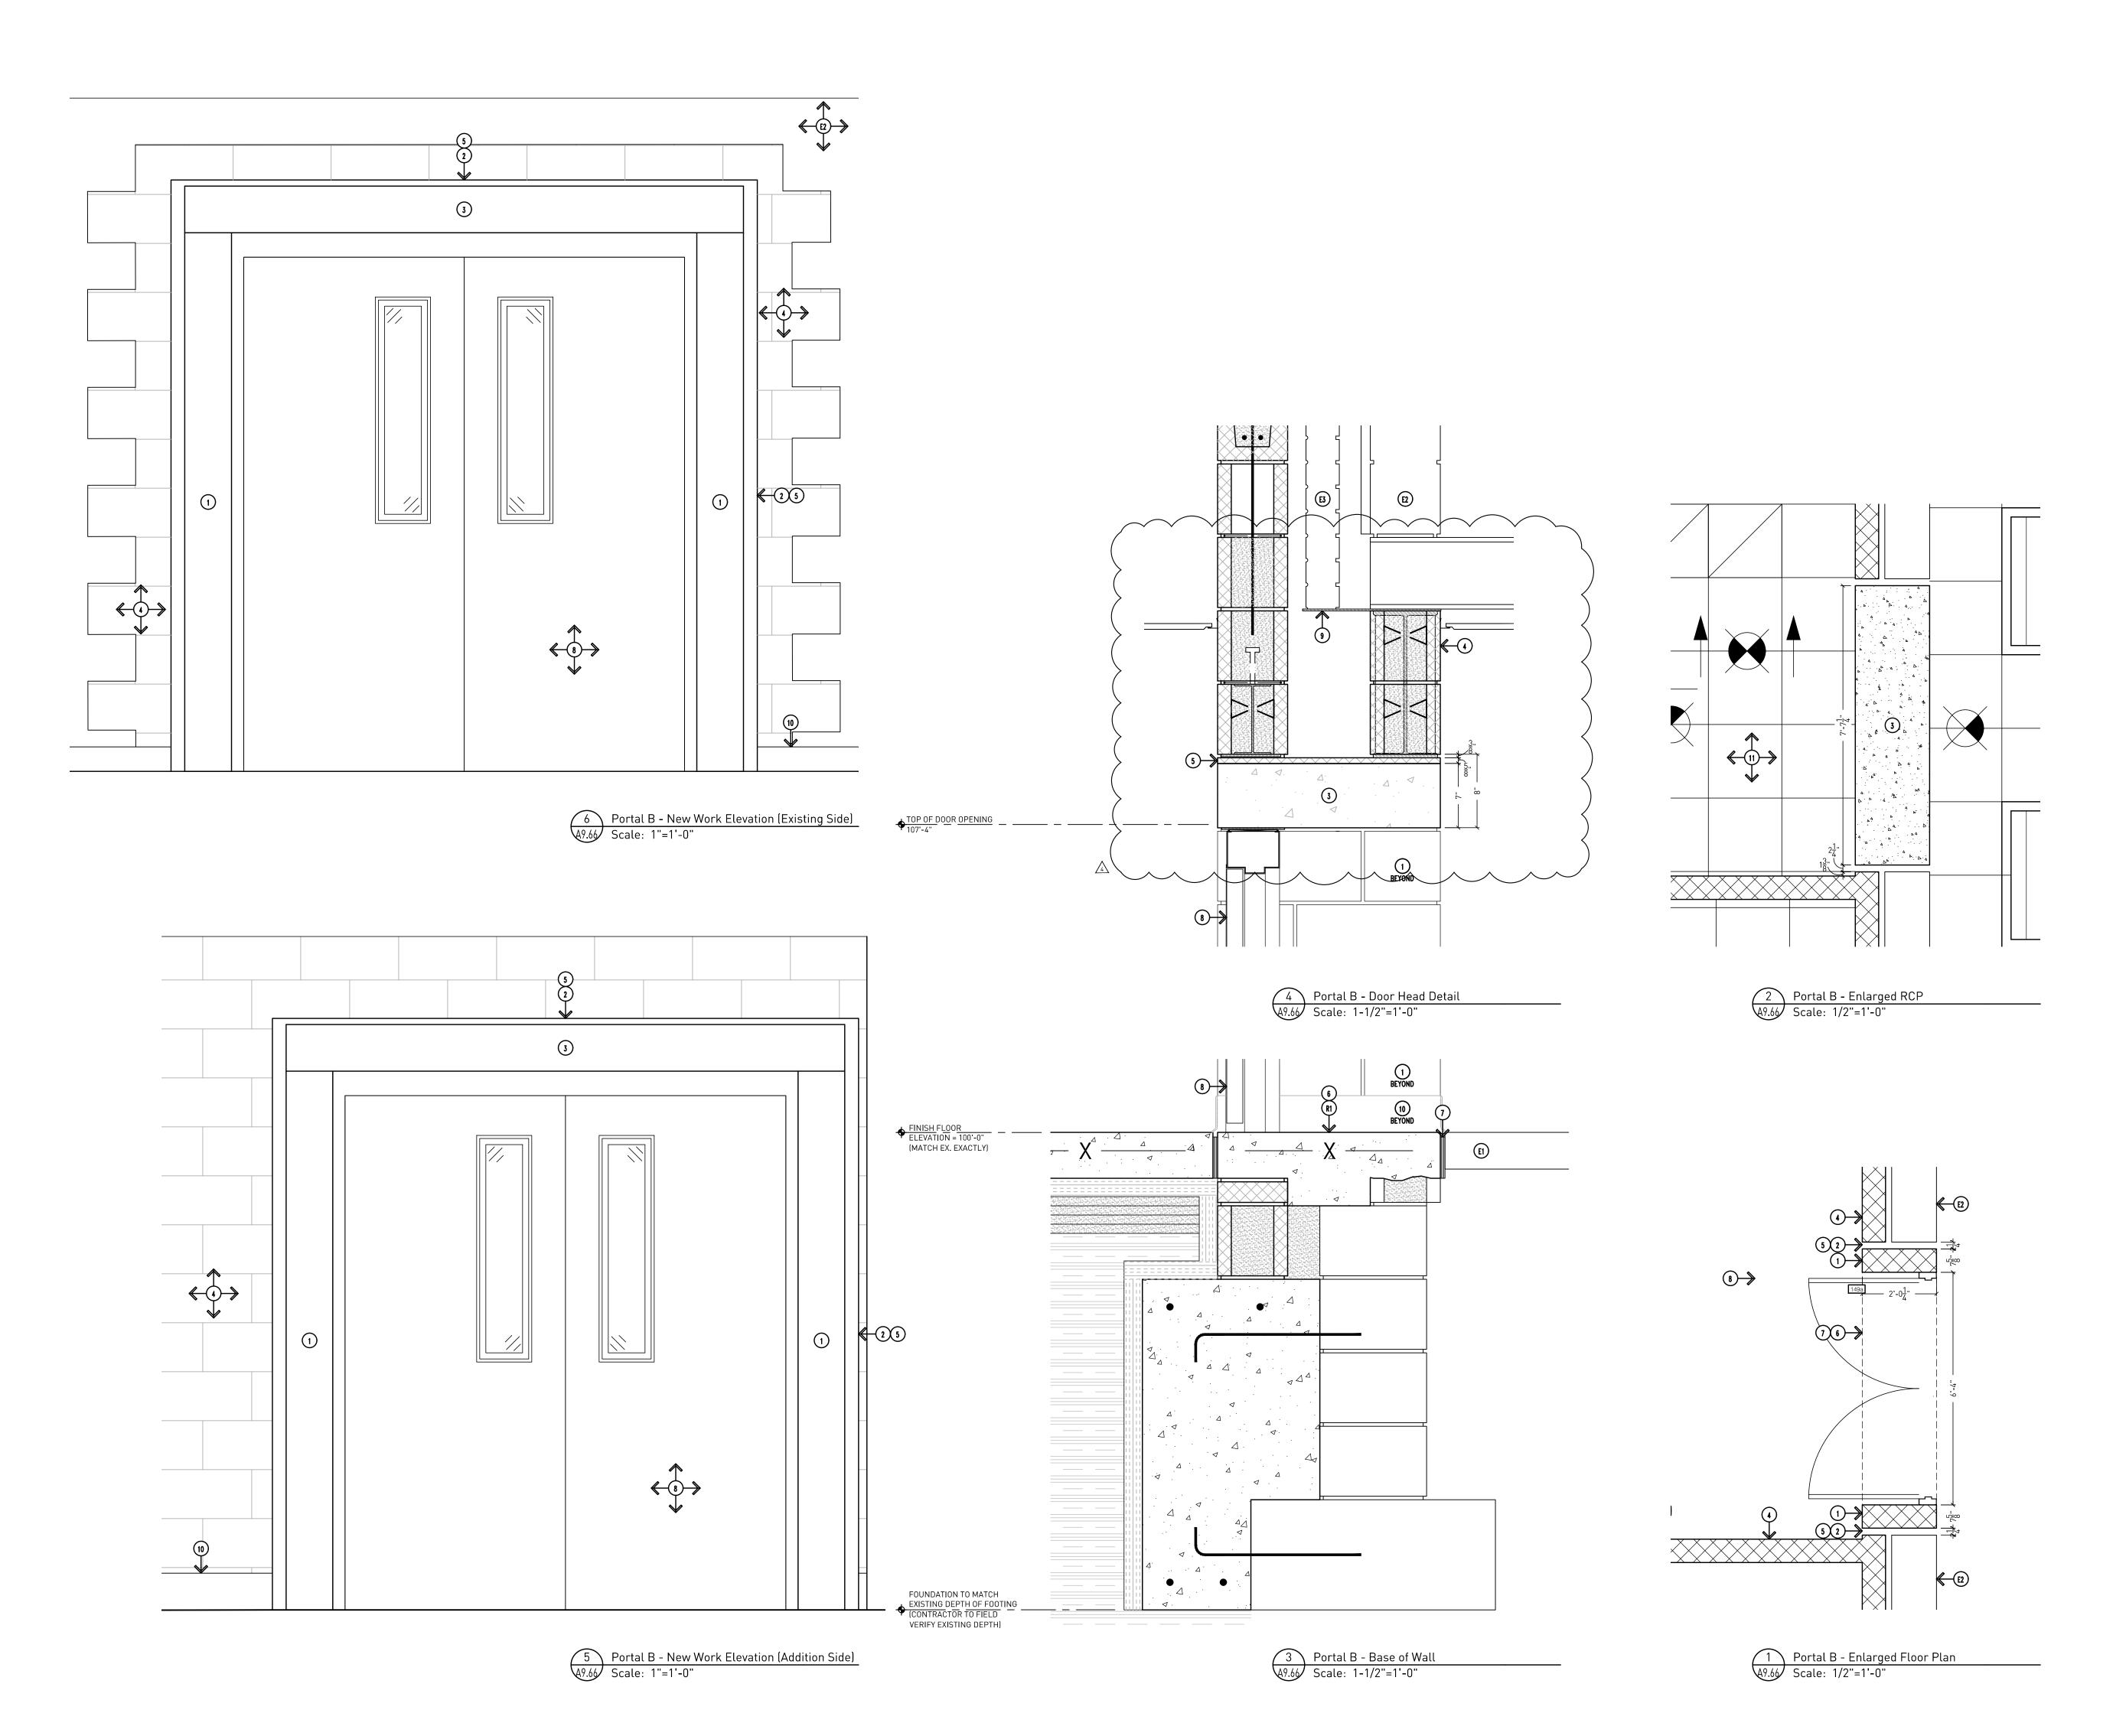

G1. DO NOT SCALE DRAWING. DRAWING SCALE IS SHOWN FOR GENERAL REFERENCE ONLY.

# EXISTING TO REMAIN NOTES:

- E1. CONCRETE FLOOR SLAB EXACT CONDITIONS UNKNOWN.
- E2. CMU BLOCK EXACT CONDITIONS UNKNOWN.
- E3. BRICK VENEER EXACT CONDITIONS UNKNOWN.
- E4. ROOF, ROOF STRUCTURE, AND ROOF DECK EXACT CONDITIONS UNKNOWN.
- E5. WALL INSULATION EXACT CONDITIONS UNKNOWN.

### REMOVAL NOTES:

R1. EXISTING FLOOR MINIMUM 4" BELOW FINISH FLOOR AT LOCATION OF NEW WALL.

# DRAWING NOTES:

- 1. PORTAL WALL PIERS.
- 2. MINIMUM 1" GAP AT ALL SIDES OF THE PORTAL WALL. REFER TO SHEET A9.62 FOR FURTHER INFORMATION ON FIRESTOPPING.
- 3. C.I.P. PORTAL LID ABOVE. REFER TO STRUCTURAL DRAWINGS.
- 4. CMU MASONRY BLOCK (PAINT ALL SURFACES EXPOSED TO VIEW). TOOTH-IN AS NECESSARY.
- 5. FIRE STOP REFER TO SHEET A9.62 FOR FURTHER INFORMATION ON FIRESTOPPING.6. MINIMUM 4" CONCRETE PATCH ABOVE FOUNDATION AT LOCATION OF NEW WALL.
- 7. TRANSITION STRIP.
- 8. DOOR, FRAME, AND HARDWARE. REFER TO DOOR SCHEDULE AND SPECIFICATIONS.

  9. STRUCTURAL SUPPORT FOR EXISTING BRICK REFER TO STRUCTURAL DRAWINGS.
- 10. WALL BASE. REFER TO FINISH SCHEDULE.

11. ACOUSTICAL CEILING TILE IN PREFINISHED METAL GRID SYSTEM ATTACHED TO BUILDING STRUCTURE ABOVE.



Addendum #4: 17 August 2023
Bidding and Permits: 31 July 2023


# Portal B Details



Crestwood School District Cherry Hill Baptist Church Administration Relocation and Addition

Project No. 3221

A9.66

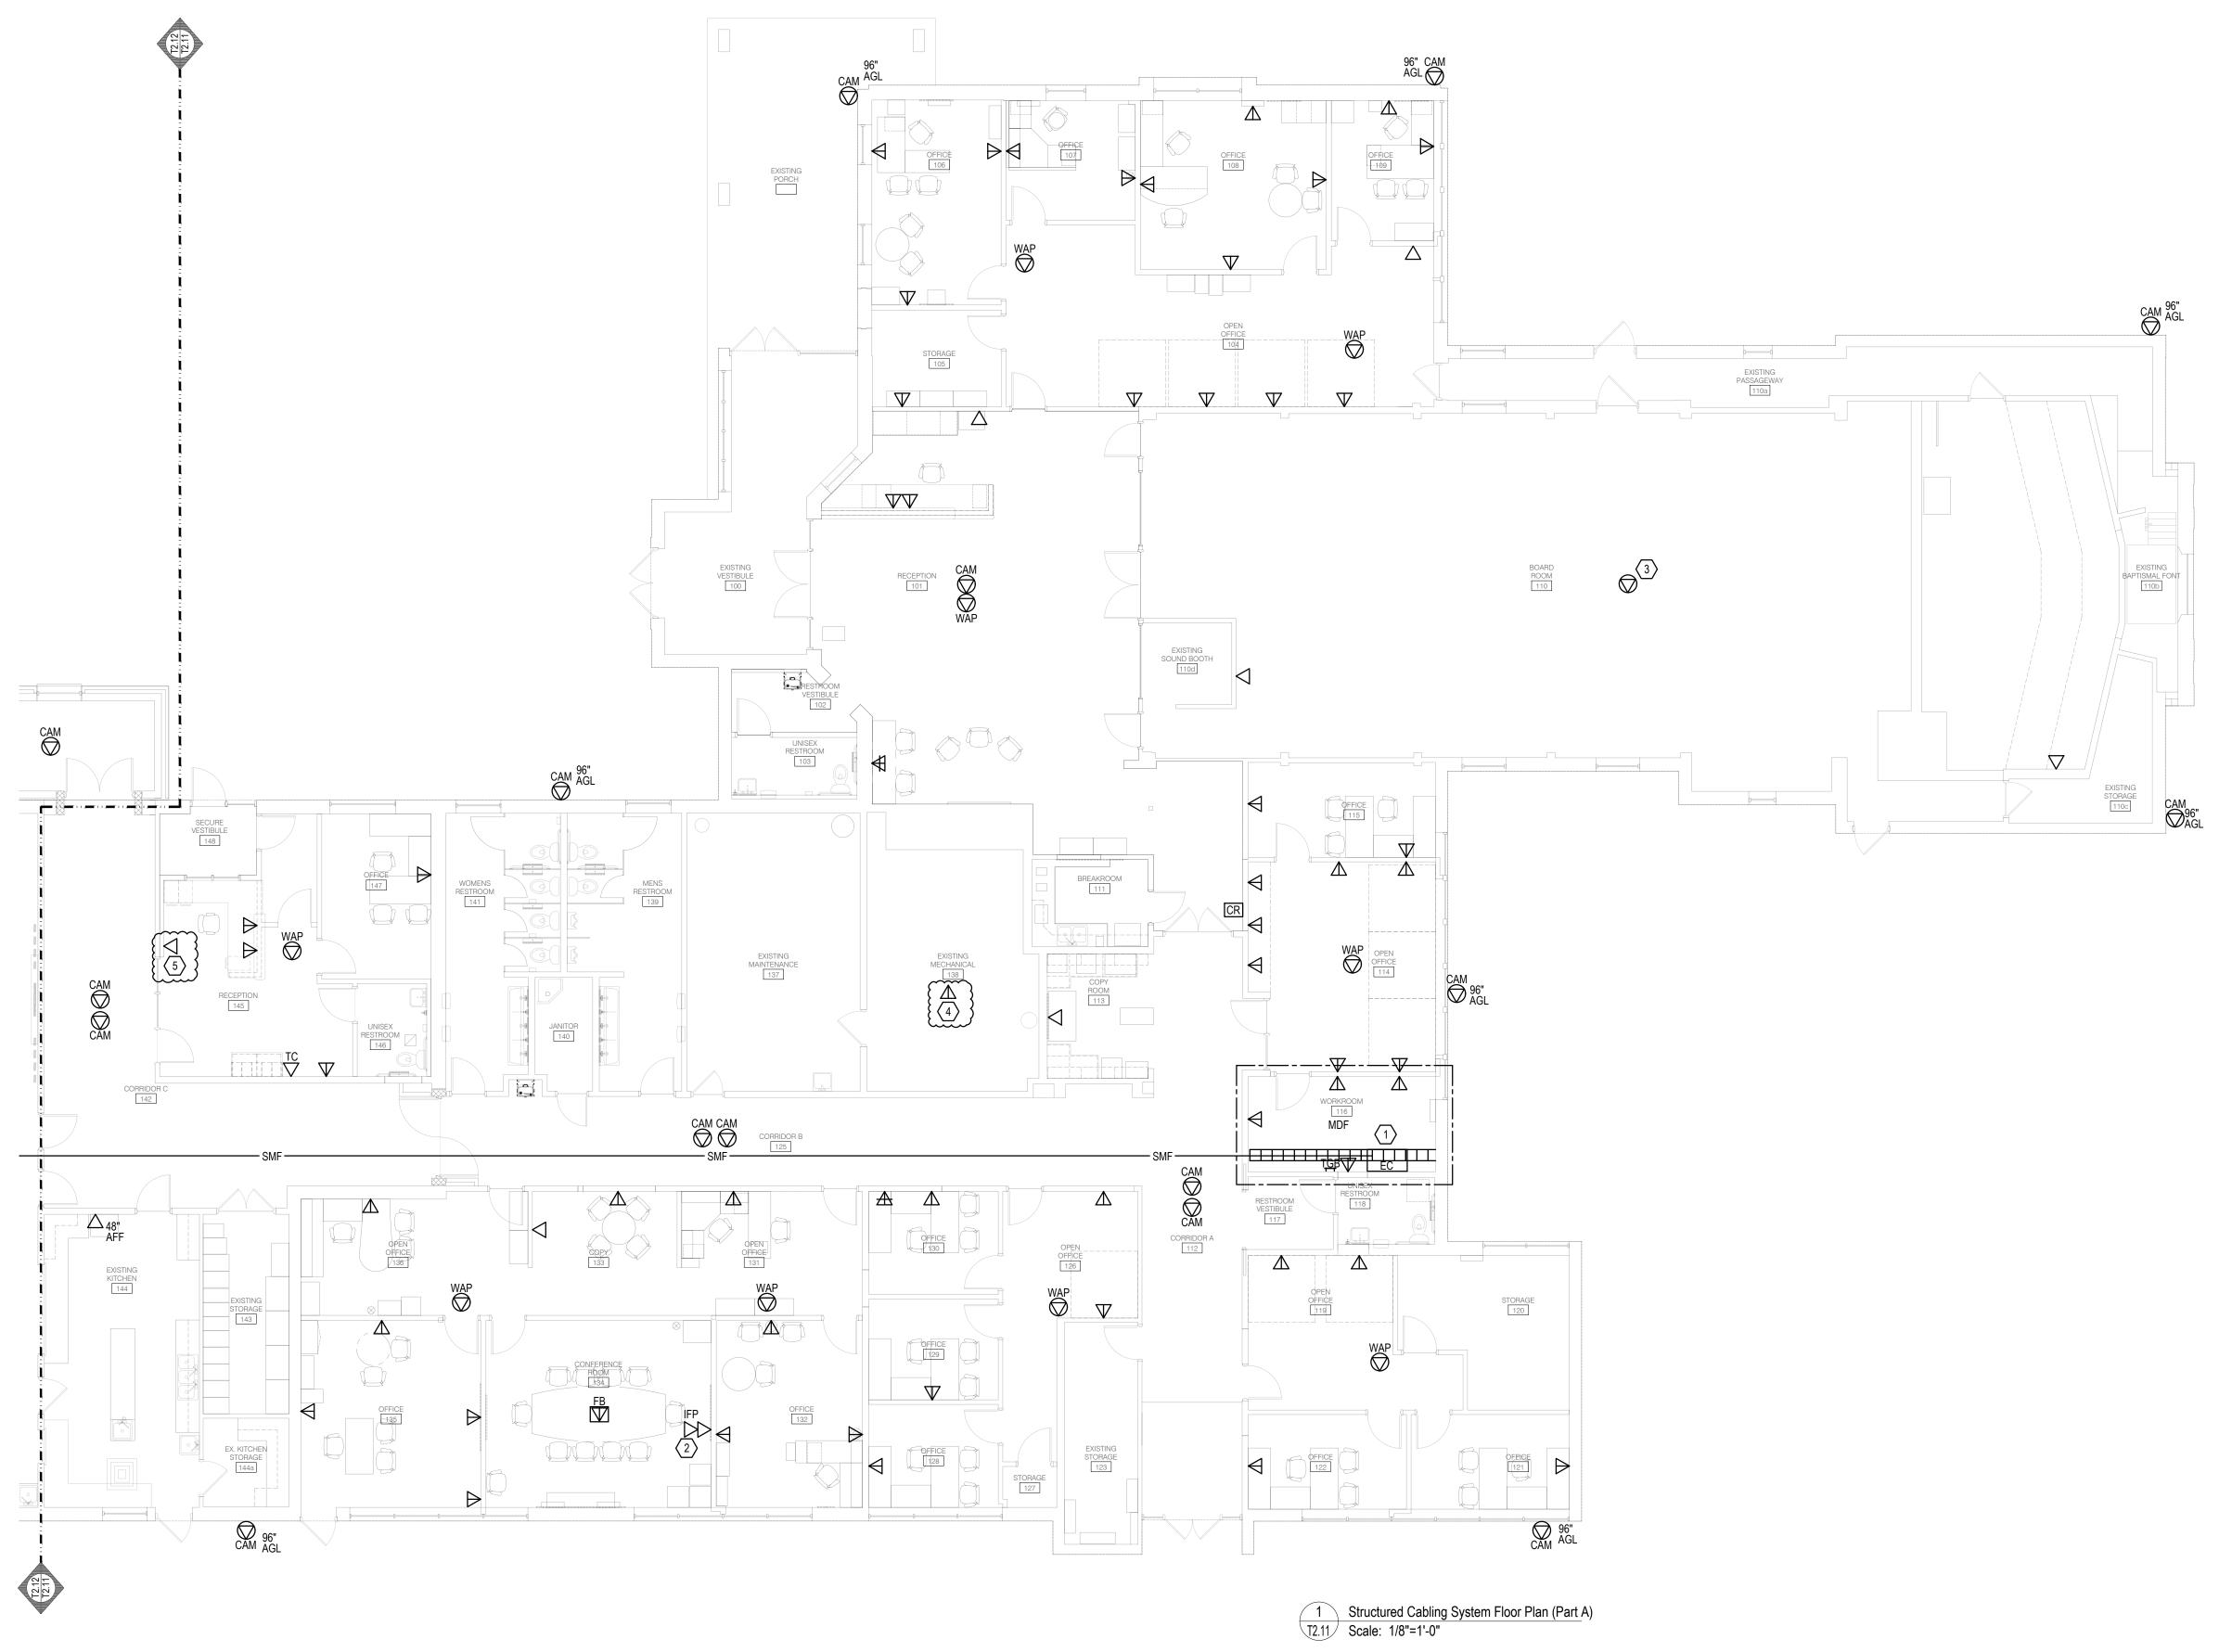







G1. DO NOT SCALE DRAWING. DRAWING SCALE IS SHOWN FOR GENERAL REFERENCE ONLY.

# GENERAL STRUCTURED CABLING NOTES

- 1. ELECTRICAL CONTRACTOR TO PROVIDE ALL BACKBOXES, CONDUITS, AND SLEEVES FOR STRUCTURED CABLING. REFER TO ELECTRICAL PLANS.
- 2. STRUCTURED CABLING CONTRACTOR SHALL FIRESTOP ALL SLEEVES AND CORES PROVIDED FOR STRUCTURED CABLING.

# KEYED STRUCTURED CABLING NOTES (#)

- FIELD COORDINATE EXACT LOCATION OF EQUIPMENT CABINET AND LADDER RACK WITH OWNER PRIOR TO INSTALLATION.
- 2. COORDINATE FINAL LOCATION WITH ELECTRICAL CONTRACTOR PRIOR
- 3. CEILING MOUNTED DATA DROP FOR IP VIDEO STREAMING CAMERA. FIELD
- COORDINATE EXACT LOCATION WITH OWNER PRIOR TO INSTALLATION.

  4. COORDINATE LOCATION OF DATA WITH MECHANICAL CONTRACTOR.

# 5. COORDINATE LOCATION OF DATA WITH FIRE ALARM CONTRACTOR.

STRUCTURED CABLING ABBREVIATIONS MAIN DISTRIBUTION FRAME

UNLESS NOTED OTHERWISE

INTERMEDIATE DISTRIBUTION FRAME ABOVE FINISHED FLOOR ABOVE GROUND LEVEL

# STRUCTURED CABLING SYMBOL LEGEND

SINGLE DATA OUTLET - WALL MOUNTED 1-GANG ONE (1) CATEGORY 6 UTP

DOUBLE DATA OUTLET - WALL MOUNTED 1-GANG TWO (2) CATEGORY 6 UTP

DOUBLE DATA OUTLET - WALL MOUNTED 2-GANG FOR TEACHER STATION TWO (2) CATEGORY 6 UTP

SINGLE DATA OUTLET - WALL MOUNTED 2-GANG FOR INTERACTIVE FLAT PANEL ONE (1) CATEGORY 6 UTP

SINGLE DATA OUTLET - IN CEILING SURFACE MOUNTED FOR SECURITY CAMERA ONE (1) CATEGORY 6 UTP

SINGLE DATA OUTLET - IN CEILING SURFACE MOUNTED FOR WIRELESS ACCESS POINT ONE (1) CATEGORY 6 UTP

**EQUIPMENT CABINET** 

TELECOMMUNICATIONS GROUNDING BUSBAR PROVIDED BY ELECTRICAL CONTACTOR

SINGLE-MODE FIBER OPTIC BACKBONE

Addendum #4: 17 August 2023
Permits & Bidding: 31 July 2023


# Structured Cabling System Floor Plan (Part A)



Crestwood School District Cherry Hill Baptist Church Administration Relocation and Addition

Project No. 3221

T2.11

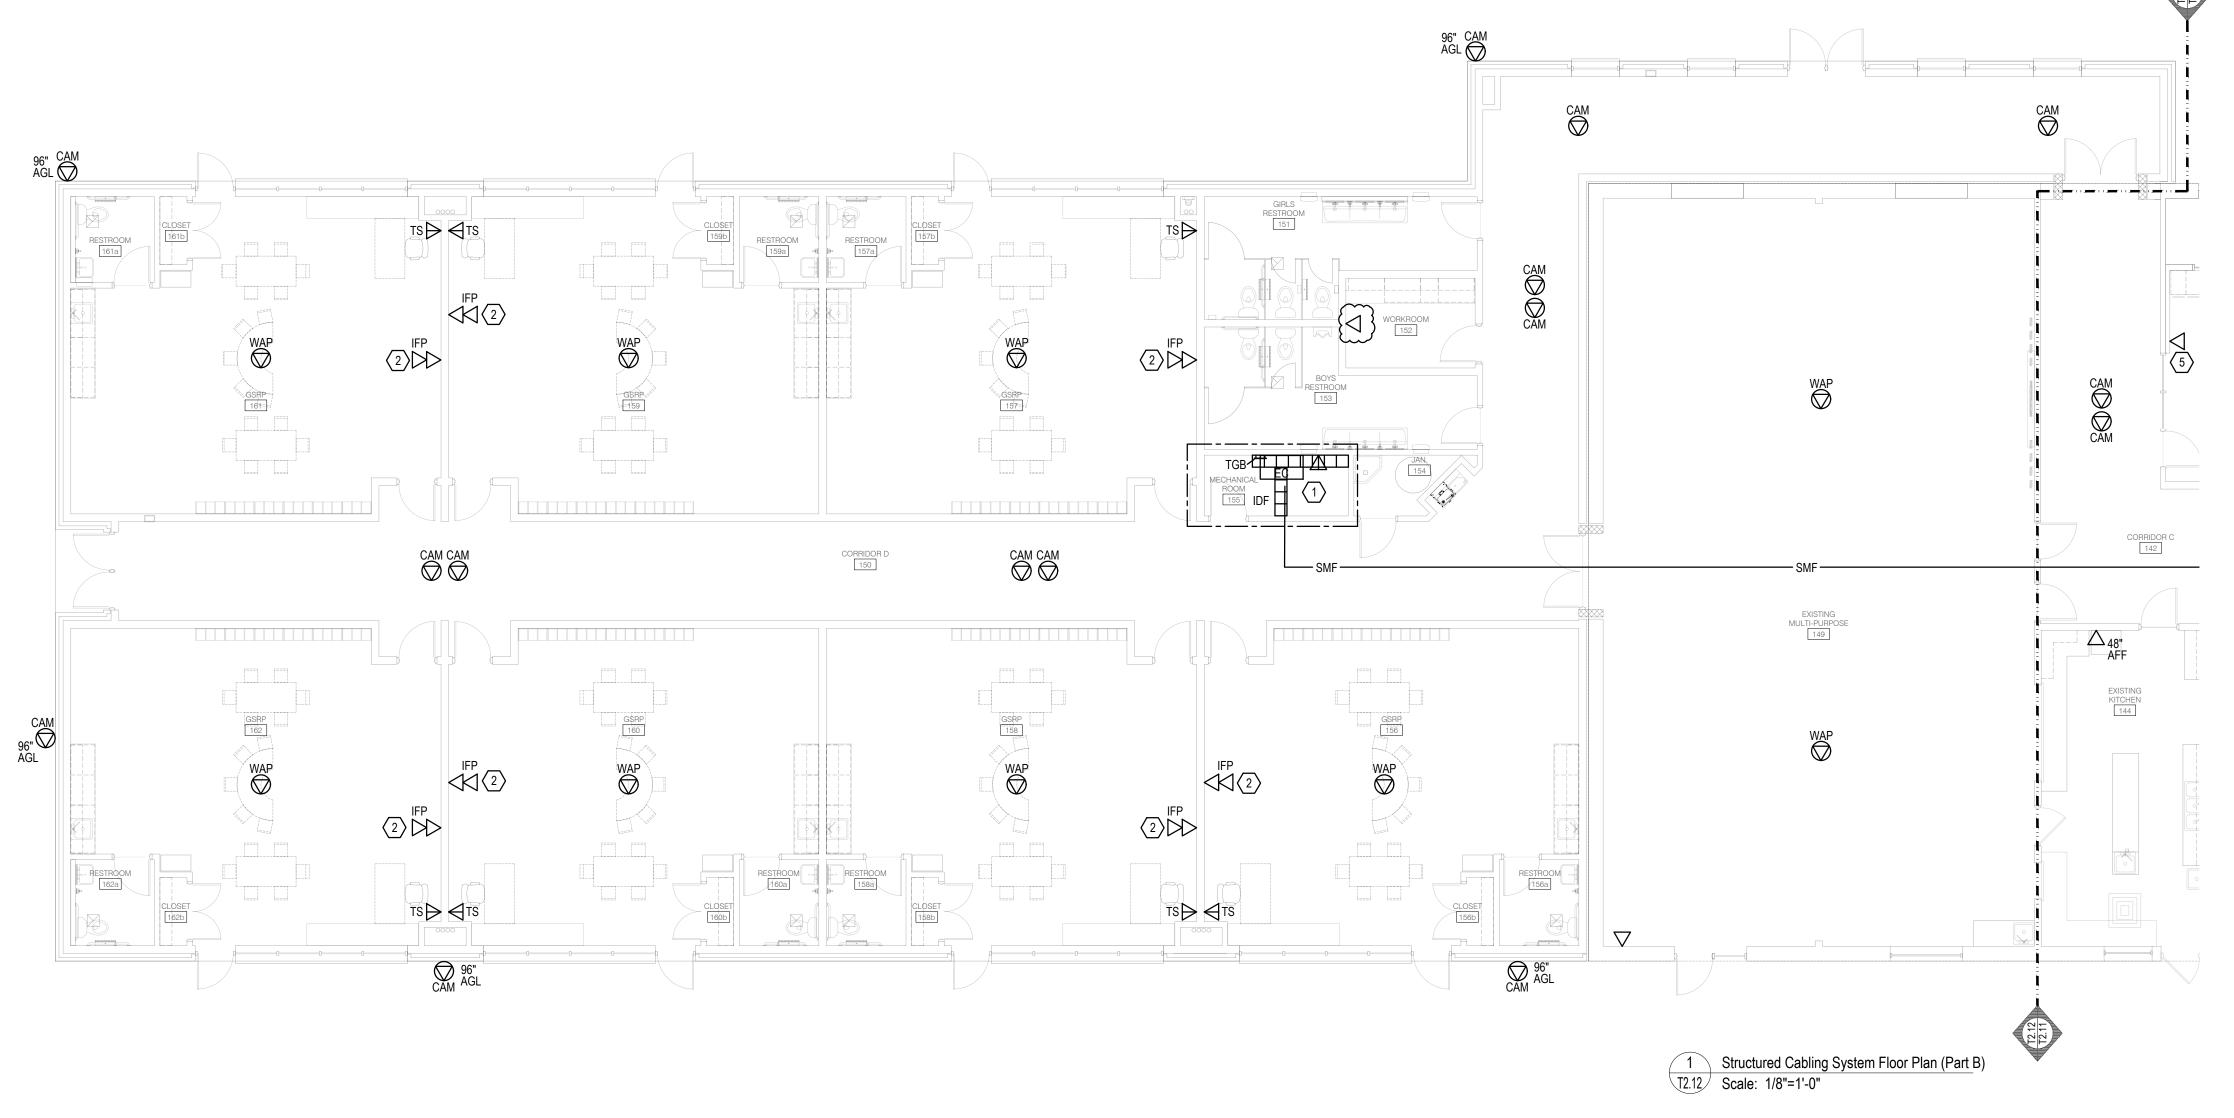





G1. DO NOT SCALE DRAWING. DRAWING SCALE IS SHOWN FOR GENERAL REFERENCE ONLY.

# GENERAL STRUCTURED CABLING NOTES

- ELECTRICAL CONTRACTOR TO PROVIDE ALL BACKBOXES, CONDUITS, AND SLEEVES FOR STRUCTURED CABLING. REFER TO ELECTRICAL PLANS.
- STRUCTURED CABLING CONTRACTOR SHALL FIRESTOP ALL SLEEVES AND CORES PROVIDED FOR STRUCTURED CABLING.

# KEYED STRUCTURED CABLING NOTES (#)

- 1. FIELD COORDINATE EXACT LOCATION OF EQUIPMENT CABINET
- AND LADDER RACK WITH OWNER PRIOR TO INSTALLATION.

  2. COORDINATE FINAL LOCATION WITH ELECTRICAL CONTRACTOR PRIOR TO INSTALLATION.

# STRUCTURED CABLING ABBREVIATIONS

MDF MAIN DISTRIBUTION FRAME
IDF INTERMEDIATE DISTRIBUTION FRAME
A.F.F. ABOVE FINISHED FLOOR
A.G.L. ABOVE GROUND LEVEL
U.N.O. UNLESS NOTED OTHERWISE

# STRUCTURED CABLING SYMBOL LEGEND

SINGLE DATA OUTLET - WALL MOUNTED 1-GANG
ONE (1) CATEGORY 6 UTP

DOUBLE DATA OUTLET - WALL MOUNTED 1-GANG

TWO (2) CATEGORY 6 UTP

TS DOUBLE DATA OUTLET - WALL MOUNTED 2-GANG FOR TEACHER STATION TWO (2) CATEGORY 6 UTP

SINGLE DATA OUTLET - WALL MOUNTED 2-GANG
FOR INTERACTIVE PANEL

ONE (1) CATEGORY 6 UTP

CAM SINGLE DATA OUTLET - IN CEILING SURFACE MOUNTED FOR SECURITY CAMERA ONE (1) CATEGORY 6 UTP

SINGLE DATA OUTLET - IN CEILING SURFACE MOUNTED FOR WIRELESS ACCESS POINT ONE (1) CATEGORY 6 UTP

EC EQUIPMENT CABINET

TELECOMMUNICATIONS GROUNDING BUSBAR PROVIDED BY ELECTRICAL CONTACTOR

SMF SINGLE-MODE FIBER OPTIC BACKBONE

Addendum #4: 17 August 2023

Permits & Bidding: 31 July 2023

# Structured Cabling System Floor Plan (Part B)



Crestwood School District
Cherry Hill Baptist Church
Administration Relocation and Addition

Project No. 3221

T2.12

803 W. Big Beaver Road, Suite 350, Troy, MI 48084 | 248.244.9710

© Ehresman Architects 2023

00 0115 List of Drawing Sheets Project No.: 3221

Page 1

#### SECTION 00 0115 LIST OF DRAWING SHEETS

116	IIILE SHEET
A00	GENERAL INFORMATION
A0.01	CODE REVIEW PLAN
A0.05	COMPOSITE PHASING PLAN
A0.06	PHASE 1
A0.07	PHASE 2 & 3
80.0A	PROJECT IDENTIFICATION SIG

#### **SURVEY DRAWINGS:**

C1 OF 2 TOPOGRAPHICAL SURVEY C2 OF 2 TOPOGRAPHICAL SURVEY

#### **CIVIL DRAWINGS:**

C1.0	GENERAL PLAN
C2.1	DEMOLITION PLAN
C3.1	UTILITY PLAN
C4.1	PAVING AND LAYOUT PLAN
C5.1	GRADING PLAN
C6.1	SOIL EROSION AND SEDIMENTATION CONTROL PLAN

#### LANDSCAPE DRAWINGS:

L.101	SITE PLAN LANDSCAPE PLAN
L.102	SITE PLAN LANDSCAPE PLAN
L.301	SITE PLAN LANDSCAPE PLAN
L.302	SITE PLAN LANDSCAPE PLAN
L.601	SITE PLAN LANDSCAPE PLAN - SPECIFICATIONS
L.602	SITE PLAN LANDSCAPE PLAN - SPECIFICATIONS
L.603	SITE PLAN LANDSCAPE PLAN - SPECIFICATIONS

00 0115 List of Drawing Sheets Project No.: 3221

Page 2

#### STRUCTURAL DRAWINGS: S0.01 GENERAL STRU

S0.01	GENERAL STRUCTURAL NOTES
S0.02	<b>GENERAL STRUCTURAL NOTES</b>
S0.03	SPECIAL INSPECTION SCHEDULES

#### S2.01 LOAD MAPS

S2.10	FOUNDATION PLAN
S2.11	ROOF FRAMING PLAN

#### S3.00 TYPICAL CONCRETE SECTIONS

S4.00	TYPICAL MASONRY SECTIONS
S4.01	TYPICAL MASONRY SECTIONS

S6.00	TYPICAL STEEL DETAILS
S6.01	TYPICAL STEEL DETAILS

S7.00 SECTIONS AND DETAILS S7.01 SECTIONS AND DETAILS

#### **ARCHITECTURAL DRAWINGS:**

A0.12 DUMPSTER ENCLOSURE PLAN & DETAILS

#### A1.10 REMOVALS COMPOSITE PLAN

- A1.11 REMOVALS FLOOR PLAN (AREA A)
- A1.12 REMOVALS FLOOR PLAN (AREA B)
- A1.13 REMOVALS CEILING PLAN (AREA A)
- A1.14 REMOVALS CEILING PLAN (AREA B)
- A1.15 REMOVALS ELEVATIONS
- A1.16 REMOVALS ELEVATIONS

#### A2.10 COMPOSITE FLOOR PLAN

- A2.11 FLOOR PLAN (AREA A)
- A2.12 FLOOR PLAN (AREA B)

Page 3

Addendum #004

A2.13 **DIMENSION PLAN (AREA A)** A2.14 **DIMENSION PLAN (AREA B** A2.50 **COMPOSITE ROOF PLAN** A2.60 **DOOR SCHEDULE** A2.61 **DOOR SCHEDULE** A2.80 **CABINET SCHEDULE / DETAILS** A3.00 **EXTERIOR ELEVATIONS** A3.01 **EXTERIOR ELEVATIONS** A3.02 **EXTERIOR ELEVATIONS** A3.03 **EXTERIOR ELEVATIONS** A3.50 **BUILDING SECTIONS** A3.51 **BUILDING SECTIONS** A3.52 **BUILDING SECTIONS BUILDING SECTIONS - ALTERNATE #1** A3.53 A4.00 **ENLARGED FLOOR PLANS (RESTROOMS)** A4.01 **ENLARGED FLOOR PLANS** A5.00 **INTERIOR ELEVATIONS** A5.01 **INTERIOR ELEVATIONS** A5.02 **INTERIOR ELEVATIONS** A5.03 **INTERIOR ELEVATIONS** A6.10 **COMPOSITE RCP** A8.10 **COMPOSITE FINISH PLAN** A8.11 FINISH PLAN AREA A A8.12 FINISH PLAN AREA B A8.50 **ROOM FINISH SCHEDULE** A8.51 **MATERIAL SCHEDULE** A8.52 **WALL AND FLOOR TILE DETAILS** 

00 0115 List of Drawing Sheets Project No.: 3221 Page 4

A9.00	EXTERIOR WALL SECTIONS
A9.01	EXTERIOR WALL SECTIONS
A9.02	EXTERIOR WALL SECTIONS
A9.03	EXTERIOR WALL SECTIONS
A9.10	EXTERIOR DETAILS
A9.11	EXTERIOR DETAILS
A9.12	EXTERIOR DETAILS
A9.13	EXTERIOR DETAILS
A9.14	STANDARD EXTERIOR DETAILS
A9.50	INTERIOR WALL SECTIONS
A9.51	INTERIOR WALL SECTIONS
A9.52	INTERIOR WALL SECTIONS
A9.55	PORTAL WALL SECTIONS
A9.60	INTERIOR DETAILS
A9.61	INTERIOR DETAILS
A9.62	INTERIOR DETAILS
A9.65	PORTAL A DETAILS
A9.66	PORTAL B DETAILS
MECHANIC	CAL DRAWINGS:

M0.01	MECHANICAL STANDARDS AND DRAWING INDEX
MD2.11	PLUMBING DEMOLITION PLAN (PART A)
MD3.11	HVAC PIPING DEMOLITION PLAN (PART A)
MD3.12	HVAC PIPING DEMOLITION PLAN (PART B)
MD4.11	SHEET METAL DEMOLITION PLAN (PART A)
MD4.12	SHEET METAL DEMOLITION PLAN (PART B)
M2.01	UNDERGROUND PLUMBING PLAN (PART A)
M2.02	UNDERGROUND PLUMBING PLAN (PART B)
M2.11	PLUMBING PLAN (PART A)
M2.12	PLUMBING PLAN (PART B)

M3.11	HVAC PIPING PLAN [PART A)
M3.12	HVAC PIPING PLAN [PART B)
	• ,
M4.11	REFRIGERANT PIPING PLAN (PART A)
M4.12	REFRIGERANT PIPING PLAN (PART B)
	,
M5.11	SHEET METAL PLAN (PART A)
M5.11-ALT	SHEET METAL PLAN (PART A) - ALTERNATE
M5.12	SHEET METAL PLANT (PART B)
M6.01	MECHANICAL DETAILS
M6.02	MECHANICAL DETAILS
M6.03	MECHANICAL DETAILS
M6.04	MECHANICAL DETAILS
M6.05	MECHANICAL DETAILS
M7.01	MECHANICAL SCHEDULES
M7.02	MECHANICAL SCHEDULES
M7.03	MECHANICAL SCHEDULES
M7.04	MECHANICAL SCHEDULES
M7.05	MECHANICAL SCHEDULES
M8.01	TEMPERATURE CONTROL STANDARDS AND GENERAL NOTES
M8.02	TEMPERATURE CONTROLS
M8.03	TEMPERATURE CONTROLS
M8.04	TEMPERATURE CONTROLS
M8.05	TEMPERATURE CONTROLS
ELECTRIC	AL DRAWINGS:
E0.01	ELECTRICAL STANDARDS AND DRAWING INDEX
E0.02	ELECTRICAL STANDARD SCHEDULES
ED0.03	ELECTRICAL SITE DEMOLITION PLAN
E0.03	ELECTRICAL SITE NEW WORK PLAN
E0.04	ELECTRICAL COMPOSITE PLAN

Addendum #004

00 0115 List of Drawing Sheets Project No.: 3221 Page 6

ED1.11	ELECTRICAL DEMOLITION PLAN (PART A)
ED1.12	ELECTRICAL DEMOLITION PLAN (PART B)
E2.11	LIGHTING PLAN (PART A)
E2.12	LIGHTING PLAN (PART B)
E3.11	POWER PLAN (PART A)
E3.12	POWER PLAN (PART B)
E5.01	ONE LINE DIAGRAM
E5.02	PANEL SCHEDULES
E5.03	PANEL SCHEDULES
E7.01	ELECTRICAL DETAILS AND DIAGRAMS
E7.02	ELECTRICAL DETAILS AND DIAGRAMS
E7.03	ELECTRICAL DETAILS AND DIAGRAMS
E7.04	ELECTRICAL DETAILS AND DIAGRAMS
E7.05	ELECTRICAL DETAILS AND DIAGRAMS
TECHNOL	OGY DRAWINGS:
T2.10	STRUCTURED CABLING SYSTEM COMPOSITE FLOOR PLAN
T2.11	STRUCTURED CABLING SYSTEM FLOOR PLAN (PART A)
T2.12	STRUCTURED CABLING SYSTEM FLOOR PLAN (PART B)
T7.01	STRUCTURED CABLING SYSTEM DETAILS
TP2.10	PUBLIC ADDRESS SYSTEM COMPOSITE FLOOR PLAN
TP2.11	PUBLIC ADDRESS FLOOR PLAN (PART A)
TP2.12	PUBLIC ADDRESS FLOOR PLAN (PART B)
TY2.10	SECURITY SYSTEM COMPOSITE FLOOR PLAN
TY2.11	SECURITY SYSTEM FLOOR PLAN (PART A)
114.14	SECURITY SYTEM FLOOR PLAN (PART B)
TV7 01	SECURITY SYSTEM DETAILS
117.01	SLOSINI I SISILIVI DEIAILS

**END OF SECTION** 

08 0671 Door Hardware Schedule Project No.: 3221

Page 1

#### SECTION 08 0671 DOOR HARDWARE SCHEDULE

#### **ALUMINUM FRAMES**

#### Hardware Set #1: Existing Exterior Aluminum Double Doors Security

Electric Strike

Power Supply

**Auto Operator** 

ADA Push Button Actuator (on both sides of doors w/ wiring harness and weather ring)

Card Reader (by Security)

#### Hardware Set #2: Exterior Aluminum/FRP Double Doors Card Reader

Continuous hinges with wiring harness

Exit devices with electrified panic w/dogging

Pulls by door manufacturer

Cylinder/cores

Closers

Thresholds

Weatherstripping

Sill Sweep by door manufacturer

Power Supply

Card Reader (by Security)

#### Hardware Set #3: Exterior Aluminum/FRP Double Doors

Continuous hinges

Exit devices w/dogging

Pulls by door manufacturer

Cylinder/cores

Closers

Thresholds

Weatherstripping

Sill Sweep by door manufacturer

#### Hardware Set #4: Exterior Aluminum/FRP Single Door Security

Continuous hinge with wiring harness

Exit device with electrified panic w/dogging

Pulls by door manufacturer

Cylinder/cores

Closers

Thresholds

Weatherstrippings

Sill Sweep by door manufacturer

Power Supply

Auto Operator

ADA Push Button Actuator (on both sides of doors w/ wiring harness and weather ring)

Card Reader (by Security)

#### Hardware Set #5: Exterior Aluminum/FRP Single Door

Continuous hinge

Exit device (no exterior trim)

Cylinder/core

Closer

Threshold

Weatherstripping

Sill Sweep by door manufacturer

Page 2

#### Hardware Set #6: Interior Aluminum/FRP Double Doors Security

Continuous hinges with wiring harness

Exit devices with concealed vertical rod, electrified panic w/dogging

Pulls by door manufacturer

Cylinder/cores

Closers

Overhead Stops

**Auto Operator** 

**Power Supply** 

ADA Push Button Actuator (on both sides of doors w/ wiring harness and weather ring)

Card Reader (by Security)

Remote Release

#### Hardware Set #7: Interior Aluminum Single Door Security

Continuous hinge with wiring harness

Exit device with electrified panic w/dogging

Pull by door manufacturer

Cylinder/core

Closer

**Auto Operator** 

**Power Supply** 

ADA Push Button Actuator (on both sides of doors w/ wiring harness and weather ring)

Card Reader (by Security)

Remote Release

#### **HM FRAMES**

#### Hardware Set #10: Double Fire Doors w/ electromagnetic holder

Continuous hinges

Exit devices and lever trim

Closers with electromagnetic holder

Astragal (by HM Door Manufacturer)

Coordinator

Overhead Stops

Kickplates

Gasketing

**Power Supply** 

#### Hardware Set #11: Double Egress Fire Doors w/card reader

Continuous hinges

**Push Plates** 

Magnetic Locks (Fail Safe)

Closers

Astragal (by HM Door Manufacturer)

**Kickplates** 

Wall Stops

Gasketing

Power Supply

Card Reader (by Security)

Push Button

Motion Sensor

#### Hardware Set #12: Double Fire Doors

**Continuous Hinges** 

Exit device with visual security indicator and ADA thumb turn and lever trim

Closers

Removable Mullion (by HM Door Manufacturer)

Overhead Stop

**Kickplates** 

Gasketing

#### Page 3

#### Hardware Set #13: Double Closet Doors

Hinges

Flush Bolt (top and bottom)

Lockset (Classroom 2)

#### Hardware Set #15: Single Door Fire Rated w/ Card Reader

Hinges

Lockset (Secure)

Cylinder/core

Closer

Electric strike

Kickplate

Wall Stop

Gasketing

Power Supply

Card Reader(s) (by Security)

Remote Release

#### Hardware Set #16: Single Door Office

Hinges

Lockset (Office)

Cylinder/core

Wall Stop

Gasketing (for acoustics)

#### Hardware Set #17: Single Door Fire Rated w/ Visual Security Indicator

Hinges

Lockset with Visual Security Indicator (Classroom)

Cylinder/core

Closer

Kickplate

Wall Stop

Gasketing

#### Hardware Set #18: Single Door Privacy

Hinges

Lockset w/ occupied indicator (Privacy)

Cylinder/core

Wall Stop

Gasketing (for acoustics)

#### Hardware Set #19: Single Door Gang Restroom

Hinges

Push/Pull

Deadlock

Closer with Hold Open

Kickplate

Wall Stop

#### Hardware Set #20: Single Door Storage

Hinges

Lockset (Storeroom)

Cylinder/core

Kickplate

Wall Stop

Ehresman Architects Crestwood School District Cherry Hill Baptist Church (CHBC 08 0671 Door Hardware Schedule Project No.: 3221 Page 4

#### Hardware Set #21: Single Door Fire Rated Janitor

Hinges Lockset (Storeroom) Cylinder/core Closer w/ delayed closing option Kickplate Wall Stop Gasketing

#### Hardware Set #22: Single Fire Door

Hinges
Exit device with visual security indicator and ADA thumb turn and lever trim
Closer
Kickplates
Overhead Stop
Gasketing

Page 1

Addendum #004

# SECTION 08 1113 HOLLOW METAL DOORS AND FRAMES

#### **PART 1 GENERAL**

#### 1.01 SECTION INCLUDES

- A. Non-fire-rated hollow metal frames.
- B. Hollow metal frames for wood doors.
- C. Fire-rated hollow metal doors and frames.

#### 1.02 RELATED REQUIREMENTS

- A. Section 08 7100 Door Hardware.
- B. Section 08 8000 Glazing: Glass for doors and borrowed lites.
- Section 09 9000 Painting and Coating Commercial Facility Guide Specification Sherwin Williams.

#### 1.03 REFERENCE STANDARDS

- ADA Standards Americans with Disabilities Act (ADA) Standards for Accessible Design 2010.
- B. ANSI/SDI A250.4 Test Procedure and Acceptance Criteria for Physical Endurance for Steel Doors, Frames and Frame Anchors 2018.
- C. ANSI/SDI A250.8 Specifications for Standard Steel Doors and Frames (SDI-100) 2017.
- D. ANSI/SDI A250.10 Test Procedure and Acceptance Criteria for Prime Painted Steel Surfaces for Steel Doors and Frames 2020.
- E. ASTM A653/A653M Standard Specification for Steel Sheet, Zinc-Coated (Galvanized) or Zinc-Iron Alloy-Coated (Galvannealed) by the Hot-Dip Process 2020.
- F. ASTM A1008/A1008M Standard Specification for Steel, Sheet, Cold-Rolled, Carbon, Structural, High-Strength Low-Alloy, High-Strength Low-Alloy with Improved Formability, Required Hardness, Solution Hardened, and Bake Hardenable 2021a.
- G. ASTM A1011/A1011M Standard Specification for Steel, Sheet and Strip, Hot-Rolled, Carbon, Structural, High-Strength Low-Alloy, High-Strength Low-Alloy with Improved Formability, and Ultra-High Strength 2018a.
- H. BHMA A156.115 American National Standard for Hardware Preparation in Steel Doors and Steel Frames 2016.
- ICC A117.1 Accessible and Usable Buildings and Facilities 2017.
- J. ITS (DIR) Directory of Listed Products current edition.
- K. NAAMM HMMA 830 Hardware Selection for Hollow Metal Doors and Frames 2002.
- L. NAAMM HMMA 831 Hardware Locations for Hollow Metal Doors and Frames 2011.
- M. NAAMM HMMA 840 Guide Specifications For Receipt, Storage and Installation of Hollow Metal Doors and Frames 2007.
- N. NAAMM HMMA 861 Guide Specifications for Commercial Hollow Metal Doors and Frames 2014.
- O. NFPA 80 Standard for Fire Doors and Other Opening Protectives 2019.
- P. NFPA 252 Standard Methods of Fire Tests of Door Assemblies 2017.
- Q. SDI 117 Manufacturing Tolerances for Standard Steel Doors and Frames 2013.
- R. UL (DIR) Online Certifications Directory Current Edition.
- S. UL 10C Standard for Positive Pressure Fire Tests of Door Assemblies Current Edition, Including All Revisions.

## Page 2

Project No.: 3221

#### 1.04 SUBMITTALS

- A. See Section 01 3000 Administrative Requirements for submittal procedures.
- B. Product Data: Materials and details of design and construction, hardware locations, reinforcement type and locations, anchorage and fastening methods, and finishes; and one copy of referenced standards/guidelines.
- C. Shop Drawings: Details of each opening, showing elevations, glazing, frame profiles, and any indicated finish requirements.

# 1.05 QUALITY ASSURANCE

- A. Manufacturer Qualifications: Company specializing in manufacturing products specified in this section, with not less than three years documented experience.
- B. Maintain at project site copies of reference standards relating to installation of products specified.

# 1.06 DELIVERY, STORAGE, AND HANDLING

- A. Comply with NAAMM HMMA 840 or ANSI/SDI A250.8 (SDI-100) in accordance with specified requirements.
- B. Protect with resilient packaging; avoid humidity build-up under coverings; prevent corrosion and adverse effects on factory applied painted finish.

#### **PART 2 PRODUCTS**

#### 2.01 MANUFACTURERS

- A. Hollow Metal Doors and Frames:
  - 1. Curries, an Assa Abloy Group company: www.assaabloydss.com/#sle.
  - 2. Mesker, dormakaba Group; FDJ Series Drywall Frames: www.meskeropeningsgroup.com/#sle.
  - 3. Steelcraft, an Allegion brand: www.allegion.com/#sle.
  - 4. Substitutions: See Section 01 6000 Product Requirements.

#### 2.02 PERFORMANCE REQUIREMENTS

- A. Requirements for Hollow Metal Doors and Frames:
  - Steel Sheet: Comply with one or more of the following requirements; galvannealed steel complying with ASTM A653/A653M, cold-rolled steel complying with ASTM A1008/A1008M, or hot-rolled pickled and oiled (HRPO) steel complying with ASTM A1011/A1011M, commercial steel (CS) Type B, for each.
  - 2. Accessibility: Comply with ICC A117.1 and ADA Standards.
  - 3. Door Edge Profile: Manufacturers standard for application indicated.
  - 4. Typical Door Face Sheets: Flush.
  - 5. Glazed Lights: Non-removable stops on non-secure side; sizes and configurations as indicated on drawings. Style: Flush.
  - Hardware Preparations, Selections and Locations: Comply with NAAMM HMMA 830 and NAAMM HMMA 831 or BHMA A156.115 and ANSI/SDI A250.8 (SDI-100) in accordance with specified requirements.
- B. Combined Requirements: If a particular door and frame unit is indicated to comply with more than one type of requirement, comply with the specified requirements for each type; for instance, an exterior door that is also indicated as being sound-rated must comply with the requirements specified for exterior doors and for sound-rated doors; where two requirements conflict, comply with the most stringent.

# 2.03 HOLLOW METAL DOORS

- A. Door Finish: Factory primed and field finished.
- B. Fire-Rated Doors:

08 1113 Hollow Metal Doors and Frames

Project No.: 3221 Addendum #004 Page 3

- 1. Based on SDI Standards: ANSI/SDI A250.8 (SDI-100).
  - a. Level 3 Extra Heavy-duty.
  - Physical Performance Level A, 1,000,000 cycles; in accordance with ANSI/SDI A250.4.
  - c. Model 1 Full Flush.
  - d. Door Face Metal Thickness: 18 gauge, 0.042 inch, minimum.
- Fire Rating: As indicated on Door Schedule, tested in accordance with UL 10C and NFPA 252 ("positive pressure fire tests").
- 3. Provide units listed and labeled by UL (DIR) or ITS (DIR).
  - a. Attach fire rating label to each fire rated unit.
- 4. Door Thickness: 1-3/4 inches, nominal.

#### 2.04 HOLLOW METAL FRAMES

- A. Comply with standards and/or custom guidelines as indicated for corresponding door in accordance with applicable door frame requirements.
- B. Frame Finish: Factory primed and field finished.
- C. Interior Door Frames, Non-Fire Rated: Full profile/continuously welded type.
  - 1. Frame Metal Thickness: 16 gauge, 0.053 inch, minimum.
- D. Door Frames, Fire-Rated: Full profile/continuously welded type.
  - 1. Fire Rating: Same as door, labeled.
  - 2. Frame Metal Thickness: 16 gauge, 0.053 inch, minimum.
- E. Mullions for Pairs of Doors: Removable type, with profile similar to jambs.

#### 2.05 FINISHES

A. Primer: Rust-inhibiting, complying with ANSI/SDI A250.10, door manufacturer's standard.

#### 2.06 ACCESSORIES

- A. Glazing: As specified in Section 08 8000, factory installed.
- B. Astragals and Edges for Double Doors: Pairs of door astragals, and door edge sealing and protection devices.
  - 1. UL listed products in compliance with requirements of authorities having jurisdiction.
  - 2. Astragal Type: Overlapping, Z-Shaped for double egress fire doors and with automatic locking and sealing gasket.
  - 3. Material: Steel.
- C. Mechanical Fasteners for Concealed Metal-to-Metal Connections: Self-drilling, self-tapping, steel with electroplated zinc finish.
- D. Silencers: Resilient rubber, fitted into drilled hole; provide three on strike side of single door, three on center mullion of pairs, and two on head of pairs without center mullions.
- E. Temporary Frame Spreaders: Provide for factory- or shop-assembled frames.

#### PART 3 EXECUTION

## 3.01 EXAMINATION

- A. Verify existing conditions before starting work.
- B. Verify that opening sizes and tolerances are acceptable.
- C. Verify that finished walls are in plane to ensure proper door alignment.

## 3.02 INSTALLATION

- A. Install doors and frames in accordance with manufacturer's instructions and related requirements of specified door and frame standards or custom guidelines indicated.
- B. Install fire rated units in accordance with NFPA 80.

Page 4

Project No.: 3221

- C. Coordinate frame anchor placement with wall construction.
- D. Install door hardware as specified in Section 08 7100.
- E. Comply with glazing installation requirements of Section 08 8000.
- F. Coordinate installation of electrical connections to electrical hardware items.
- G. Touch up damaged factory finishes.

## 3.03 TOLERANCES

A. Clearances Between Door and Frame: Comply with related requirements of specified frame standards or custom guidelines indicated in accordance with SDI 117 or NAAMM HMMA 861.

Addendum #004

3. Maximum Diagonal Distortion: 1/16 inch measured with straight edge, corner to corner.

## 3.04 ADJUSTING

A. Adjust for smooth and balanced door movement.

## 3.05 SCHEDULE

A. Refer to Door and Frame Schedule on the drawings.

**END OF SECTION** 

08 7100 Door Hardware Project No.: 3221

Page 1

# SECTION 08 7100 DOOR HARDWARE

#### **PART 1 GENERAL**

#### 1.01 SECTION INCLUDES

- A. Hardware for wood, hollow metal, and FRP doors.
- B. Hardware for fire-rated doors.
- C. Electrically operated and controlled hardware.
- D. Thresholds.
- E. Weatherstripping and gasketing.

## 1.02 RELATED REQUIREMENTS

- A. Section 06 2000 Finish Carpentry: Wood door frames.
- B. Section 07 9200 Joint Sealants: Sealants for setting exterior door thresholds.
- C. Section 08 1113 Hollow Metal Doors and Frames.
- D. Section 08 1416 Flush Wood Doors.
- E. Section 08 1613 Fiberglass Doors.
- F. Section 08 4313 Aluminum-Framed Storefronts: Door hardware, except as noted in section.
- G. Section 28 3100 Fire Alarm

#### 1.03 REFERENCE STANDARDS

- A. ADA Standards Americans with Disabilities Act (ADA) Standards for Accessible Design 2010.
- B. BHMA A156.1 American National Standard for Butts and Hinges 2016.
- C. BHMA A156.2 American National Standard for Bored and Preassembled Locks & Latches 2017.
- D. BHMA A156.3 American National Standard for Exit Devices 2014.
- E. BHMA A156.4 American National Standard for Door Controls Closers 2013.
- F. BHMA A156.6 American National Standard for Architectural Door Trim 2015.
- G. BHMA A156.7 American National Standard for Template Hinge Dimensions 2016.
- H. BHMA A156.8 American National Standard for Door Controls Overhead Stops and Holders 2015.
- BHMA A156.13 American National Standard for Mortise Locks & Latches Series 1000 2017.
- J. BHMA A156.15 American National Standard for Release Devices Closer Holder, Electromagnetic and Electromechanical 2015.
- K. BHMA A156.16 American National Standard for Auxiliary Hardware 2018.
- L. BHMA A156.18 American National Standard for Materials and Finishes 2016.
- M. BHMA A156.21 American National Standard for Thresholds 2014.
- N. BHMA A156.22 American National Standard for Door Gasketing and Edge Seal Systems Sponsor 2017.
- O. BHMA A156.23 American National Standard for Electromagnetic Locks 2017.
- P. BHMA A156.25 American National Standard for Electrified Locking Devices 2018.
- Q. BHMA A156.28 American National Standard for Recommended Practices for Mechanical Keying Systems 2018.
- R. BHMA A156.31 American National Standard for Electric Strikes and Frame Mounted Actuators 2013.

Project No.: 3221 Page 2

08 7100 Door Hardware

- BHMA A156.36 American National Standard for Auxiliary Locks 2016.
- BHMA A156.115 American National Standard for Hardware Preparation in Steel Doors and Steel Frames 2016.
- BHMA A156.115W American National Standard for Hardware Preparation in Wood Doors with Wood or Steel Frames 2006.
- V. DHI (H&S) Sequence and Format for the Hardware Schedule 1996.
- W. DHI (KSN) Keying Systems and Nomenclature 1989.
- X. ICC A117.1 Accessible and Usable Buildings and Facilities 2017.
- Y. ITS (DIR) Directory of Listed Products current edition.
- Z. NFPA 70 National Electrical Code Most Recent Edition Adopted by Authority Having Jurisdiction, Including All Applicable Amendments and Supplements.
- AA. NFPA 80 Standard for Fire Doors and Other Opening Protectives 2019.
- BB. NFPA 105 Standard for Smoke Door Assemblies and Other Opening Protectives 2019.
- CC. NFPA 252 Standard Methods of Fire Tests of Door Assemblies 2017.
- DD. UL (DIR) Online Certifications Directory Current Edition.
- EE. UL 10C Standard for Positive Pressure Fire Tests of Door Assemblies Current Edition, Including All Revisions.

## 1.04 ADMINISTRATIVE REQUIREMENTS

- Coordinate the manufacture, fabrication, and installation of products that door hardware is installed on.
- Sequence installation to ensure utility connections are achieved in an orderly and expeditious manner.
- C. Preinstallation Meeting: Convene a preinstallation meeting one week prior to commencing work of this section; attendance is required by affected installers and the following:
  - 1. Architect.
  - Installer's Architectural Hardware Consultant (AHC). 2.
  - Hardware Installer. 3.
  - Owner's Security Consultant.
- D. Furnish templates for door and frame preparation to manufacturers and fabricators of products requiring internal reinforcement for door hardware.
- Keying Requirements Meeting:
  - Schedule meeting at project site prior to Contractor occupancy. 1.
  - Attendance Required: 2.
    - a. Contractor.
    - b. Owner.
    - c. Architect.
    - d. Installer's Architectural Hardware Consultant (AHC).
    - e. Hardware Installer.
    - Owner's Security Consultant. f.
  - Agenda:
    - a. Establish keying requirements.
    - b. Verify locksets and locking hardware are functionally correct for project requirements.
    - Verify that keying and programming complies with project requirements.
    - Establish keying submittal schedule and update requirements.
  - Incorporate "Keying Requirements Meeting" decisions into keying submittal upon review of door hardware keying system including, but not limited to, the following:
    - Schematic diagram of preliminary key system.

08 7100 Door Hardware Project No.: 3221

Page 3

- b. Flow of traffic and extent of security required.
- 5. Record minutes and distribute copies via e-mail within two days after meeting to participants and to those affected by decisions made.
- 6. Deliver established keying requirements to manufacturers.

## 1.05 SUBMITTALS

- A. See Section 01 3000 Administrative Requirements for submittal procedures.
- B. Product Data: Manufacturer's catalog literature for each type of hardware, marked to clearly show products to be furnished for this project, and includes construction details, material descriptions, finishes, and dimensions and profiles of individual components.
- C. Shop Drawings Door Hardware Schedule: Submit detailed listing that includes each item of hardware to be installed on each door. Use door numbering scheme as included in Contract Documents.
  - Comply with DHI (H&S) using door numbers and hardware set numbers as indicated in construction documents.
  - 2. List groups and suffixes in proper sequence.
  - 3. Provide complete description for each door listed.
  - 4. Provide manufacturer's and product names, and catalog numbers; include functions, types, styles, sizes and finishes of each item.
  - 5. Include account of abbreviations and symbols used in schedule.
- D. Samples for Verification:
  - 1. Submit minimum size of 2 by 4 inch for sheet samples, and minimum length of 4 inch for other products.
  - 2. Submit product description with samples.
- E. Manufacturer's Installation Instructions: Indicate special procedures and perimeter conditions requiring special attention.
- F. Maintenance Data: Include data on operating hardware, lubrication requirements, and inspection procedures related to preventative maintenance.
  - 1. Submit manufacturer's parts lists and templates.
- G. Keying Schedule:
  - Submit one copy of Keying Schedule in compliance with requirements established during Keying Requirements Meeting unless otherwise indicated.
- H. Warranty: Submit manufacturer's warranty and ensure that forms have been completed in Owner's name and registered with manufacturer.
- Project Record Documents: Record actual locations of concealed equipment, services, and conduit.
- J. Maintenance Materials and Tools: Furnish the following for Owner's use in maintenance of project.
  - 1. See Section 01 6000 Product Requirements, for additional provisions.
  - 2. Lock Cylinders: One for each master keyed group.
  - 3. Tools: One set of each special wrench or tool applicable for each different or special hardware component, whether supplied by hardware component manufacturer or not.

# 1.06 QUALITY ASSURANCE

- A. Installer Qualifications: Company specializing in performing work of the type specified for commercial door hardware with at least five years of documented experience.
- B. Supplier Qualifications: Company with certified Architectural Hardware Consultant (AHC) to assist in work of this section.

08 7100 Door Hardware Project No.: 3221

Page 4

# 1.07 DELIVERY, STORAGE, AND HANDLING

A. Package hardware items individually; label and identify each package with door opening code to match door hardware schedule.

## 1.08 WARRANTY

- A. See Section 01 7800 Closeout Submittals for additional warranty requirements.
- Warranty against defects in material and workmanship for period indicated, from Date of Substantial Completion.
  - 1. Closers: Ten years, minimum.
  - 2. Exit Devices: Five years, minimum.
  - 3. Locksets and Cylinders: Three years, minimum.
  - 4. Other Hardware: Two years, minimum.

## **PART 2 PRODUCTS**

## 2.01 DESIGN AND PERFORMANCE CRITERIA

- A. Provide specified door hardware as required to make doors fully functional, compliant with applicable codes, and secure to extent indicated.
- B. Provide individual items of single type, of same model, and by same manufacturer.
- C. Provide door hardware products that comply with the following requirements:
  - 1. Applicable provisions of federal, state, and local codes.
  - 2. Accessibility: ADA Standards and ICC A117.1.
  - 3. Fire-Rated Doors: NFPA 80, listed and labeled by qualified testing agency for fire protection ratings indicated, based on testing at positive pressure in accordance with NFPA 252 or UL 10C.
  - 4. Hardware on Fire-Rated Doors: Listed and classified by UL (DIR), ITS (DIR), or testing firm acceptable to authorities having jurisdiction as suitable for application indicated.
  - 5. Auxiliary Hardware: BHMA A156.16.
  - 6. Hardware Preparation for Steel Doors and Steel Frames: BHMA A156.115.
  - 7. Hardware Preparation for Wood Doors with Wood or Steel Frames: BHMA A156.115W.
  - 8. Products Requiring Electrical Connection: Listed and classified by UL (DIR) as suitable for the purpose specified.
- D. Electrically Operated and/or Controlled Hardware: Provide necessary power supplies, power transfer hinges, relays, and interfaces as required for proper operation; provide wiring between hardware and control components and to building power connection in compliance with NFPA 70.
- E. Lock Function: Provide lock and latch function numbers and descriptions of manufacturer's series. See Door Hardware Schedule on drawings.

#### F. Fasteners:

- 1. Provide fasteners of proper type, size, quantity, and finish that comply with commercially recognized standards for proposed applications.
  - a. Aluminum fasteners are not permitted.
  - b. Provide phillips flat-head screws with heads finished to match door surface hardware unless otherwise indicated.
- 2. Fire-Rated Applications: Comply with NFPA 80.
  - a. Provide wood or machine screws for hinges mortised to doors or frames, strike plates to frames, and closers to doors and frames.
  - b. Provide steel through bolts for attachment of surface mounted closers, hinges, or exit devices to door panels unless proper door blocking is provided.

# 2.02 HINGES

A. Manufacturers:

Project No.: 3221 Page 5 Addendum #004

08 7100 Door Hardware

- Hager Companies; BB1199 5 inch x 5 inch: www.hagerco.com/#sle. 1.
- 2. Substitutions: See Section 01 6000 - Product Requirements.
- Hinges: Comply with BHMA A156.1, Grade 1.
  - Butt Hinges: Comply with BHMA A156.1 and BHMA A156.7 for templated hinges.
    - a. Provide hinge width required to clear surrounding trim.
  - Provide hinges on every swinging door. 2.
  - Provide ball-bearing hinges at each door with closer.
  - Provide non-removable pins on interior outswinging doors.
  - Provide following quantity of butt hinges for each door:
    - Doors From 60 inches High up to 90 inches High: Three hinges.
    - b. Doors 90 inches High up to 120 inches High: Four hinges.

#### 2.03 CONTINUOUS HINGES

- A. Manufacturers:
  - 1. Ives, an Allegion brand; XY Series TWPCON: www.allegion.com/us/#sle.
  - Substitutions: See Section01 6000-Product Requirements.
- Continuous Hinges: Comply with BHMA A156.26.
  - Provide continuous hinges on every exterior door.
  - 2. Provide power transfer hinges where electrified hardware is mounted in door leaf.

# 2.04 FLUSH BOLTS

- A. Manufacturers:
  - Rockwood; an Assa Abloy Group company; Product #555: www.assaabloydss.com/#sle.
  - Substitutions: See Section 01 6000 Product Requirements.
- Flush Bolts: Comply with BHMA A156.16, Grade 1.
  - Flush Bolt Throw: 3/4 inch, minimum.
  - 2. Provides extension bolts in leading edge of door, one bolt into floor, one bolt into top of frame.
    - Pairs of Swing Doors: At inactive leaves, provide flush bolts of type as required to comply with code.

## 2.05 EXIT DEVICES

- A. Manufacturers:
  - Von Duprin, an Allegion brand; Series 99 QEL,RX,NL,TL: www.allegion.com/us/#sle.
  - Substitutions: See Section 01 6000 Product Requirements.
- В. Exit Devices: Comply with BHMA A156.3, Grade 1.
  - Lever design to match lockset trim. 1.
  - Provide cylinder with cylinder dogging or locking trim.
  - Provide exit devices properly sized for door width and height. 3.
  - Provide strike as recommended by manufacturer for application indicated. 4.
  - Provide UL (DIR) listed exit device assemblies for fire-rated doors and panic device assemblies for non-fire-rated doors.
  - 6. For electrical options, provide quick connect plug-in pre-wired connectors.

# 2.06 ELECTRIC STRIKES

- Manufacturers:
  - HES; an Assa Abloy Group company; Series 1500/1600: www.assaabloydss.com/#sle.
  - Substitutions: See Section 01 6000 Product Requirements.
- Electric Strikes: Comply with BHMA A156.31, Grade 1.
  - Provide UL (DIR) listed burglary-resistant electric strike; style to suit locks.
  - Provide non-handed 24 VDC electric strike suitable for door frame material and scheduled lock configuration.

08 7100 Door Hardware Project No.: 3221

Page 6

- 3. Provide field selectable Fail Safe/Fail Secure modes.
- 4. Provide transformer and rectifier as necessary for complete installation.

## 2.07 ELECTROMAGNETIC LOCKS

- A. Manufacturers:
  - 1. Securitron; an Assa Abloy Group company: www.assaabloydss.com/#sle.
  - 2. Substitutions: See Section 01 6000 Product Requirements.
- B. Electromagnetic Locks: Comply with BHMA A156.23, Grade 1.
  - 1. Holding Force: 600 lbs, minimum.
  - 2. Voltage: 12 VDC, and provide power supplies by same manufacturer as locks.
  - 3. Provide electromagnetic locks for fire-rated doors in compliance with UL 10C.
  - 4. Mounting: Surface mounted to door and frame on secure side, with fasteners, brackets, and spacer bars as required for application.
  - 5. Provide concealed adjustable time delay option to re-lock door, adjustable from 1 to 90 seconds.

## 2.08 LOCK CYLINDERS

- A. Manufacturers:
  - 1. Schlage; an Allegion company; IE72: us.allegion.com.
- B. Lock Cylinders: Provide key access on outside of each lock, unless otherwise indicated.
  - 1. Provide cylinders from same manufacturer as locking device.

## 2.09 MORTISE LOCKS

- A. Manufacturers:
  - Basis of Design: Schlage, an Allegion brand; L9050BDC 07A L283-711: www.allegion.com/us/#sle.
  - 2. Corbin Russwin, Sargent, or Yale; an Assa Abloy Group company: www.assaabloydss.com/#sle.
  - 3. Best, dormakaba Group: www.bestaccess.com/#sle.
- B. Mortise Locks: Comply with BHMA A156.13, Grade 1, Security, 1000 Series.
  - 1. Latchbolt Throw: 3/4 inch, minimum.
  - 2. Deadbolt Throw: 1 inch, minimum.
  - 3. Backset: 2-3/4 inch unless otherwise indicated.
  - 4. Strikes: Provide manufacturer's standard strike for each latchset or lockset with strike box and curved lip extending to protect frame in compliance with indicated requirements.
    - a. Finish: To match lock or latch.

# 2.10 AUXILIARY LOCKS (DEADLOCKS)

- A. Manufacturers:
  - 1. Basis of Design: Schlage; an Allegion company; L463BDC: us.allegion.com.
  - 2. Yale; an Assa Abloy Group company: www.assaabloydss.com/#sle.
  - 3. Best, dormakaba Group: www.bestaccess.com/#sle.
- B. Auxiliary Locks (Deadlocks): Comply with BHMA A156.36, Grade 1.
  - 1. Type: Mortise.
  - 2. Application: Mortised.
  - 3. Backset: 2-3/4 inch, unless otherwise indicated.
  - 4. Bolt Throw: 1/2 inch. with latch made of hardened steel.
  - Provide strike that matches frame.

#### 2.11 DOOR PULLS AND PUSH PLATES

- A. Manufacturers:
  - 1. Rockwood; an Assa Abloy Group company; 110X73C/73CL: www.assaabloydss.com/#sle.

08 7100 Door Hardware Project No.: 3221

Page 7

- 2. Substitutions: See Section 01 6000 Product Requirements.
- B. Door Pulls and Push Plates: Comply with BHMA A156.6.
  - 1. Pull Type: Straight, unless otherwise indicated.
  - 2. Push Plate Type: Flat, with square corners, unless otherwise indicated.
    - a. Edges: Beveled, unless otherwise indicated.
  - 3. Material: Stainless steel, unless otherwise indicated.

# 2.12 COORDINATORS

- A. Manufacturers:
  - 1. Rockwood; an Assa Abloy Group company: www.assaabloydss.com/#sle.
  - 2. Substitutions: See Section 01 6000 Product Requirements.
- B. Coordinators: Provide on doors having closers and self-latching or automatic flush bolts to ensure that inactive door leaf closes before active door leaf.
  - 1. Type: Bar, unless otherwise indicated.
  - 2. Material: Aluminum, unless otherwise indicated.
  - 3. Ensure that coordination of other door hardware affected by placement of coordinators and carry bar is applied properly for completely operable installation.

#### 2.13 CLOSERS

- A. Manufacturers; Surface Mounted:
  - 1. Basis of Design: LCN, an Allegion brand; Series 4100: www.allegion.com/us/#sle.
- B. Closers: Comply with BHMA A156.4, Grade 1.
  - 1. Type: Surface mounted to door.
  - 2. Provide hold open feature and limit stop where indicated on door schedule.
  - 3. Provide door closer on each fire-rated and smoke-rated door.
  - 4. Where an overlapping astragal is included on pairs of swinging doors, provide coordinator to ensure door leaves close in proper order.
  - 5. At corridor entry doors, mount closer on room side of door.

## 2.14 OVERHEAD STOPS AND HOLDERS

- A. Manufacturers:
  - 1. Glynn-Johnson, an Allegion brand; 450 Series: www.allegion.com/us/#sle.
  - 2. Substitutions: See Section 01 6000 Product Requirements.
- B. Overhead Stops and Holders (Door Checks): Comply with BHMA A156.8, Grade 1.
  - 1. Provide stop for every swinging door, unless otherwise indicated.

#### 2.15 KICK PLATES

- A. Manufacturers:
  - 1. Rockwood; an Assa Abloy Group company; Product #1050: www.assaabloydss.com/#sle..
  - 2. Substitutions: See Section 01 6000 Product Requirements.
- B. Kick Plates: Provide along bottom edge of push side of every door with closer, except aluminum storefront and glass entry doors, unless otherwise indicated.
  - 1. Size: 10 inch high by 2 inch less door width (LDW) on push side of door.

# 2.16 ELECTROMAGNETIC DOOR HOLDERS

- A. Manufacturers:
  - 1. Rixson or Sargent; an Assa Abloy Group company: www.assaabloydss.com/#sle.
  - 2. Substitutions: See Section 01 6000 Product Requirements.
- B. Electromagnetic Door Holders: Comply with BHMA A156.15.
  - 1. Type: Wall mounted, single unit, heavy duty, with strike plate attached to door.
  - 2. Holding Force, Heavy Duty: 300 lbs-force, minimum.

08 7100 Door Hardware Project No.: 3221

Page 8

- 3. Voltage: 12 VDC, and provide power supplies by same manufacturer as holders.
- 4. Fail safe; door released to close automatically when electrical current is interrupted.
- 5. Provide interface with fire detectors and fire-alarm system for fire-rated door assemblies.

## 2.17 WALL STOPS

- A. Manufacturers:
  - 1. Rockwood; an Assa Abloy Group company; 403: www.assaabloydss.com/#sle.
  - 2. Substitutions: See Section 01 6000 Product Requirements.
- B. Wall Stops: Comply with BHMA A156.16, Grade 1 and Resilient Material Retention Test as described in this standard.
  - 1. Provide wall stops to prevent damage to wall surface upon opening door.
  - 2. Type: Bumper, concave, wall stop.
  - 3. Material: Aluminum housing with rubber insert.

## 2.18 THRESHOLDS

- A. Manufacturers:
  - 1. National Guard Products, Inc; 426: www.ngpinc.com/#sle.
  - 2. Substitutions: See Section 01 6000 Product Requirements.
- B. Thresholds: Comply with BHMA A156.21.
  - 1. Provide threshold at each exterior door, unless otherwise indicated.
  - 2. Type: Flat surface.
  - 3. Material: Aluminum.
  - 4. Threshold Surface: Fluted horizontal grooves across full width.
  - 5. Field cut threshold to profile of frame and width of door sill for tight fit.
  - 6. Provide non-corroding fasteners at exterior locations.

## 2.19 WEATHERSTRIPPING

- A. Manufacturers:
  - 1. National Guard Products, Inc; 170NDKB: www.ngpinc.com/#sle.
  - 2. Substitutions: See Section 01 6000 Product Requirements.
- B. Weatherstripping: Comply with BHMA A156.22.
  - 1. Head and Jamb Type: Self-adhesive.
  - 2. Door Sweep Type: Encased in retainer.
  - 3. Material: Aluminum, with neoprene weatherstripping.
  - Provide weatherstripping on each exterior door at head, jambs, unless otherwise indicated: .
  - 5. Provide door bottom sweep on each exterior door, unless otherwise indicated.

# 2.20 GASKETING

- A. Manufacturers:
  - 1. National Guard Products, Inc; 2525B: www.ngpinc.com/#sle.
  - 2. Substitutions: See Section01 6000-Product Requirements.
- B. Gasketing: Comply with BHMA A156.22.
  - 1. Head and Jamb Type: Self-adhesive.
  - 2. Material: Silicone Bulb.
  - 3. Provide gasketing for smoke control doors, as indicated on drawings, that complies with local codes, requirements of assemblies tested in accordance with UL 1784.

# 2.21 SILENCERS

- A. Manufacturers:
  - Rockwood; an Assa Abloy Group company: www.assaabloydss.com/#sle.
  - 2. Substitutions: See Section 01 6000 Product Requirements.

08 7100 Door Hardware Project No.: 3221

Page 9

- B. Silencers: Provide at equal locations on door frame to mute sound of door's impact upon closing.
  - 1. Single Door: Provide three on strike jamb of frame.
  - 2. Pair of Doors: Provide two on head of frame, one for each door at latch side.
  - 3. Material: Rubber, gray color.

## 2.22 EXIT MOTION SENSOR

- A. Manufacturers:
  - 1. Securitron; an Assa Abloy Group company: www.assaabloydss.com/#sle.
  - 2. Substitutions: See Section 01 6000 Product Requirements.
- B. Exit Motion Sensor: Interior passive infrared detection device to initiate door release of exit door magnetic lock.
  - 1. Power: 12 VDC.
  - 2. Provide adjustable detector face to allow for precise pattern configurations, and easy pattern adjustment.
  - 3. Provide relay that operates before transistor to prevent false alarms.
  - 4. Operating Temperature: 32 to 110 degrees F.

## 2.23 POWER SUPPLY

- A. Power Supply: Hard wired, with multiple zones providing eight (8) breakers for each output panel with individual control switches and LED's; UL (DIR) Class 2 listed.
  - 1. Power: 24 VAC, 10 Amp; with 120 VAC power supply.
  - 2. Operating Temperature: 32 to 110 degrees F.
  - 3. Provide with emergency release terminals that release devices upon activation of fire alarm system.

## 2.24 FINISHES

- A. Finishes: Provide door hardware of same finish, unless otherwise indicated.
  - Primary Finish: 626; satin chromium plated over nickel, with brass or bronze base material (former US equivalent US26D); BHMA A156.18.
  - 2. Exceptions:
    - a. Where base material metal is specified to be different, provide finish that is an equivalent appearance in accordance with BHMA A156.18.
    - b. Hinges for Fire-Rated Doors: Steel base material with plated finish, in compliance with NFPA 80.
    - c. Door Closer Covers and Arms: Color as selected by Architect from manufacturer's standard colors unless otherwise indicated.
    - d. Aluminum Surface Trim and Gasket Housings: Anodized to match door panel finish, not other hardware, unless otherwise indicated.

## **PART 3 EXECUTION**

# 3.01 EXAMINATION

- A. Verify that doors and frames are ready to receive this work; labeled, fire-rated doors and frames are properly installed, and dimensions are as indicated on shop drawings.
- B. Verify that electric power is available to power operated devices and of correct characteristics.

#### 3.02 INSTALLATION

- A. Install hardware in accordance with manufacturer's instructions and applicable codes.
- B. Install hardware on fire-rated doors and frames in accordance with applicable codes and NFPA 80.
- C. Use templates provided by hardware item manufacturer.
- D. Door Hardware Mounting Heights: Distance from finished floor to center line of hardware item. As indicated in following list; unless noted otherwise in Door Hardware Schedule or on

08 7100 Door Hardware Project No.: 3221

Page 10

#### drawings.

- 1. For Steel Doors and Frames: See Section 08 1113.
- 2. For Aluminum-Framed Storefront Doors and Frames: See Section 08 4313.
- 3. Flush Wood Doors: See Section 08 1416.
- 4. Mounting heights in compliance with ADA Standards:
  - a. Push Plates/Pull Bars: 42 inch.
  - b. Deadlocks (Deadbolts): 48 inch.
- E. Set exterior door thresholds with full-width bead of elastomeric sealant at each point of contact with floor providing a continuous weather seal; anchor thresholds with stainless steel countersunk screws.

# 3.03 ADJUSTING

- A. Adjust work under provisions of Section 01 7000 Execution and Closeout Requirements.
- B. Adjust hardware for smooth operation.
- C. Adjust gasketing for complete, continuous seal; replace if unable to make complete seal.

#### 3.04 CLEANING

- A. Clean finished hardware in accordance with manufacturer's written instructions after final adjustments have been made.
- B. Clean adjacent surfaces soiled by hardware installation.
- C. Replace items that cannot be cleaned to manufacturer's level of finish quality at no additional cost.
- D. See Section 01 7419 Construction Waste Management and Disposal for additional requirements.

#### 3.05 PROTECTION

- A. Protect finished Work under provisions of Section 01 7000 Execution and Closeout Requirements.
- B. Do not permit adjacent work to damage hardware or finish.

## **END OF SECTION**